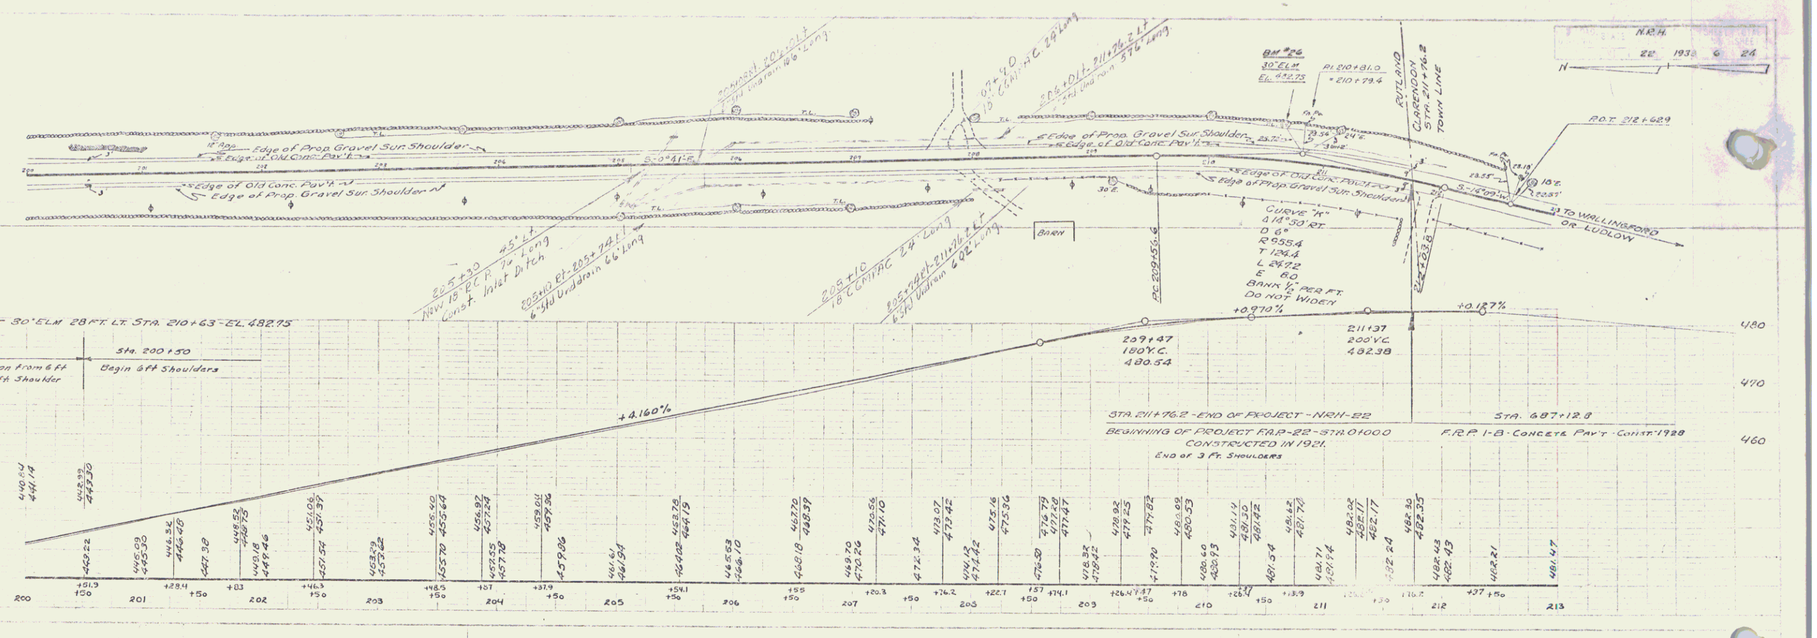

Series No. NRH-22
Sheet 6 of 26

4