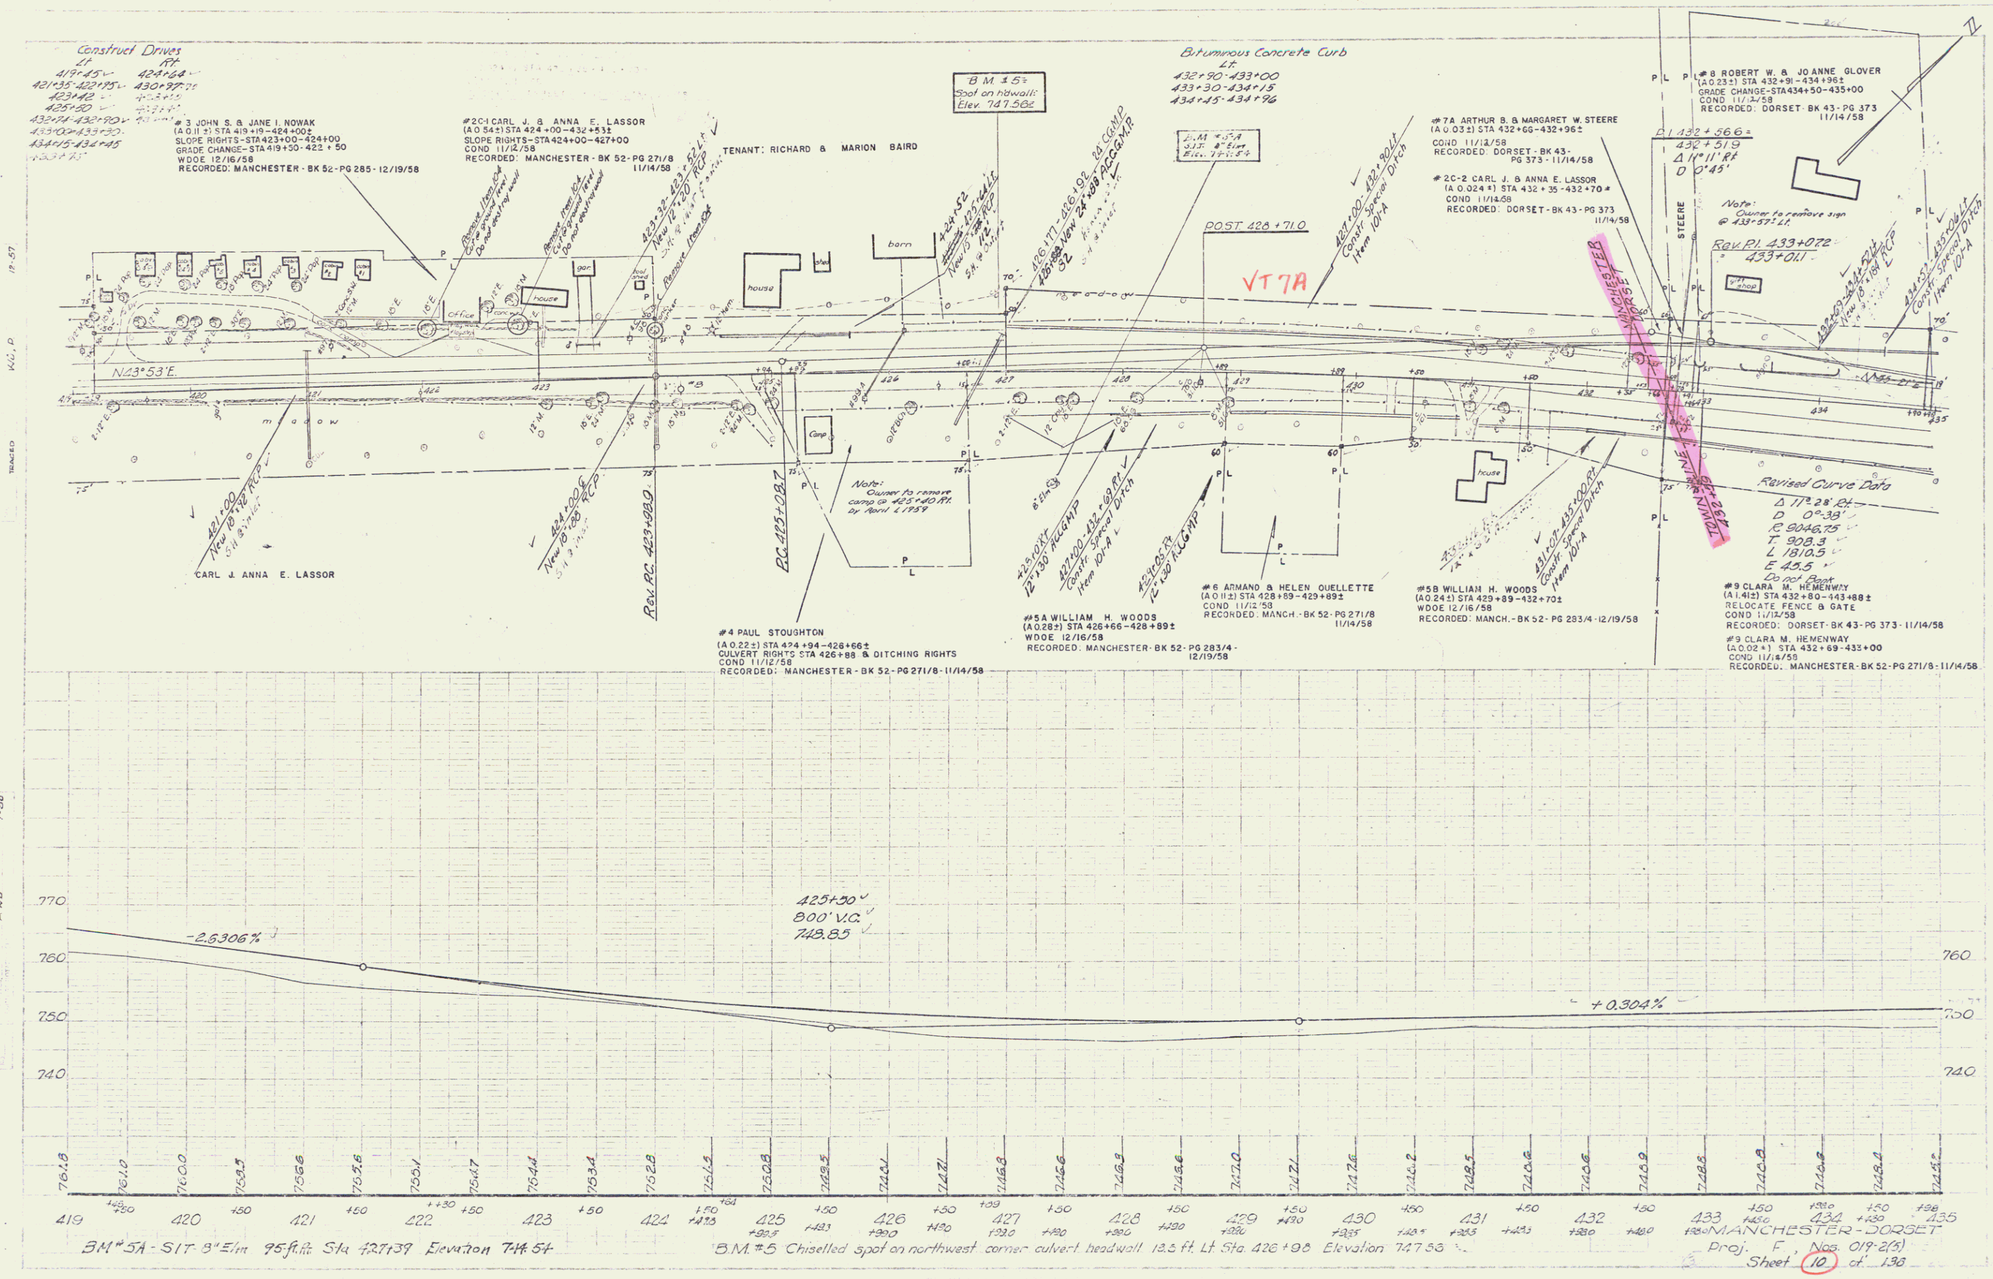
Construct Drives
Lt. 419+45 421+35-421+95 423+42 425+50 432+24-432+90 433+00-433+30 434+15-434+45
Rt. 424+64 430+97
#3 JOHN S. & JANE I. NOWAK
(A 0.11 ±) STA 419+19-424+00±
SLOPE RIGHTS - STA 423+00-424+00
GRADE CHANGE - STA 419+50-422+50
WDOE 12/16/58
RECORDED: MANCHESTER - BK 52 - PG 285 - 12/19/58
#2C-1 CARL J. & ANNA E. LASSOR
(A 0.54 ±) STA 424+00-432+53±
SLOPE RIGHTS - STA 424+00-427+00
COND 11/12/58
RECORDED: MANCHESTER - BK 52 - PG 271/8 11/14/58
TENANT: RICHARD & MARION BAIRD
B.M. #5A
Spot on headwall
Elev. 747.56±
Bituminous Concrete Curb
Lt.
432+90-433+00
433+30-434+15
434+45-434+96
POST 428+71.0
VT 7A
#7A ARTHUR B. & MARGARET W. STEERE
(A 0.03 ±) STA 432+66-432+96±
COND 11/12/58
RECORDED: DORSET - BK 43 - PG 373 - 11/14/58
#2C-2 CARL J. & ANNA E. LASSOR
(A 0.024 ±) STA 432+35-432+70±
COND 11/12/58
RECORDED: DORSET - BK 43 - PG 373 11/14/58
#8 ROBERT W. & JO ANNE GLOVER
(A 0.23 ±) STA 432+91-434+96±
GRADE CHANGE - STA 434+50-435+00
COND 11/12/58
RECORDED: DORSET - BK 43 - PG 373 11/14/58
P.I. 432+56.6
430+51.9
Δ 1°11' Rt
D 0°45'
Note: Owner to remove sign @ 433+57 Lt.
Rev. P.I. 433+07.2
433+01.1
Revised Curve Data
Δ 17°28' Rt
D 0°39'
R 9046.75
T 908.3
L 1810.5
E 45.5
Do not Post
#9 CLARA M. HEMENWAY
(A 1.41 ±) STA 432+80-443+88±
RELOCATE FENCE & GATE
COND 11/12/58
RECORDED: DORSET - BK 43 - PG 373 - 11/14/58
#9 CLARA M. HEMENWAY
(A 0.02 ±) STA 432+69-433+00
COND 11/12/58
RECORDED: MANCHESTER - BK 52 - PG 271/8 - 11/14/58
#4 PAUL STOUGHTON
(A 0.22 ±) STA 424+94-428+66±
CULVERT RIGHTS STA 426+88 & DITCHING RIGHTS
COND 11/12/58
RECORDED: MANCHESTER - BK 52 - PG 271/8 - 11/14/58
#5A WILLIAM H. WOODS
(A 0.28 ±) STA 426+66-428+89±
WDOE 12/16/58
RECORDED: MANCHESTER - BK 52 - PG 283/4 - 12/19/58
#6 ARMAND & HELEN OUELLETTE
(A 0.11 ±) STA 428+89-429+89±
COND 11/12/58
RECORDED: MANCH. - BK 52 - PG 271/8 11/14/58
#5B WILLIAM H. WOODS
(A 0.24 ±) STA 429+89-432+70±
WDOE 12/16/58
RECORDED: MANCH. - BK 52 - PG 283/4 - 12/19/58
CARL J. ANNA E. LASSOR
Rev. P.C. 423+98.0
P.C. 423+08.7
Note: Owner to remove camp @ 423+40 Rt. by April 1, 1959
N 43°53' E.
MANCHESTER
DORSET
TOWN LINE
house
barn
office
garage
shop
camp
culvert
meadow
425+50
800' V.C.
748.85
-2.6306%
+0.304%
770
760
750
740
761.0
761.0
760.0
759.5
419 420 421 422 423 424 425 426 427 428 429 430 431 432 433 434 435
BM #5A - SIT 8" Elm 95 ft. Rt. Sta 427+39 Elevation 744.54
B.M. #5 Chiselled spot on northwest corner culvert headwall 13.5 ft. Lt. Sta. 426+98 Elevation 747.56
MANCHESTER - DORSET
Proj. F. Nos. 019-2(5)
Sheet 10 of 136

4