FED. ROAD DIST. NO.	STATE	FED. AID PROJ. NO.	FISCAL YEAR	SHEET NO.	TO
9	VT	12	19[illegible]-[illegible]	3	1[illegible]

GUARD RAIL REQUIRED

~~Sta 7+88~~ 6+57 LH ON LEFT
Sta ~~7+88~~ 6+57 to Sta ~~8+12~~ 6+81 Length ~~24~~ ft.

~~5+38~~ 9+50 ON RIGHT
Sta ~~5+38~~ 9+50 to Sta ~~5+62~~ 10+88 Length ~~24~~ 138 ft.
" ~~9+50~~ " " ~~10+88~~ " ~~138~~ ft.

TOTAL THIS SHEET ~~186~~ ft.
186

NEW CULVERTS REQUIRED

6+57 LH
Sta ~~8+00~~ 10" Cor Iron Pipe ~~24~~ 23 ft.
1:2:4 Concrete for headwalls 10 cu yds

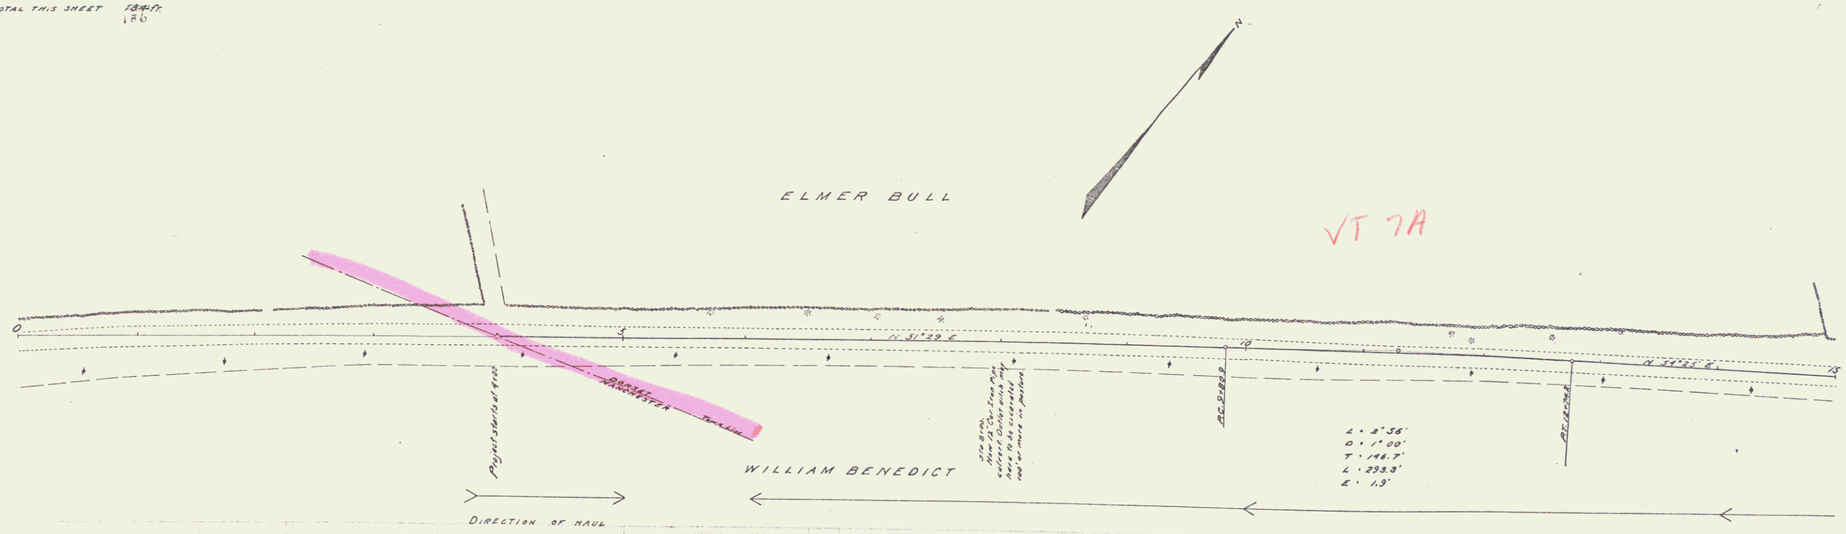

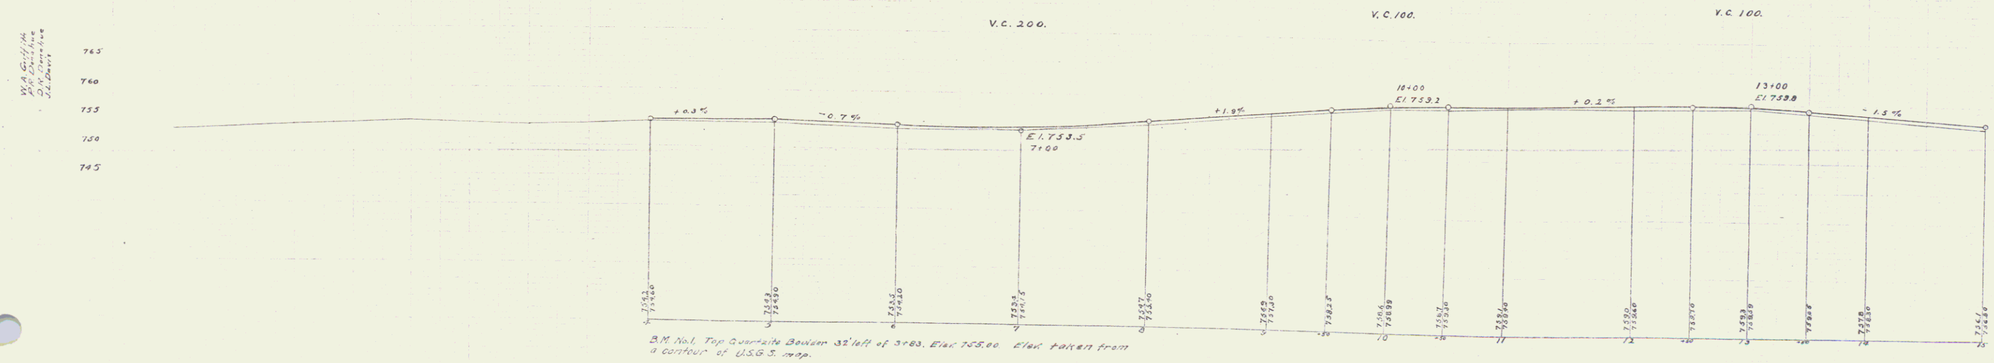

B.M. No.1. Top Quartzite Boulder 32' left of 3+83. Elev. 755.00. Elev. taken from a contour of USGS map.
B.M. Spike in Cherry left of 13+12. Elev. 752.15

Series F. Sheet No. 3 Filed Sept. 1933

2