FED ROAD DIST. No.	STATE	FED AID PROJ. No.	FISCAL YEAR	SHEET No.	TOTAL SHEETS
8	VT	12	1949-50	7	133

GUARD RAIL REQUIRED

ON LEFT



			108

TOTAL THIS SHEET 270 ft.

ON RIGHT

65+70	" " 65+87		17
66+00	" " 67+55		155
66+65	" " 67+43		78

ON LEFT

65+90	" " 65+99		9

Total This Sheet 659

STONE BASE REQUIRED

5" Eq. Pl.

Sta 62+50	to Sta 65+00	Length	300 ft.
" 66+66	" " 70+00	"	334 "

TOTAL THIS SHEET 634 ft.

65+50 –	65+85	300
15+97 –	66+50	53

Total 7791.8

NEW CULVERTS REQUIRED

11+87

Sta 70+00 12" Cor. Iron Pipe 28 ft.

Concrete Headwalls 12.4 1.00 yds.

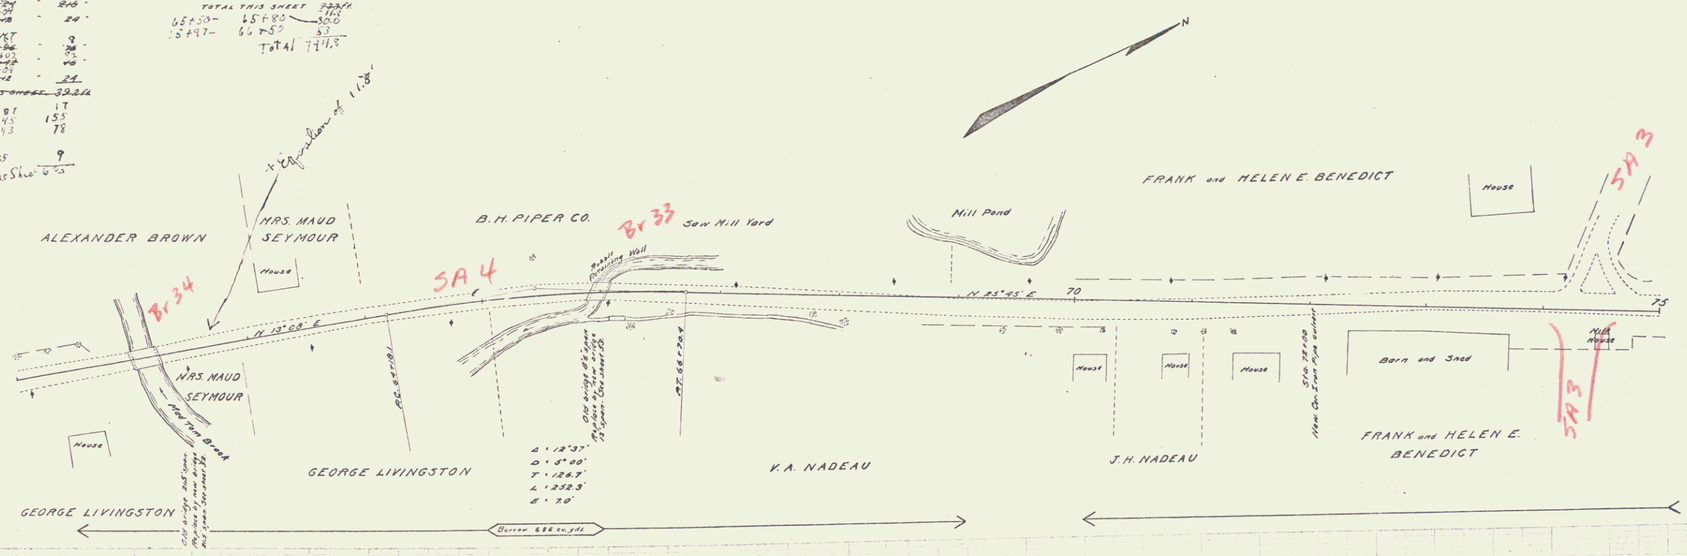

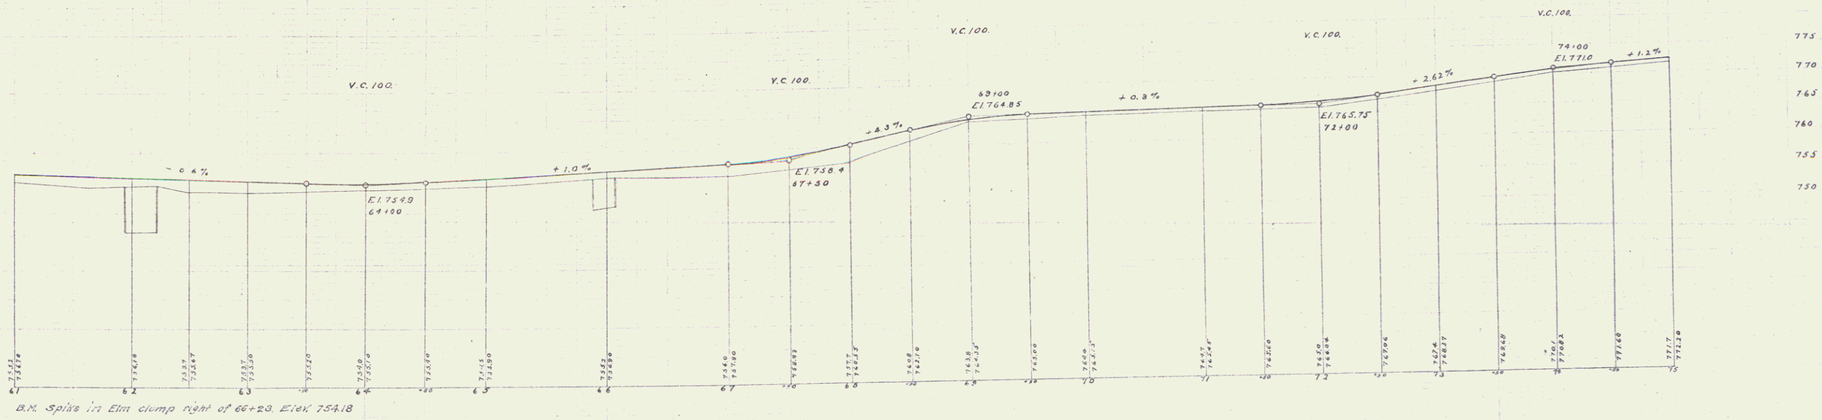

B.M. Spike in Elm clump right of 66+28. Elev. 754.18

B.M. Marble Post N. of gate left of 73+77. Elev. 771.00

Series F. Nat'l. Fed'l. Sheet 7 of 133

6