FED. ROAD DIST. NO.	STATE	FED. AID PROJ. NO.	FISCAL YEAR	SHEET NO.	TOTAL SHEETS
8	VT.	12	19 20	18	133

GUARD RAIL REQUIRED
ON LEFT

~~Sheet 17 Sta. 250+00 Left Length 200 ft~~				
" 250+00	22'	" 253+22	"	312 "
" 250+00	22'	" 253+22	"	312 "
" 250+00	22'	" 253+22	"	312 "
TOTAL THIS SHEET				~~730 ft~~ 936

LEACHING BASIN REQUIRED
~~ON LINE NO.~~

~~Station Sta. 250+00 Rt.~~

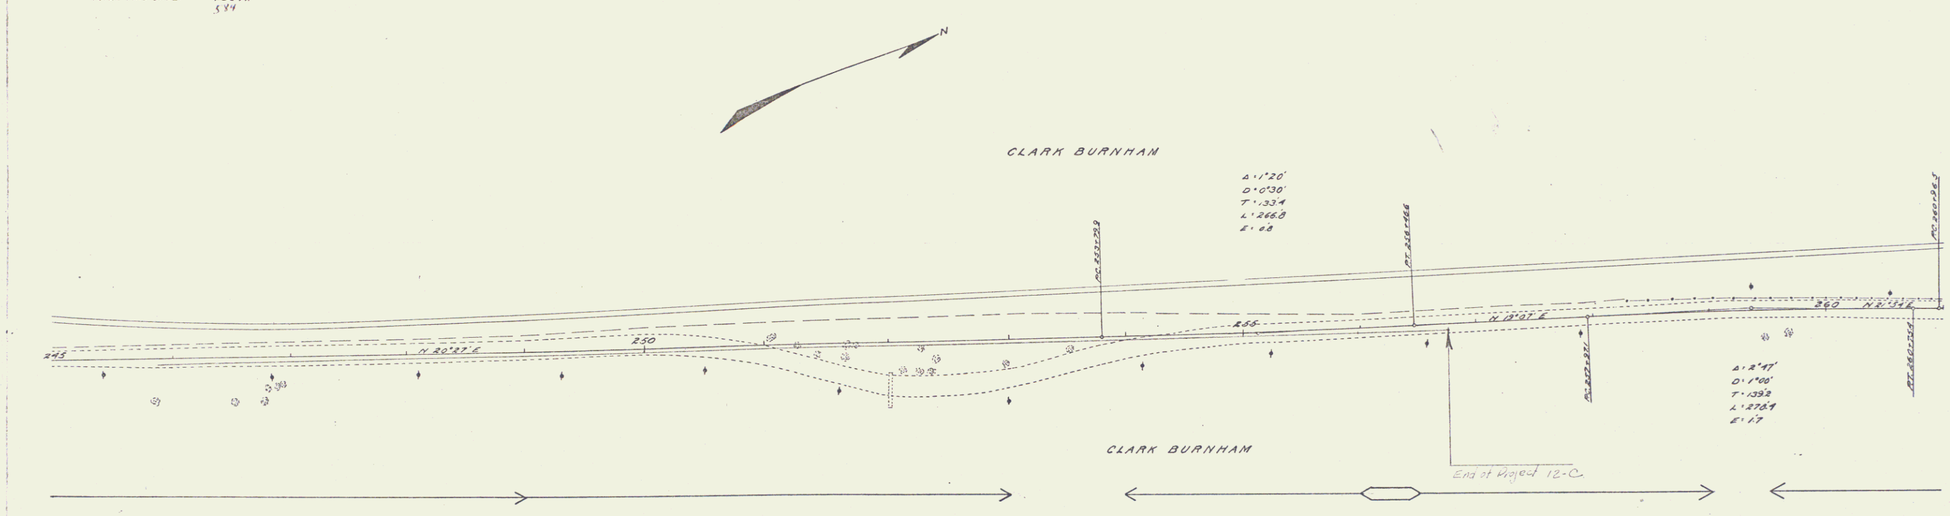

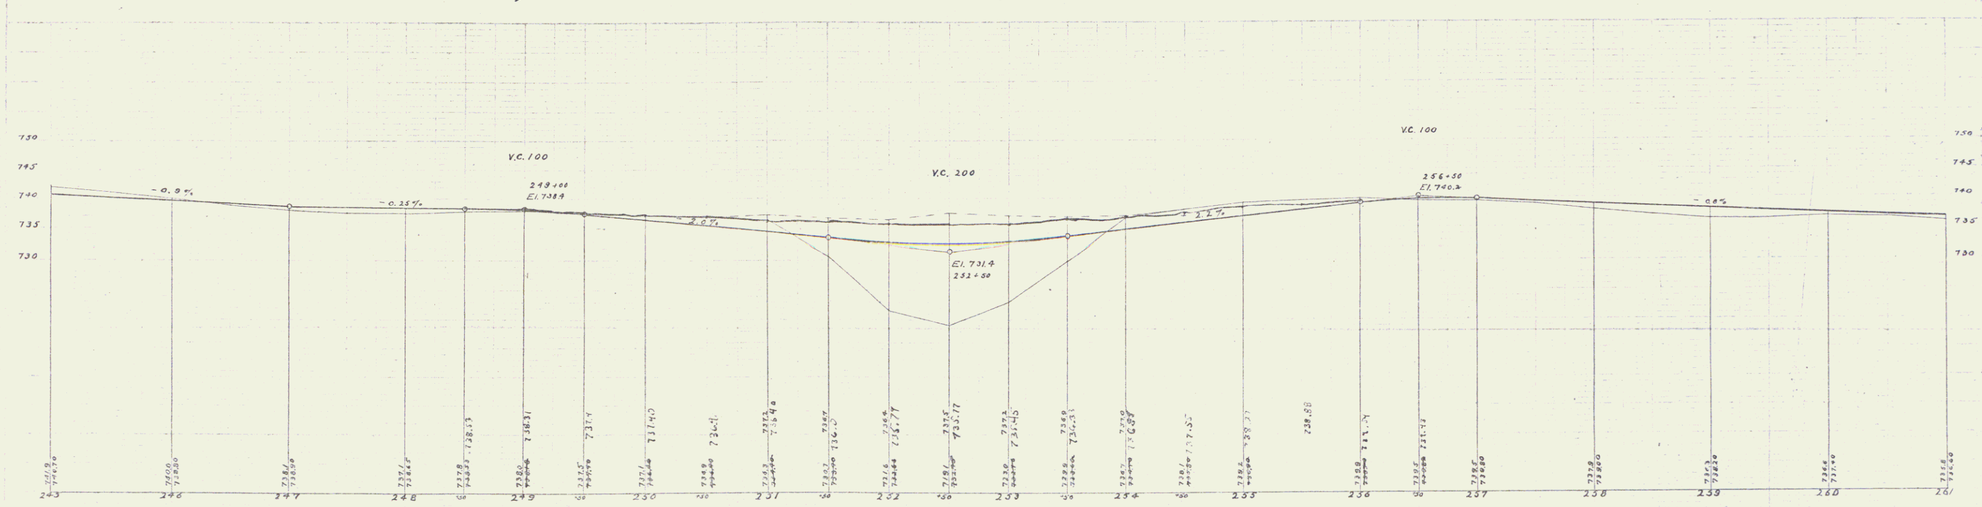

18