INDEX OF SHEETS

SHEET NO.
1. Title Page
2-3. Typical Cross Sections of Improvement (3" Bit.Conc.Pav't. Item 961-8 Mod.)
4-5. Profile to Sheet (Items)
6. Profile to Sheet (Drainage)
7-8. Substructure
9-10. S. Profile
11. E-1 Grubbing & Blasting
12. E-2 Banking Tables
13. E-3 Slope Grading
14. E-6 Muck Excavation
15. E-14 Traffic Islands
16. C-1 Curbs
17. C-1A Precast Concrete Curbs
18. C-2 Drive Entrances
19. D-2 C.R.M.
20. D-3 Gutters
21. D-4 Parking Bays
22. D-5 Concrete D.I.'s
23. D-6 Inlet Details
24. D-7 D.I. Grates
25. D-16 Precast Curb D.I.
27. E-1 Barricades, Signs & Lights
28. E-2 Identification Sign
29. G-1 Steel Beam Guard Rail
30. G-3 Three Cable Guard Rail
31. J-4 Marker Posts
32. J-1 Project Markers
33-52. Borings for F-220 on Sts. 264
53. SCB-1-62
54-62. SCB-01,02,03,04,05,06,07,08,09,-62
63-64. SB-55-62 Sheets 1 and 2 of 2
65. SC-62
66. M-1A Metal Bin
67. M-1C Metal Bin
68-71. Details of Conc. Box at 185+00
72. Details of Plate Pipe on "B" Line
73-81. Mainline Cross Sections 82-95
82-94. A-Line Cross Sections
95-96. B-Line Cross Sections
96-100. BR 281-294 Cross Sections
101-A B-10 EMBANKMENT ON A SL
102-A B-11 SLOPE STABILIZATION

STATE OF VERMONT
DEPARTMENT OF HIGHWAYS

PROPOSED IMPROVEMENT

FEDERAL AID PROJECT

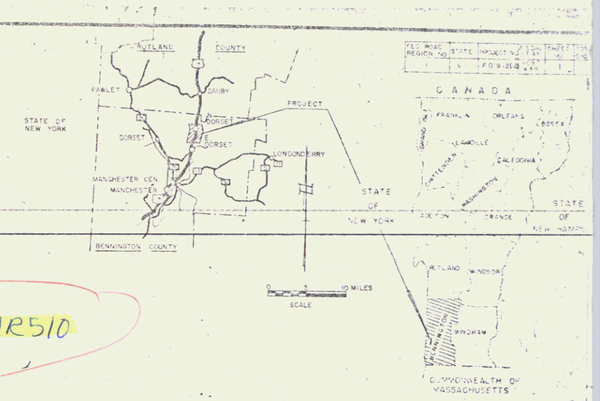

FED. ROAD REGION NO.	STATE	PROJECT NO.	SHEET NO.	TOTAL SHEETS
1	VT	F 019-2(12)	1	1

TOWN OF DORSET
COUNTY OF BENNINGTON
U.S. ROUTE #7
MANCHESTER – DANBY ROAD

Pin # 99R510

BEGINNING AT A POINT APPROXIMATELY 4.923 MILES NORTH OF THE DORSET-MANCHESTER TOWN LINE AND EXTENDING NORTHERLY .044 MILES INCLUDING BRIDGES.

LENGTH OF ROADWAY [illegible] FEET = .044 MILES
LENGTH OF BRIDGES [illegible] FEET = .043 MILE
LENGTH OF CONTRACT [illegible] FEET = 0.44 MILES

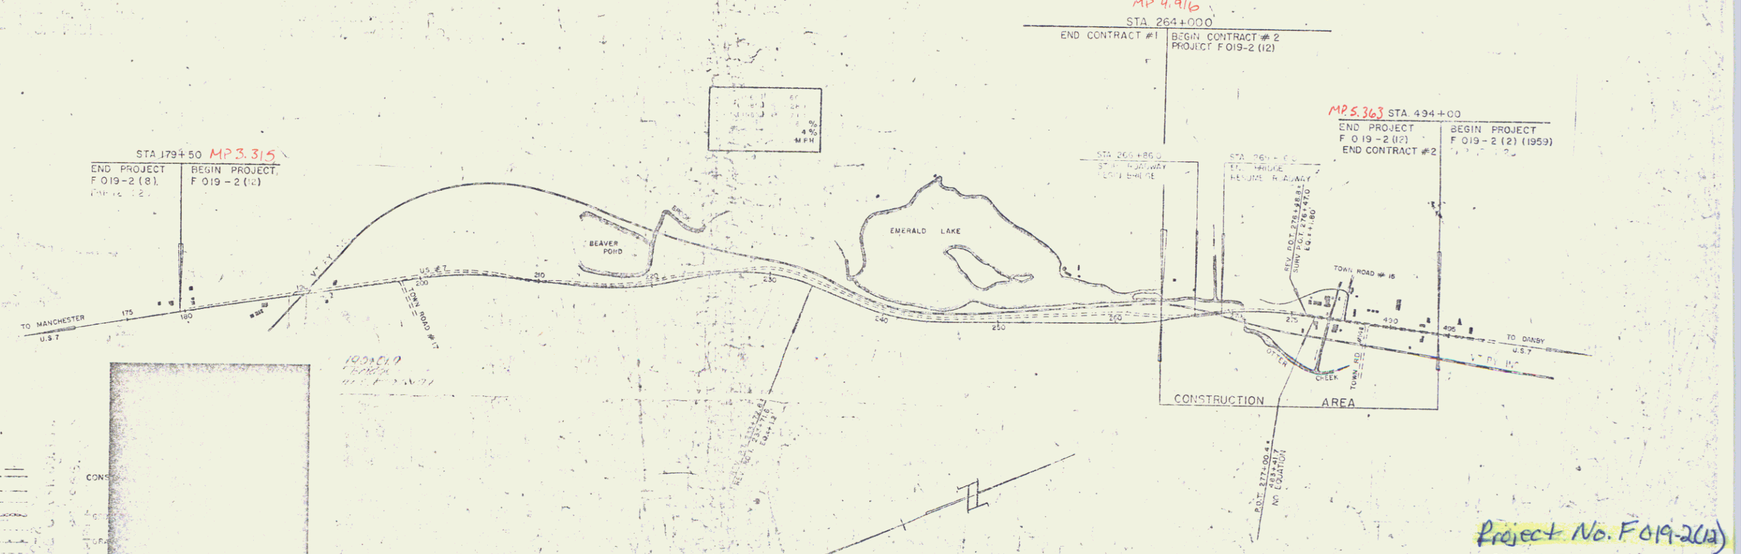

THESE PLANS ARE SUBJECT TO SUCH REVISIONS AS MAY BE REQUIRED BY THE BUREAU OF PUBLIC ROADS OR THE COMMISSIONER OF HIGHWAYS.

CONSTRUCTION IS TO BE CARRIED ON IN ACCORDANCE WITH THE PLANS AND THE STANDARD SPECIFICATIONS FOR HIGHWAY AND BRIDGE CONSTRUCTION OF VERMONT, AS ADOPTED BY THE BUREAU OF PUBLIC ROADS AS APPLICABLE, SUBJECT TO THE ADDITIONS, ALL AMENDMENTS THERETO, REVISIONS THEREUNDER, SPECIAL PROVISIONS AND SPECIAL PROVISIONS AS MAY BE SUBMITTED WITH THIS PLANS.

Project No. F019-2(12)
CONTRACT NO. 2

DEPARTMENT OF COMMERCE
BUREAU OF PUBLIC ROADS

6/24/60

F 019-2(12)

1