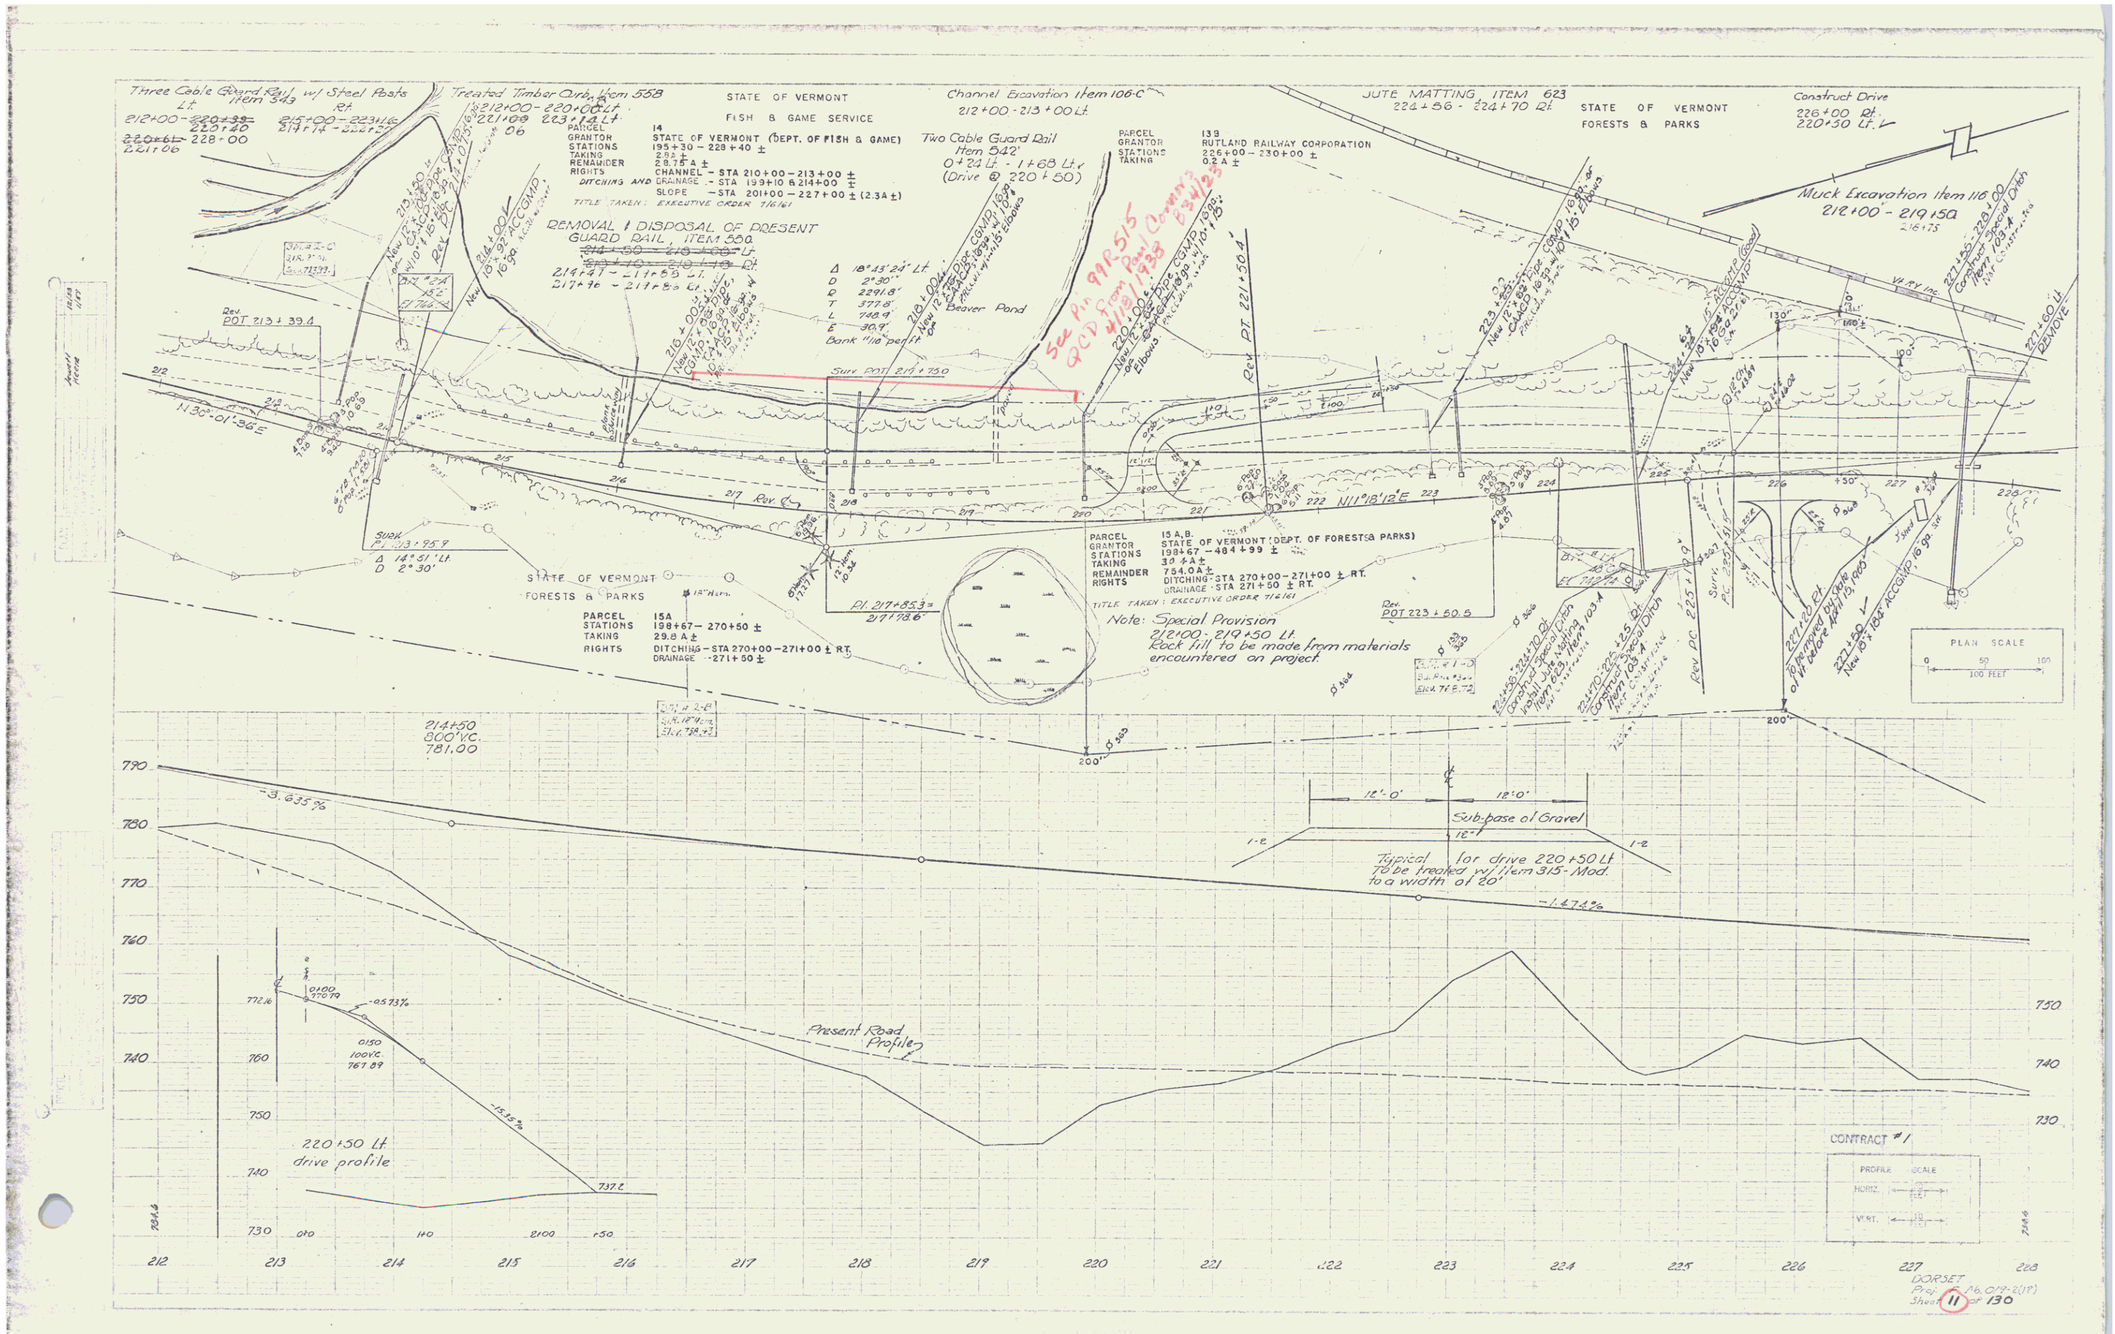
Three Cable Guard Rail w/ Steel Posts Item 542
Lt. 212+00 - 220+00
Rt. 215+00 - 223+46
Treated Timber Curb, Item 558
STATE OF VERMONT
FISH & GAME SERVICE
PARCEL 14
GRANTOR STATE OF VERMONT (DEPT. OF FISH & GAME)
STATIONS 195+30 - 228+40 ±
TAKING 2.5 ±
REMAINDER 28.75 A ±
RIGHTS CHANNEL - STA 210+00 - 213+00 ±
DITCHING AND DRAINAGE - STA 199+10 & 214+00 ±
SLOPE - STA 201+00 - 227+00 ± (2.3A ±)
TITLE TAKEN: EXECUTIVE ORDER 7/6/61
Channel Excavation Item 106-C
212+00 - 213+00 Lt
Two Cable Guard Rail Item 542
0+24 Lt - 1+68 Lt
(Drive @ 220+50)
PARCEL 13B
GRANTOR RUTLAND RAILWAY CORPORATION
STATIONS 226+00 - 230+00 ±
TAKING 0.2 A ±
JUTE MATTING, ITEM 623
224+56 - 224+70 Rt
STATE OF VERMONT
FORESTS & PARKS
Construct Drive
226+00 Rt.
220+50 Lt.
Muck Excavation Item 116
212+00 - 219+50
REMOVAL & DISPOSAL OF PRESENT GUARD RAIL, ITEM 556
Δ 18°43'24" Lt
D 2°30"
R 2291.8'
T 377.8'
L 748.9'
E 30.9'
Beaver Pond
See Pin 99R515 PCD from Paul Clemons 4/28/1938 B342
Rev POT 213+39.4
Rev PT 221+50.4
Surv POT 219+75.0
N30°01'36"E
N11°18'12"E
PARCEL 15 A,B.
GRANTOR STATE OF VERMONT (DEPT. OF FORESTS & PARKS)
STATIONS 198+67 - 484+39 ±
TAKING 30.4 A ±
REMAINDER 754.0 A ±
RIGHTS DITCHING - STA 270+00 - 271+00 ± RT.
DRAINAGE - STA 271+50 ± RT.
TITLE TAKEN: EXECUTIVE ORDER 7/6/61
STATE OF VERMONT
FORESTS & PARKS
PARCEL 15A
STATIONS 198+67 - 270+50 ±
TAKING 29.8 A ±
RIGHTS DITCHING - STA 270+00 - 271+00 ± RT.
DRAINAGE - 271+50 ±
Note: Special Provision
212+00 - 219+50 Lt.
Rock fill to be made from materials encountered on project.
Rev POT 223+50.5
Rev PC 225+50
Surv PC 227+50
PLAN SCALE
0 50 100
100 FEET
214+50
800' VC.
781.00
-3.635%
-1.474%
12'-0"
12'-0"
Sub-base of Gravel
Typical for drive 220+50 Lt
To be treated w/ Item 315-Mod.
to a width of 20'
Present Road Profile
220+50 Lt
drive profile
-0.573%
-15.35%
0+00
0+50
100 VC.
767.89
737.2
CONTRACT #1
PROFILE SCALE
HORIZ. 1" = 50'
VERT. 1" = 10'
DORSET
Proj. No. 0119-2(19)
Sheet 11 of 130

5