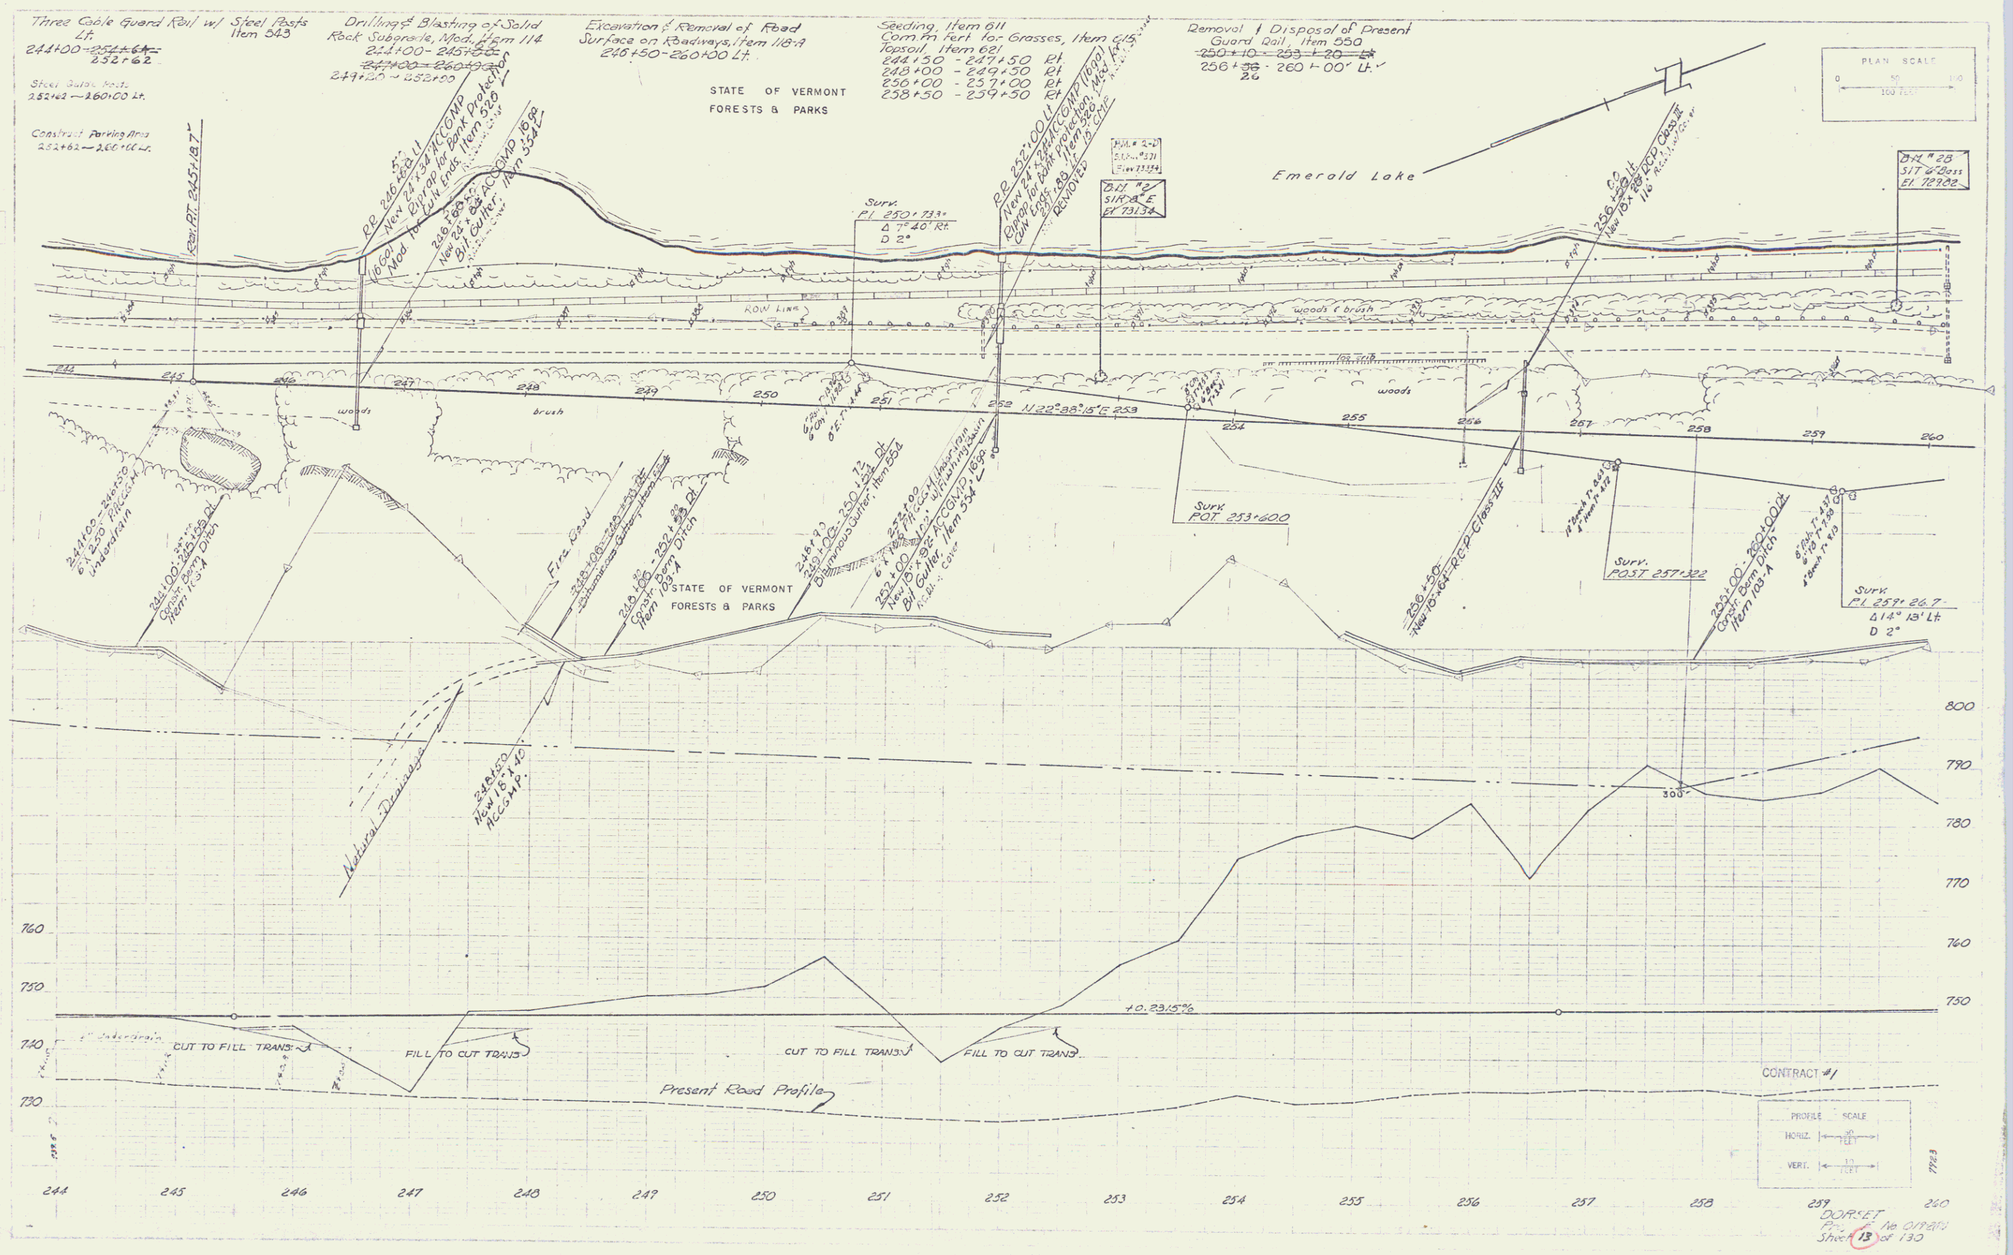
Three Cable Guard Rail w/ Steel Posts Lt.
244+00 - 252+62
Steel Guide Posts
252+62 — 260+00 Lt.
Construct Parking Area
252+62 — 260+00 Lt.
Drilling & Blasting of Solid Rock Subgrade, Mod. Item 114
244+00 - 245+50
249+20 - 252+00
Excavation & Removal of Road Surface on Roadways, Item 118-A
246+50 - 260+00 Lt.
STATE OF VERMONT
FORESTS & PARKS
Seeding, Item 611
Com'l fert. for Grasses, Item 615
Topsoil, Item 621
244+50 - 247+50 Rt
248+00 - 249+50 Rt
250+00 - 257+00 Rt
258+50 - 259+50 Rt
Removal & Disposal of Present Guard Rail, Item 550
256+10 - 260+00 Lt.
PLAN SCALE
0 50 100
160 FEET
Emerald Lake
ROW LINE
woods & brush
woods
brush
N 22°38'15" E 259
Surv. POST 253+600
Surv. POST 257+322
Surv. PI 259+26.7
Δ 14° 13' Lt.
D 2°
Natural Drainage
800
790
780
770
760
750
740
730
+0.23 15%
CUT TO FILL TRANS.
FILL TO CUT TRANS.
CUT TO FILL TRANS.
FILL TO CUT TRANS.
Present Road Profile
CONTRACT #1
PROFILE SCALE
HORIZ. 50 FEET
VERT. 10 FEET
244 245 246 247 248 249 250 251 252 253 254 255 256 257 258 259 260
DORSET
Sheet 13 of 130

7