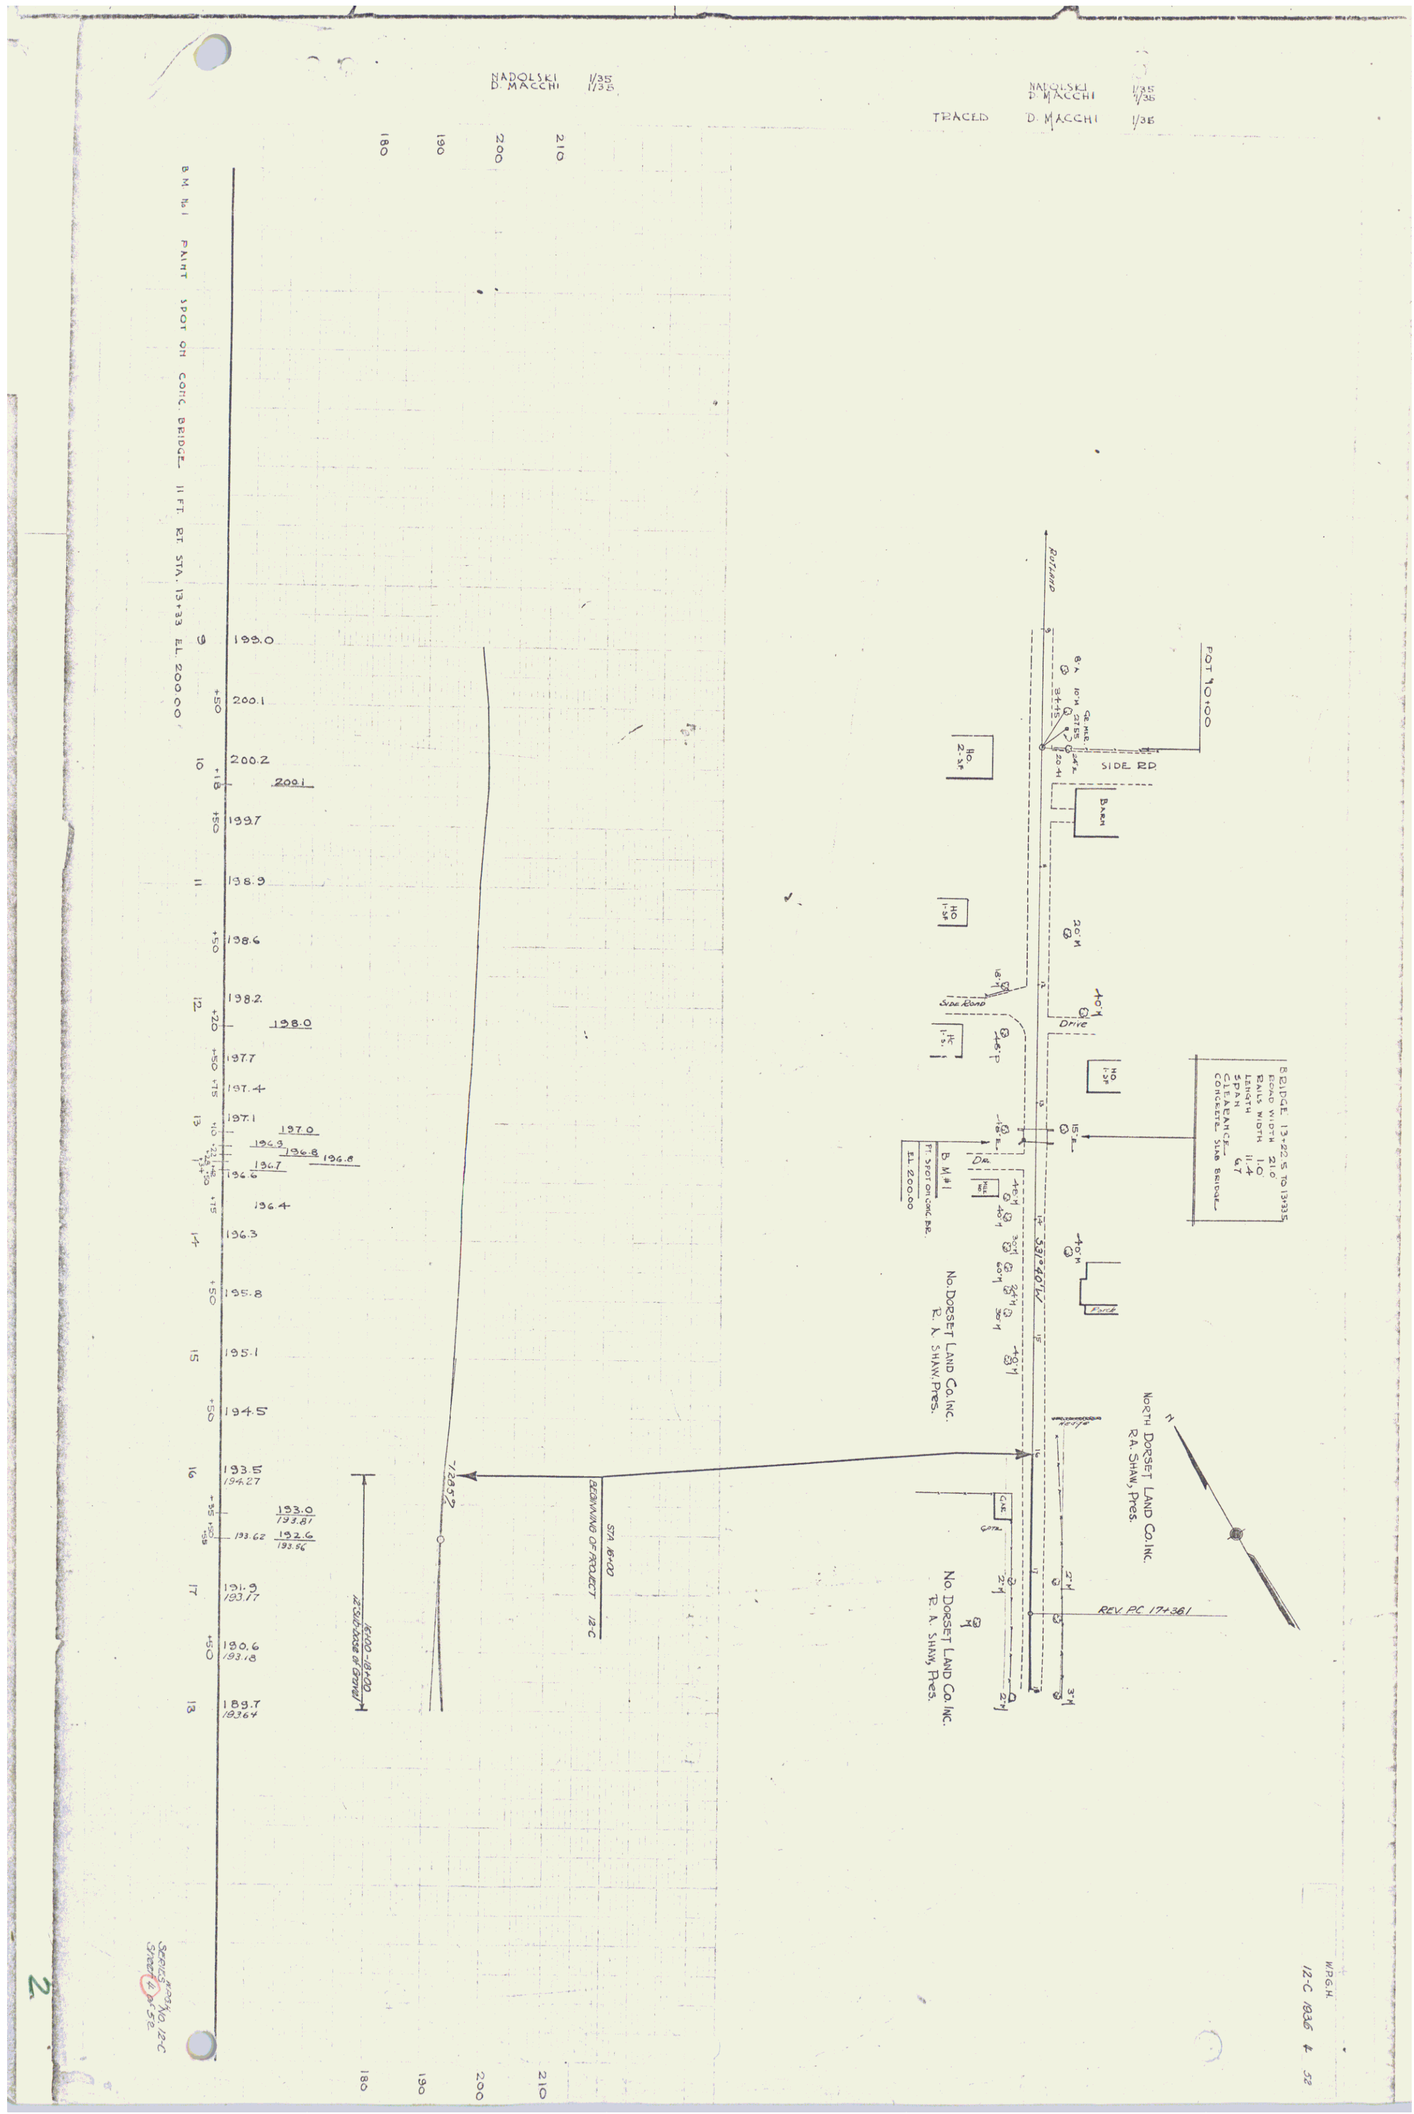
NADOLSKI 1/35
D. MACCHI 1/35
TRACED
B.M. No 1 PAINT SPOT ON CONC. BRIDGE 11 FT. RT. STA. 13+33 EL. 200.00
POT 90+00
SIDE RD.
BARN
Drive
BRIDGE 13+22.5 TO 13+33.5
ROAD WIDTH 21.0'
RAILS WIDTH 1.0'
LENGTH 11.4'
SPAN 6.7'
CLEARANCE
CONCRETE SLAB BRIDGE
No. DORSET LAND CO. INC.
R. A. SHAW, Pres.
NORTH DORSET LAND CO. INC.
R.A. SHAW, Pres.
REV. P.C. 17+36.1
STA 16+00
BEGINNING OF PROJECT 12-C
16+00-18+00
12' Sub-base of Gravel
W.P.G.H.
12-C 1936 & 52

2