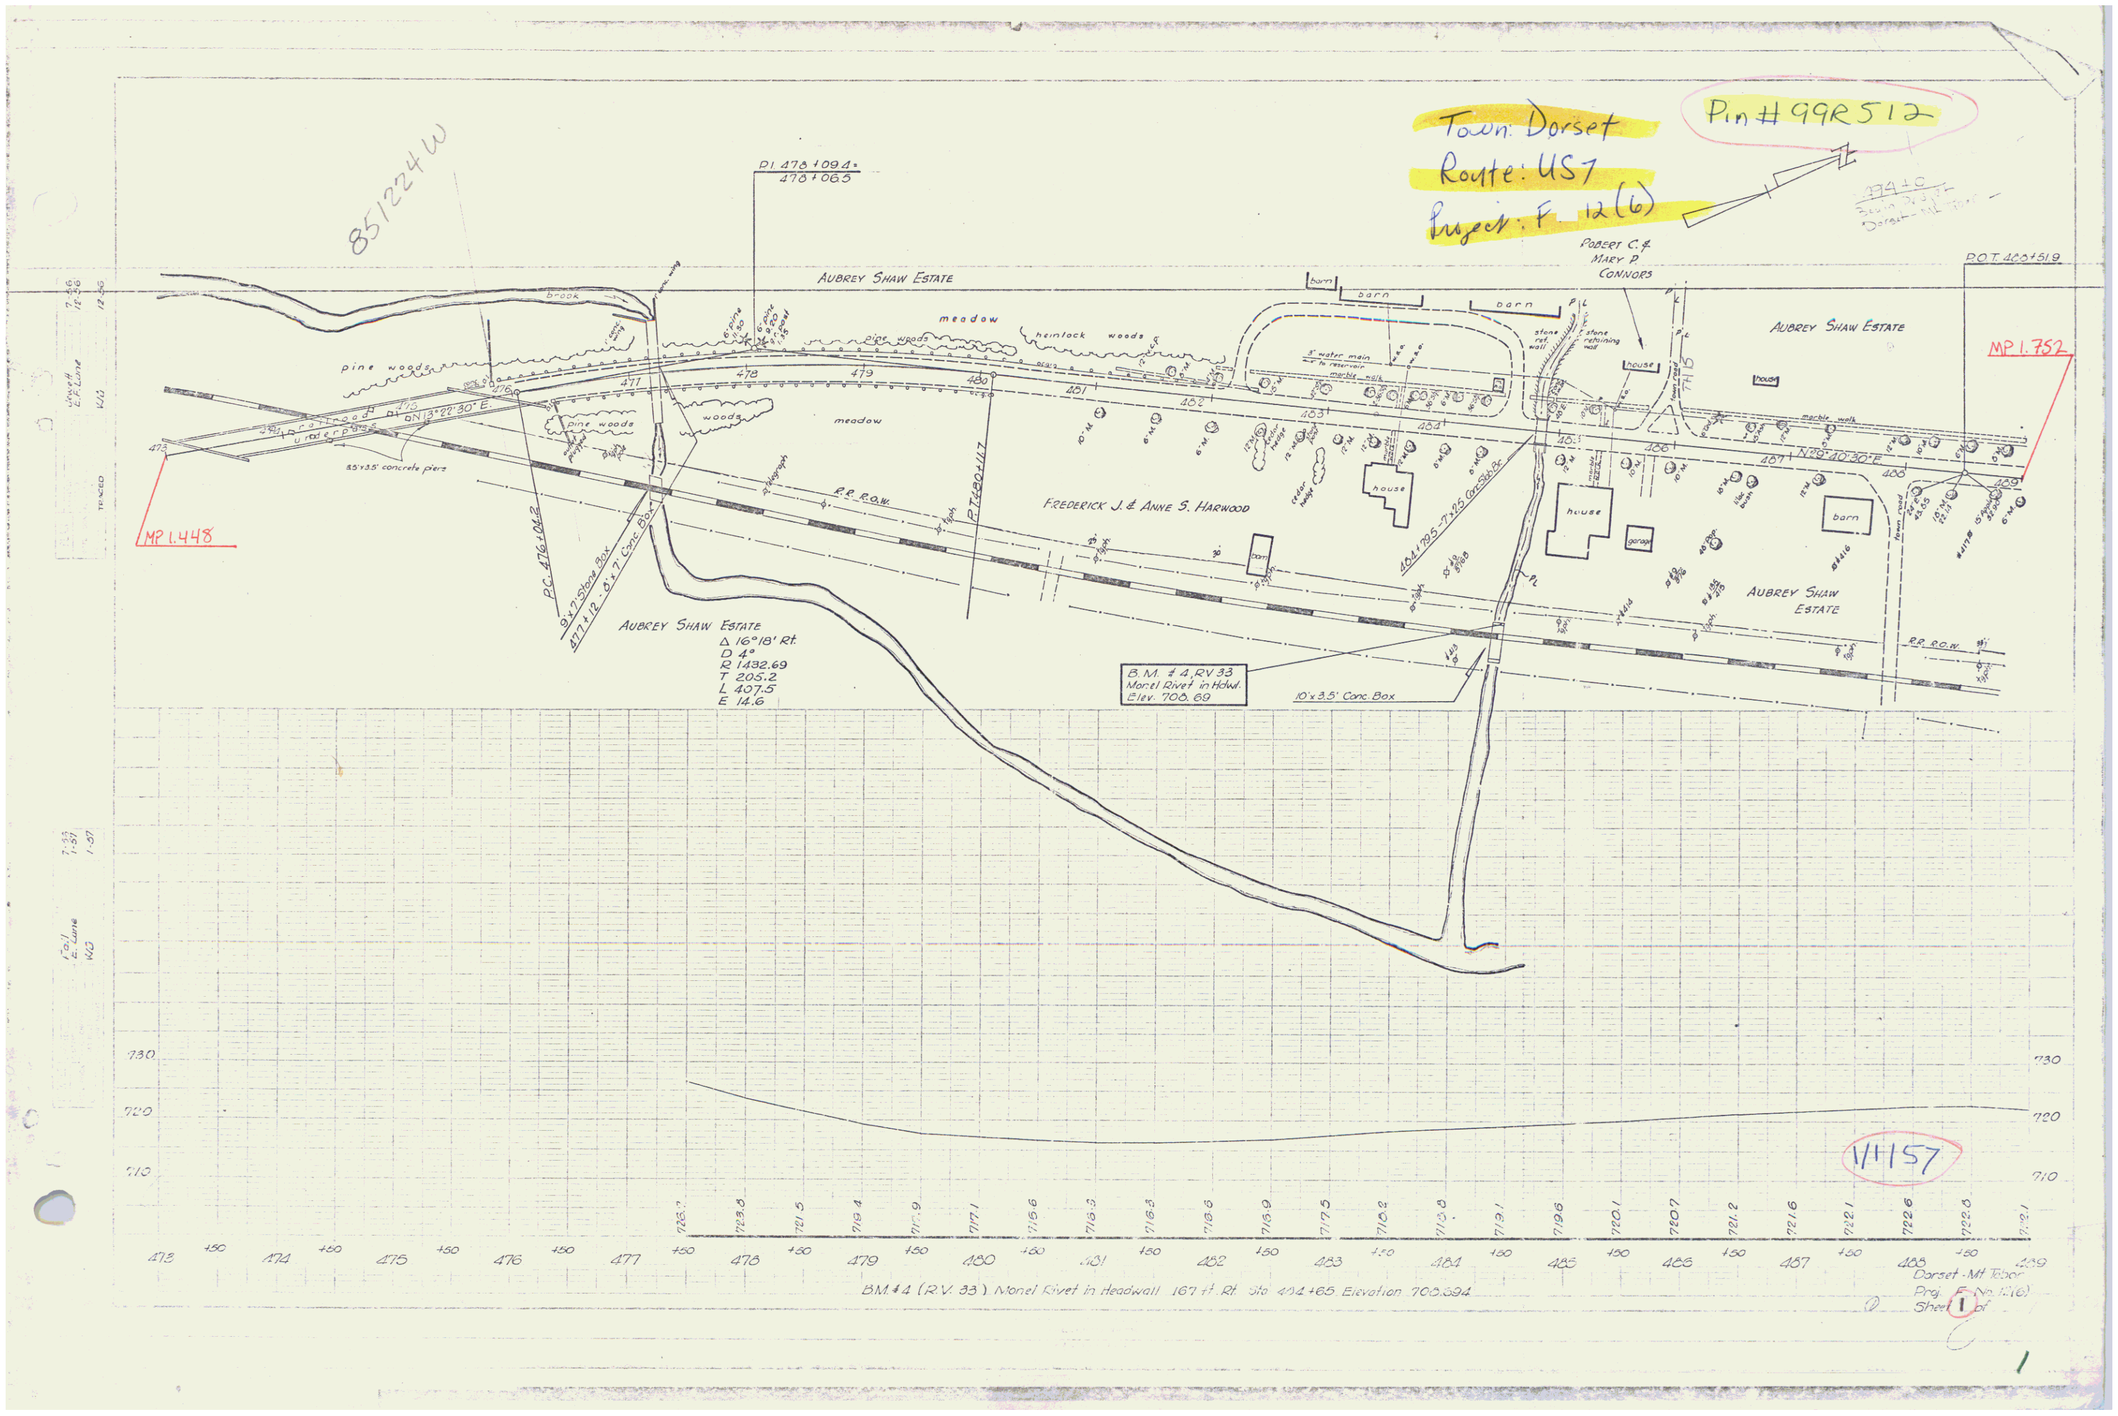
Town: Dorset
Route: US7
Project: F 12(6)
Pin # 99R512
85122 4W
PI 478+094.4
478+063
AUBREY SHAW ESTATE
meadow
pine woods
hemlock woods
woods
brook
N13°22'30"E
85'x35' concrete piers
MP 1.448
PC 476+042
8'x7' Stone Box
477+12 8'x7' Conc. Box
AUBREY SHAW ESTATE
Δ 16°18' Rt.
D 4°
R 1432.69
T 205.2
L 407.5
E 14.6
R.R. R.O.W.
PT 480+117
FREDERICK J. & ANNE S. HARWOOD
barn
house
garage
8" water main to reservoir
marble walk
stone retaining wall
ROBERT C. & MARY P. CONNORS
P.O.T. 483+51.9
MP 1.752
N29°40'30"E
B.M. # 4, R.V. 33
Monel Rivet in Hdwl.
Elev. 708.69
10'x3.5' Conc. Box
BM # 4 (R.V. 33) Monel Rivet in Headwall 167 ft. Rt. Sta. 484+65 Elevation 708.394
Dorset - Mt Tabor
Proj. F No. 12(6)
Sheet 1 of
VH157