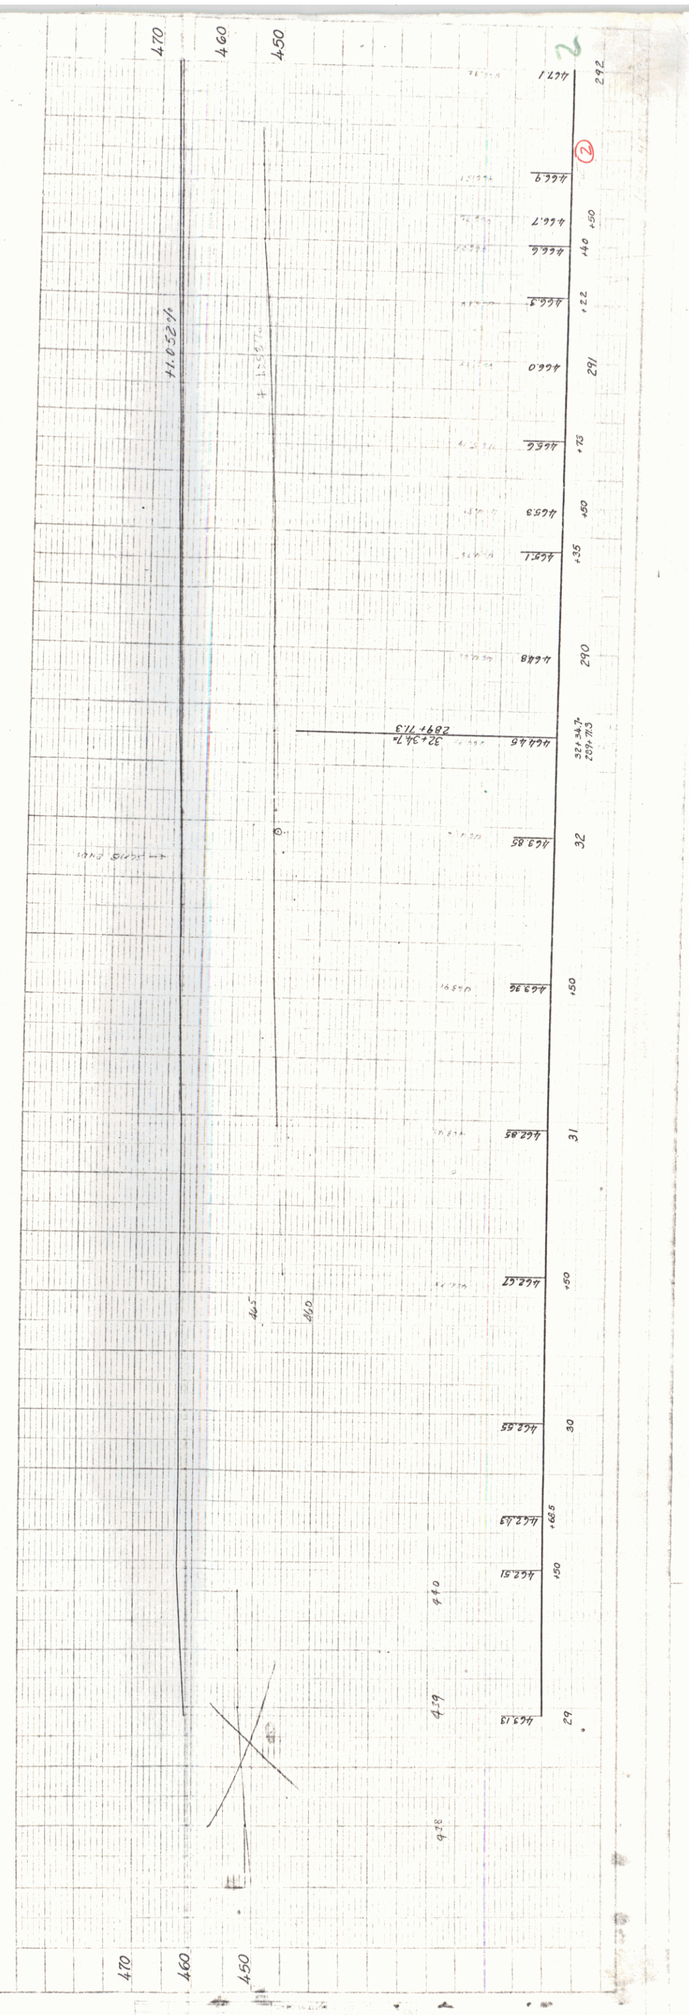
470
460
450
292
291
290
32
31
30
29
2
32+34.7=
32+34.7=
+ 1.55%
0
+ 1.0 52%
