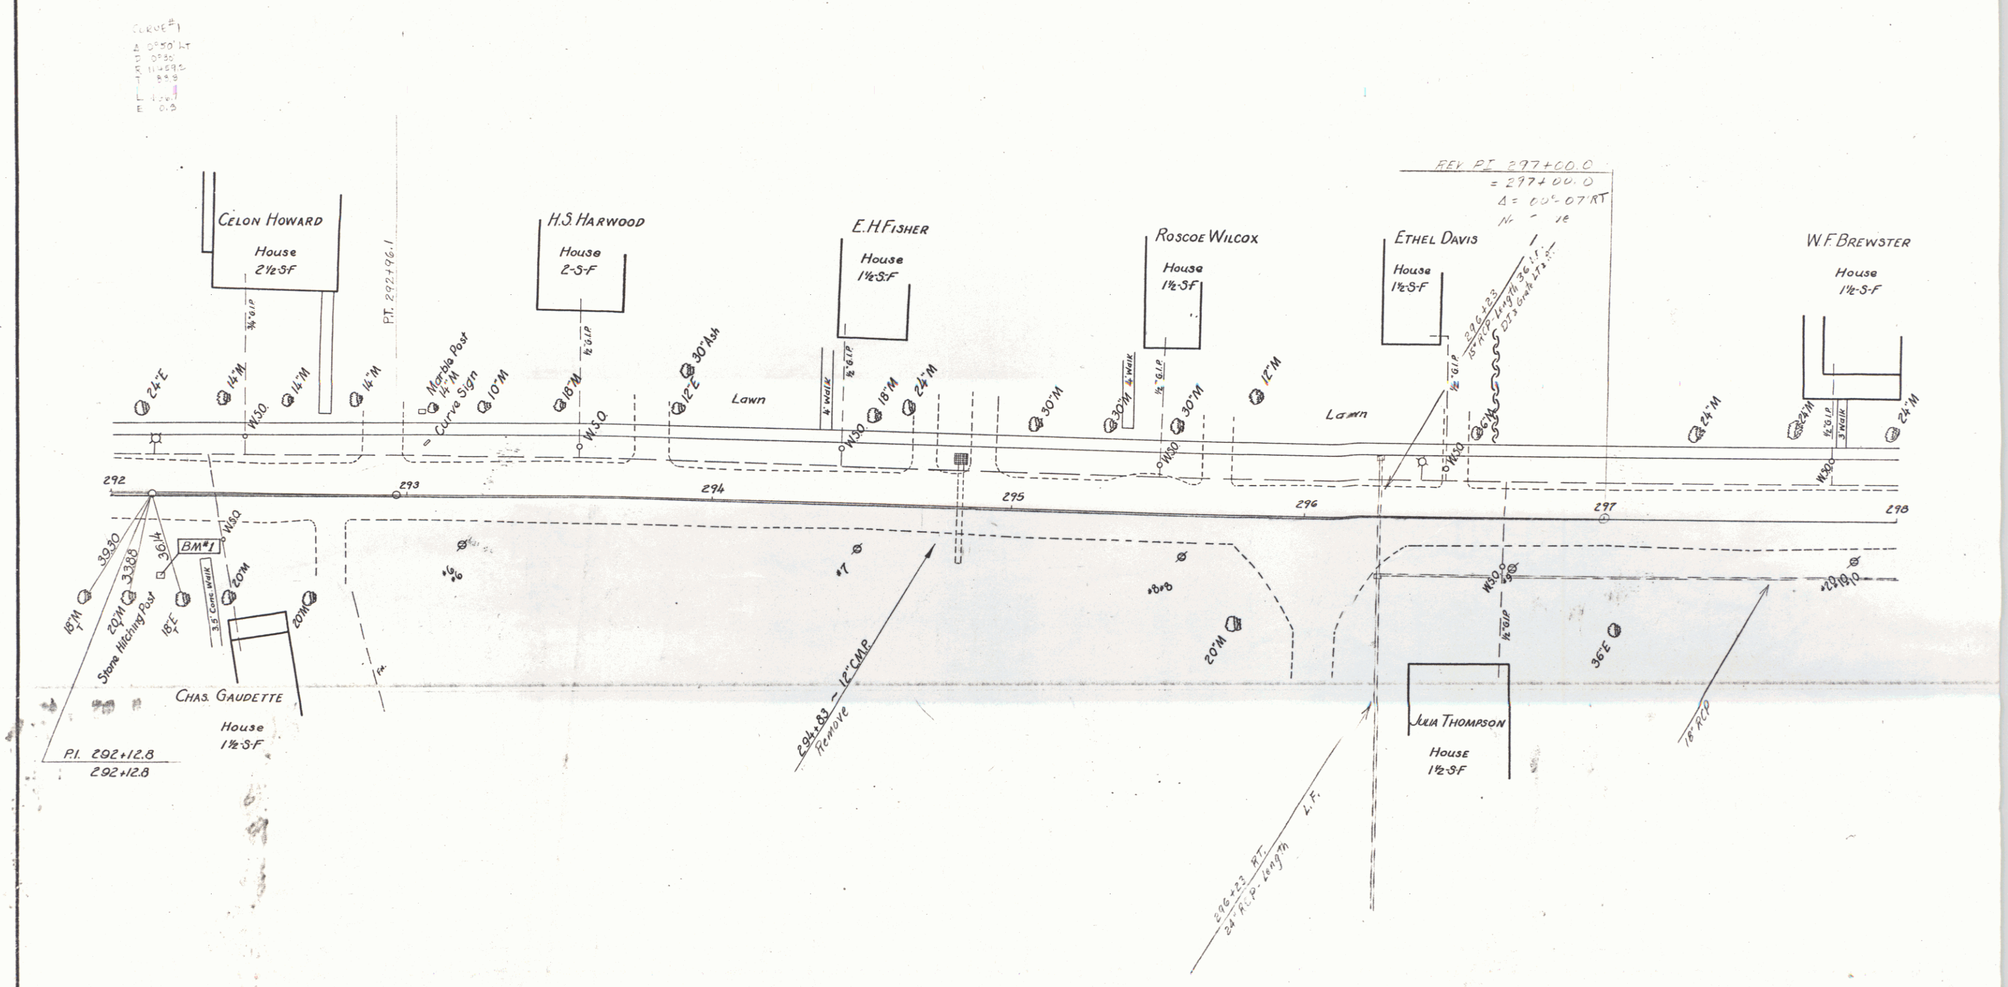

ESTIMATED QUANTITIES

Surveyed by
Designed by
Drawn by
Traced by
Checked by
Series No. 3
Sheet 3 of Filed Sheets