2

INDEX OF SHEETS

STATE OF VERMONT
DEPARTMENT OF HIGHWAYS

PROPOSED IMPROVEMENT

TOWN OF BENNINGTON
COUNTY OF BENNINGTON
US ROUTE 7 CONN.

ROW PLANS

LENGTH OF PROJECT – 3,765 FEET = 0.713 MILES

Pin # 99R516

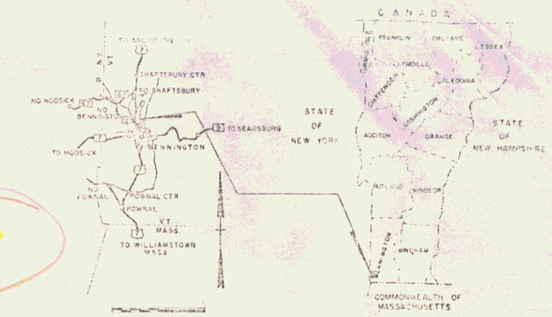

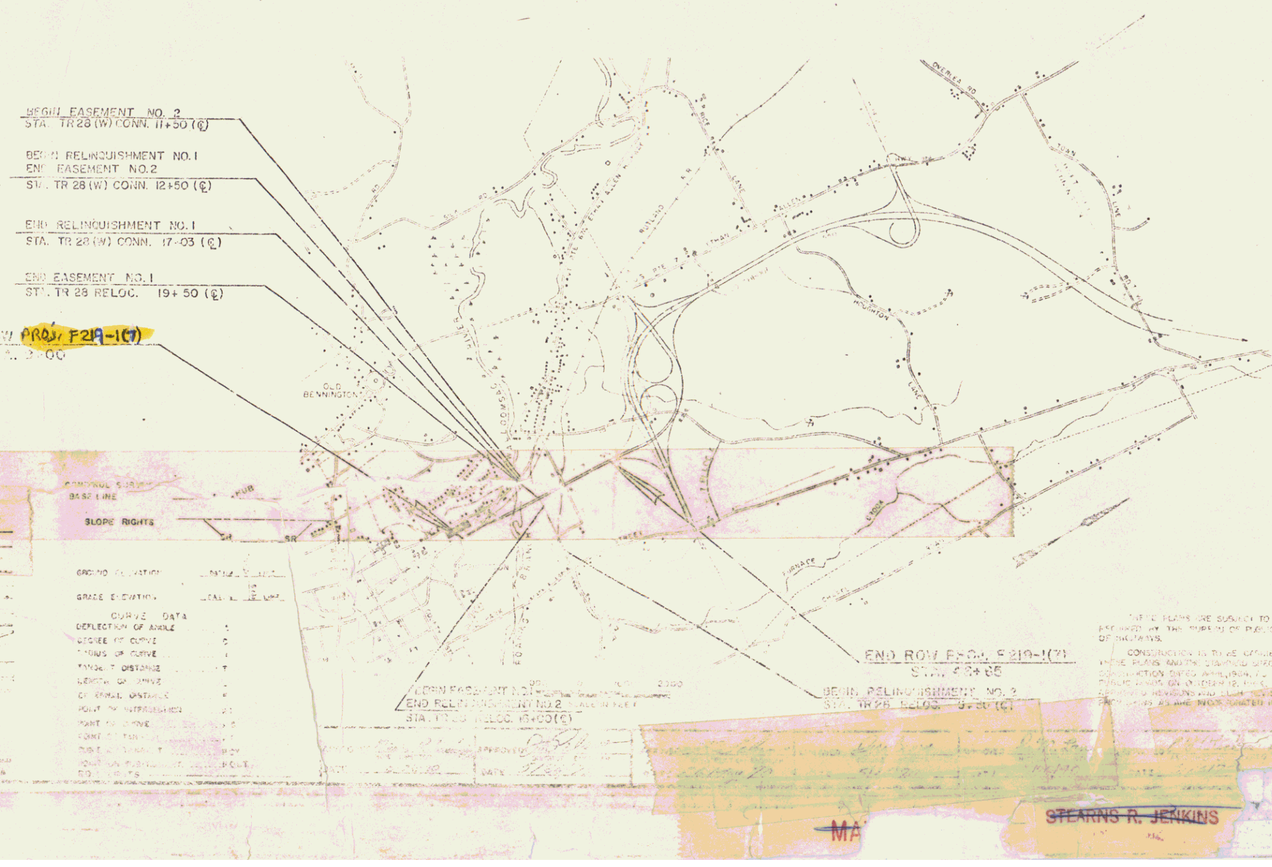

MP 3.77 – 4.49

RIGHT-OF-WAY DIVISION
TOWN FILE
PERPETUAL
Rte ~~Town~~ of US7
(To Be Returned To R.O.W. Division)

5/24/70

SLOPE RIGHTS

GROUND ELEVATION
GRADE ELEVATION
CURVE DATA
DEFLECTION OF ANGLE
DEGREE OF CURVE
TANGENT DISTANCE
LENGTH OF CURVE
EXTERNAL DISTANCE
POINT OF INTERSECTION

THESE PLANS ARE SUBJECT TO SUCH CHANGES AS MAY BE ORDERED BY THE SUPERVISOR OF PUBLIC ROADS OR THE COMMISSIONER OF HIGHWAYS.

CONSTRUCTION TO BE CARRIED ON IN ACCORDANCE WITH THESE PLANS AND THE STANDARD SPECIFICATIONS FOR HIGHWAYS AND BRIDGES CONSTRUCTION DATED JANUARY 1, 1960 APPROVED BY THE BUREAU OF PUBLIC ROADS ON DECEMBER 12, 1960, SUPPLEMENTAL SPECIFICATIONS AND SPECIAL PROVISIONS AS ARE NOW SHOWN IN THESE PLANS.

DEPARTMENT OF HIGHWAYS
BUREAU OF PUBLIC ROADS

APPROVED

DIVISION ENGINEER

Business Route 7
P. US 7

~~MA~~

~~STEARNS R. JENKINS~~