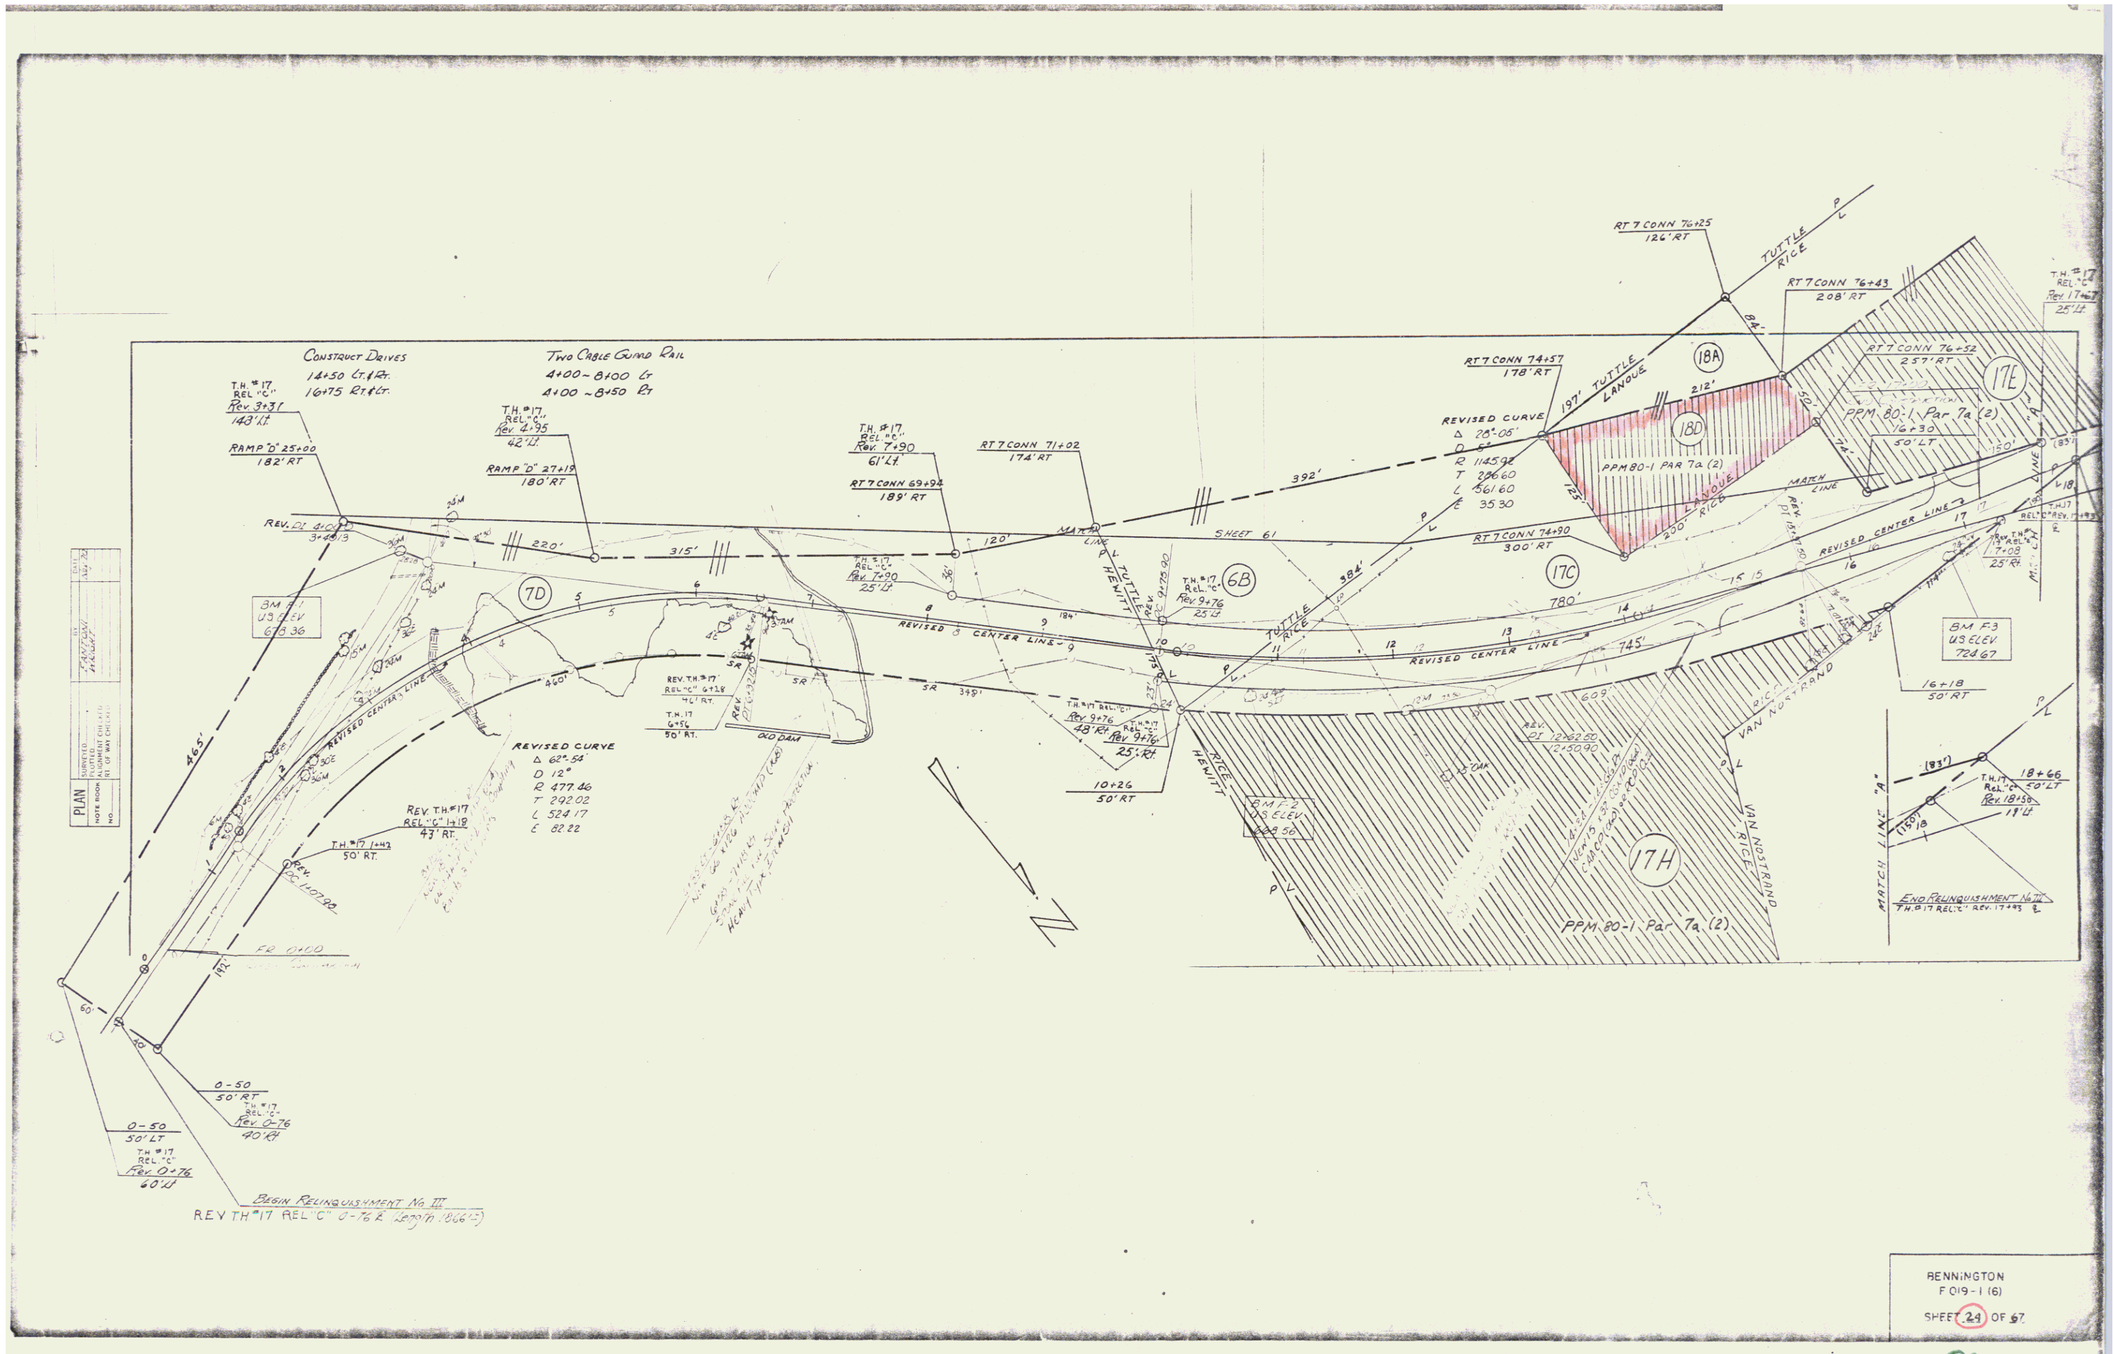

RENNINGTON
F 019-1 (6)

SHEET 24 OF 67

20