FED. ROAD DIST. NO.	STATE	FED. AID PROJ. NO.	FISCAL YEAR	SHEET NO.	TOTAL SHEETS
3	Vt.	73A	1929	7	34

Nothing

GUARD RAIL REQUIRED

ON LEFT

Sta. 184+04	to	Sta. 184+28	Length	24 ft.
" 187+94	to	" 189+04	"	120 "
" 191+88	to	" 192+12	"	24 "

ON RIGHT

Sta. 184+04	to	Sta. 184+28	Length	24 ft.
" 188+00	to	" 188+24	"	24 "
" 191+88	to	" 192+12	"	24 "

NEW CULVERTS REQUIRED

Sta. 184+16	18" Concrete Pipe	30 ft.
	1-2½-5 Concrete	2.5 cu. yd.
Sta. 188+12	3'x3' Reinforced Concrete Box	
	1-2-4 Concrete	4.1 cu. yd.
	1-2½-5 Concrete	13.0 cu. yd.
	Reinforcing Steel	210 cu. yd.
Sta. 192+00	15" Concrete Pipe	30 ft.
	1-2½-5 Concrete	2.0 cu. yd.

SUB BASE REQUIRED

Sta. 182+00 to Sta. 188+10 Length 610 ft.
" 189+20 " " 192+00 " 280 "
(Above bid as per Note on Sheet 6.)

CONCRETE CURB AND GUTTER

Sta. 186+45 to Sta. 187+45 Length 100 ft.
1-2-4 Concrete 7.5 cu. yds.

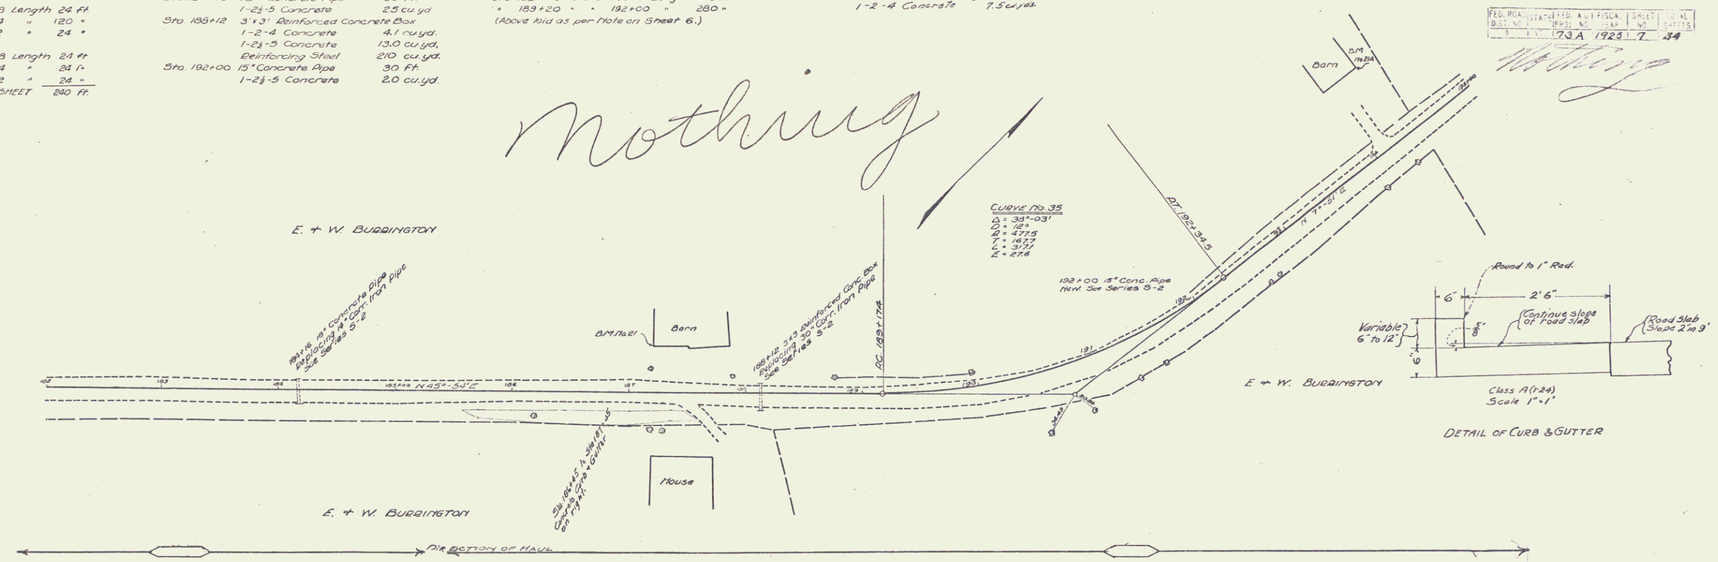

182+00 to 195+00
Ditch on Right as per Typical section with base unless otherwise specified.

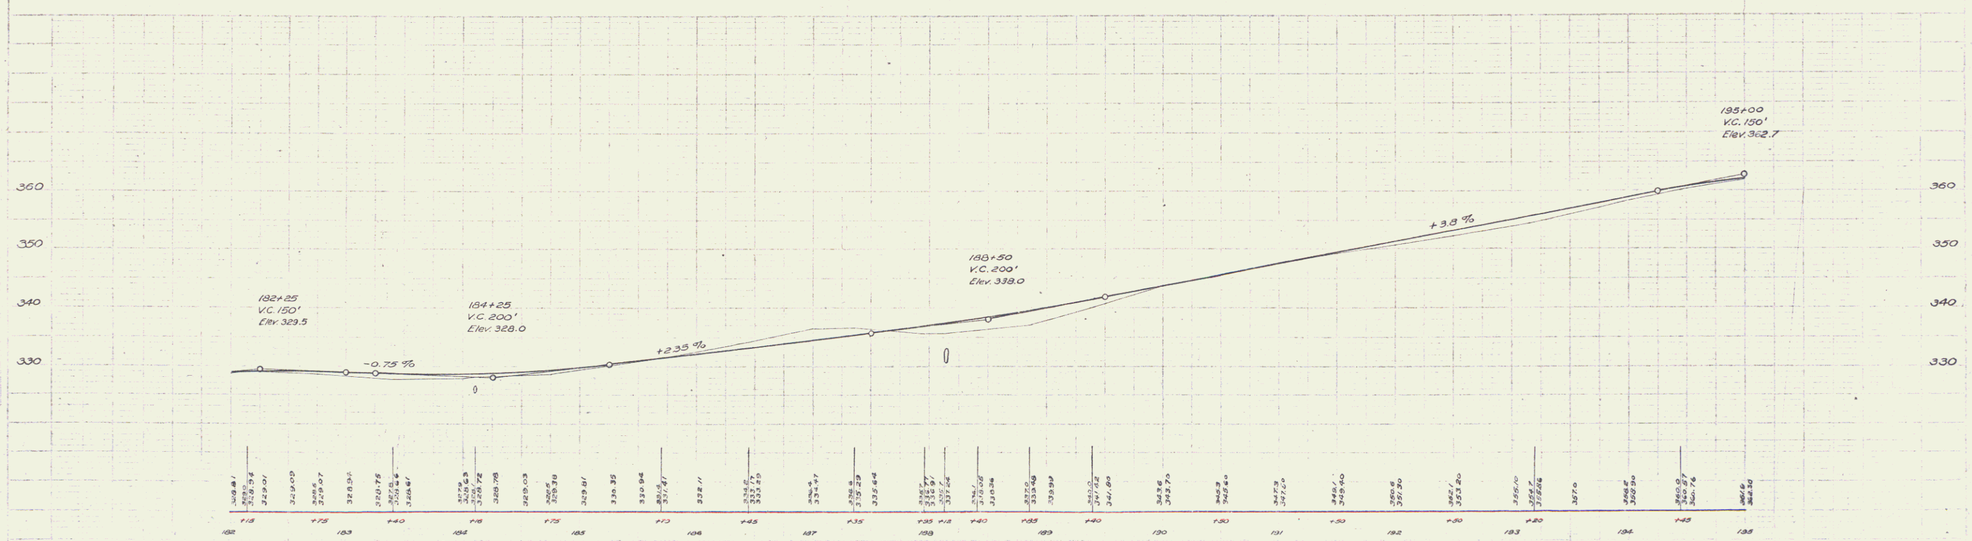

B.M. No. 21 Top of wall, S.E. Cor. of Barn, Left of Sta. 187+21 Elev. 336.05
B.M. No. 21A Bottom of batter board N.E. Cor. Barn, L - - 194+33 Elev. 358.43

Series E No. 73A
Sheet 7 of 34

6