FED. ROAD DIV.	STATE	FED. AID PROJ. NO.	FISCAL YEAR	SHEET NO.	TOTAL SHEETS
1	VT.		1925	10	34

GUARD RAIL REQUIRED

ON LEFT

Sta 228+00 to Sta 238+00 Length 1000 ft.

~~Sta 242+00 to Sta 243+00 100 ft.~~

ON RIGHT

Sta 228+22 to Sta 228+46 Length 24 ft.

" 231+58 " " 231+82 " 24 "

" 236+38 " " 236+62 " 24 "

~~Sta 242+18 to Sta 242+72 " 104 "~~

~~Sta 242+97 to Sta 243+00 " 43 "~~

TOTAL THIS SHEET 1012 ft.

NEW CULVERTS REQUIRED

Sta 228+34 15" Concrete Pipe 34 ft.
Drop Inlet
1-2½-5 Concrete 3.1 cu yd.

Sta 231+70 18" Concrete Pipe 32 ft.
Drop Inlet
1-2½-5 Concrete 3.0 cu yd.

Sta 236+50 18" Concrete Pipe 32 ft.
Drop Inlet
1-2½-5 Concrete 3.0 cu yd.

~~Sta 241+50 18" Concrete Pipe 44 ft.~~
~~1-2½-5 Concrete 3.0 cu yd.~~

~~Sta 239+40 18" Corrugated Iron Pipe 30 ft.~~
~~(Under Road Approach)~~

SUB BASE REQUIRED

Sta 227+00 to Sta 231+35 length 435 ft.

" 231+35 to " 238+00 " 665 ft.

~~Sta 242+18 to " 242+72 " 54 ft.~~

* (Laid as per Note on Sheet 6.)

Nothing

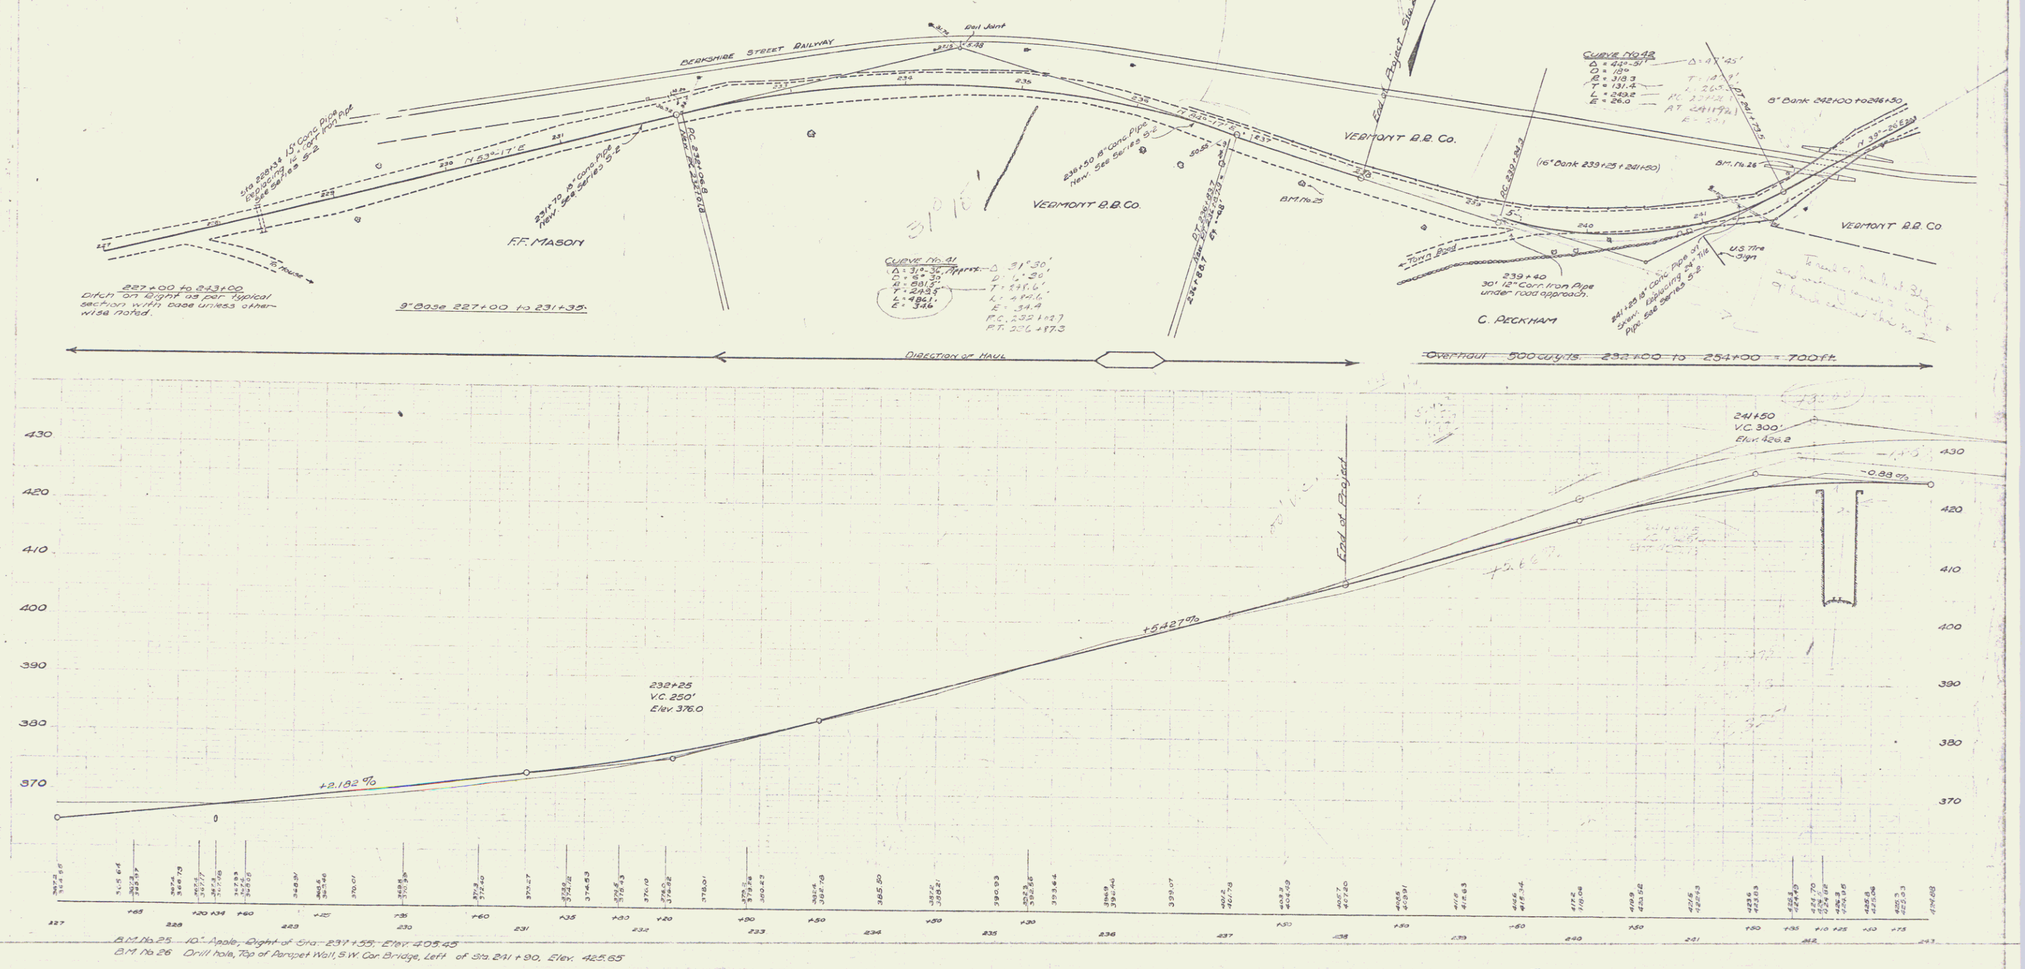

B.M. No. 25 10" Apple, Right of Sta. 231+55, Elev. 405.45

B.M. No. 26 Drill hole, Top of Parapet Wall, S.W. Cor. Bridge, Left of Sta. 241+90, Elev. 425.65

Series F No. 73A
Sheet 10 of 34

9