WOOD GUARD RAIL REQUIRED

ON LEFT

Sta 306+27 to Sta. 306+51 Length 24 ft.
" 308+10 " " 308+34 " 24 "

ON RIGHT

Sta 306+27 to Sta 306+51 Length 24 ft.
" 308+10 " " 308+34 " 24 "

TOTAL THIS SHEET 96 ft

NEW CULVERTS REQUIRED

Sta 308+39 24" Conc. or Cast Iron Pipe 52 ft
1-2-4 Concrete 2.6 Cu.yds
Reinf. Steel 60 lbs.

Sta. 308+22 18" Conc. Cast Iron Pipe 36 ft
1-2-4 Concrete 1.9 Cu.yds
Reinf. Steel 60 lbs

6" SUB BASE REQUIRED

Sta 295+85 to 298+75 Length 290 ft.
" 308+00 " 310+00 " 200 "

VT. 738 1926 7 73

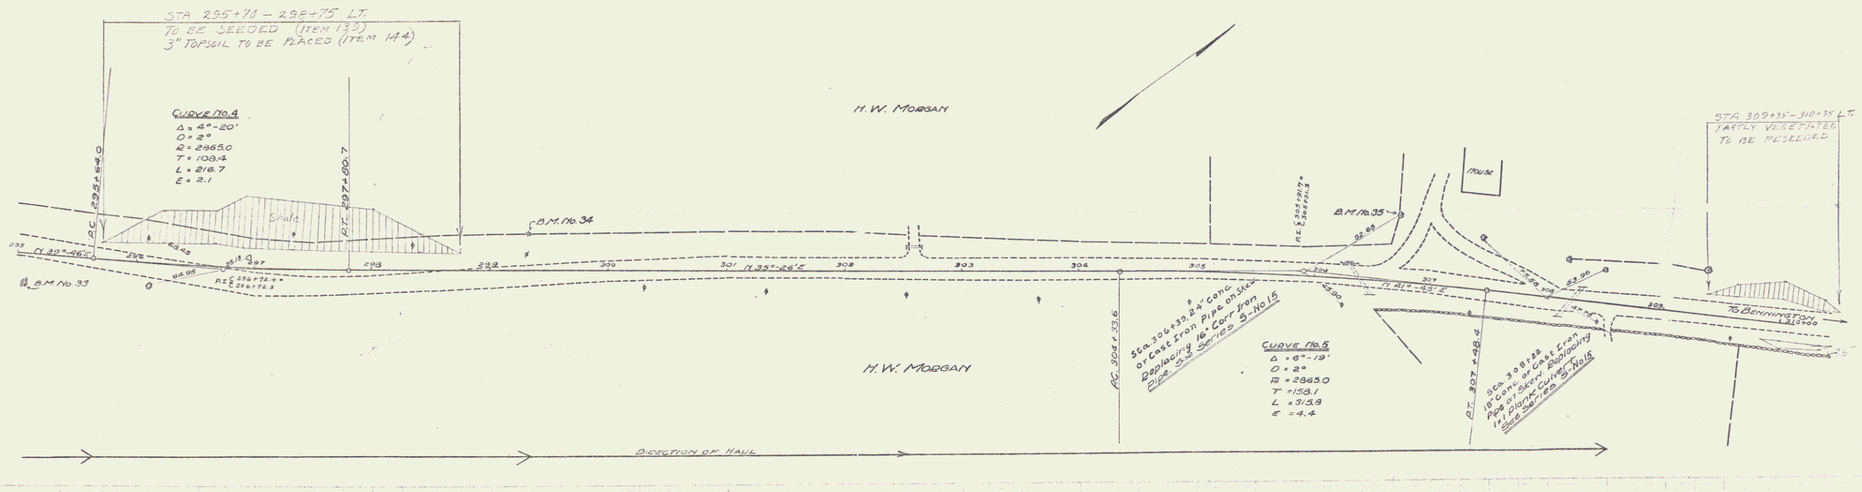

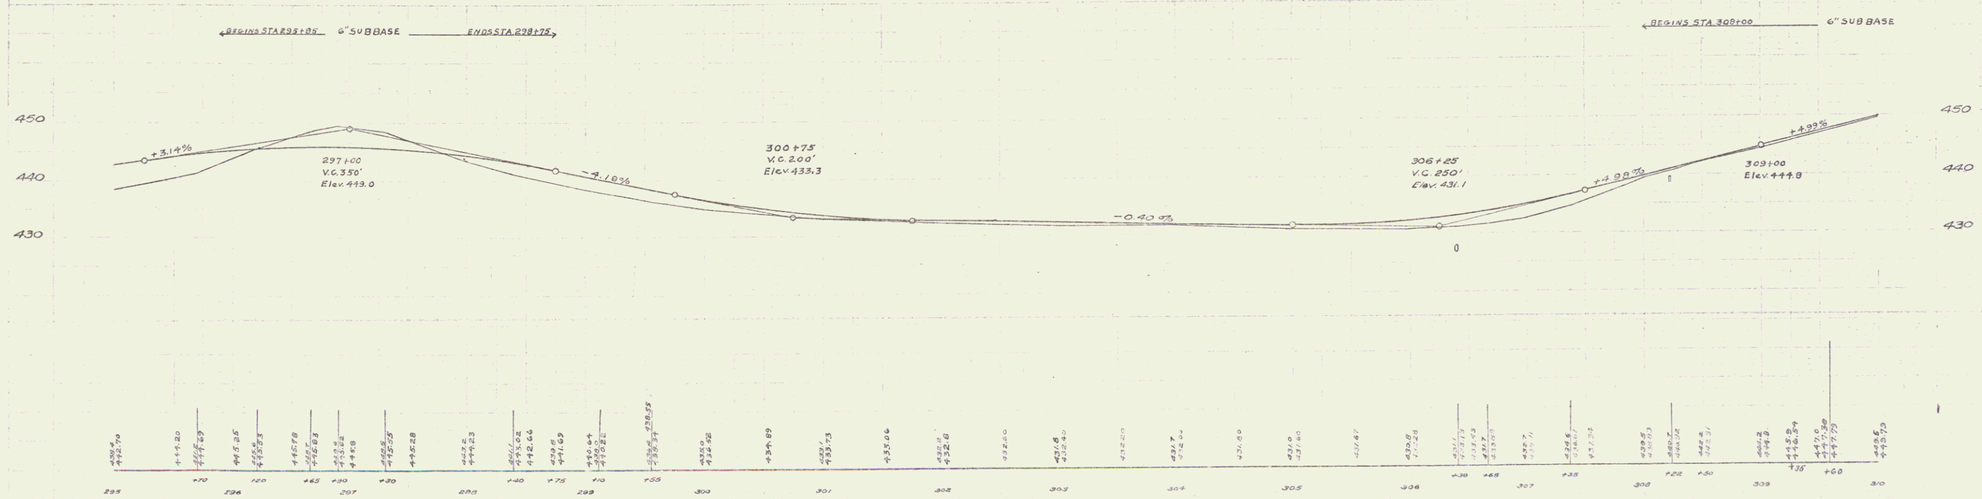

B.M. No. 33 Drill hole in Boulder, Right of Sta. 295+07 Elev. 435.68
B.M. No. 34 18" Pine Tree, Left of Sta. 298+61 Elev. 439.98
B.M. No. 35 24" Maple Tree, Left of Sta. 306+68 Elev. 434.60

Series F No. 738
Sheet 7 of 73

6