Nothing

WOOD GUARD RAIL REQUIRED

			LEFT			
Sta.	485+03	to	Sta. 485+33	Length	24 ft	
"	492+13	to	" 492+37	"	24 "	
"	495+85	to	" 496+12	"	24 "	
"	499+48	to	" 499+72	"	24 "	
			RIGHT			
Sta.	491+71	to	Sta. 492+75	Length	104 ft.	
"	495+38	to	" 496+12	"	24 "	
"	499+48	to	" 499+72	"	24 "	
			TOTAL THIS SHEET		248 ft	

CABLE GUARD RAIL REQUIRED

RIGHT.

Sta. 485+00 to Sta. 485+38 Length 38 ft.

NEW CULVERTS REQUIRED

Sta. 491+21 4'x3' Reinf. Conc. Box Culv. 5 ft Extension
Class A Conc. (1-2-4) 4.0 Cu. yd.
Reinf. Steel 230 lbs.

Sta. 492+27 18" Reinf. Conc. or Cast Iron pipe Length 36 ft.
Class B Conc. (1-2½-5) 2.7 Cu. yds.
Reinf. Steel 33 lbs.

Sta. 496+00 18" Reinf. Conc. or Cast Iron pipe Length 36 ft.
Class B Conc. (1-2½-5) 2.7 Cu. yds.
Reinf. Steel 33 lbs.

Sta. 499+59 18" Reinf. Conc. or Cast Iron pipe Length 36 ft.
Class B Conc. (1-2½-5) 2.7 Cu. yd.
Reinf. Steel 33 lbs.

6" SUB-BASE REQUIRED

Sta. 485+00 to Sta. 500+00 Length 1500 ft.

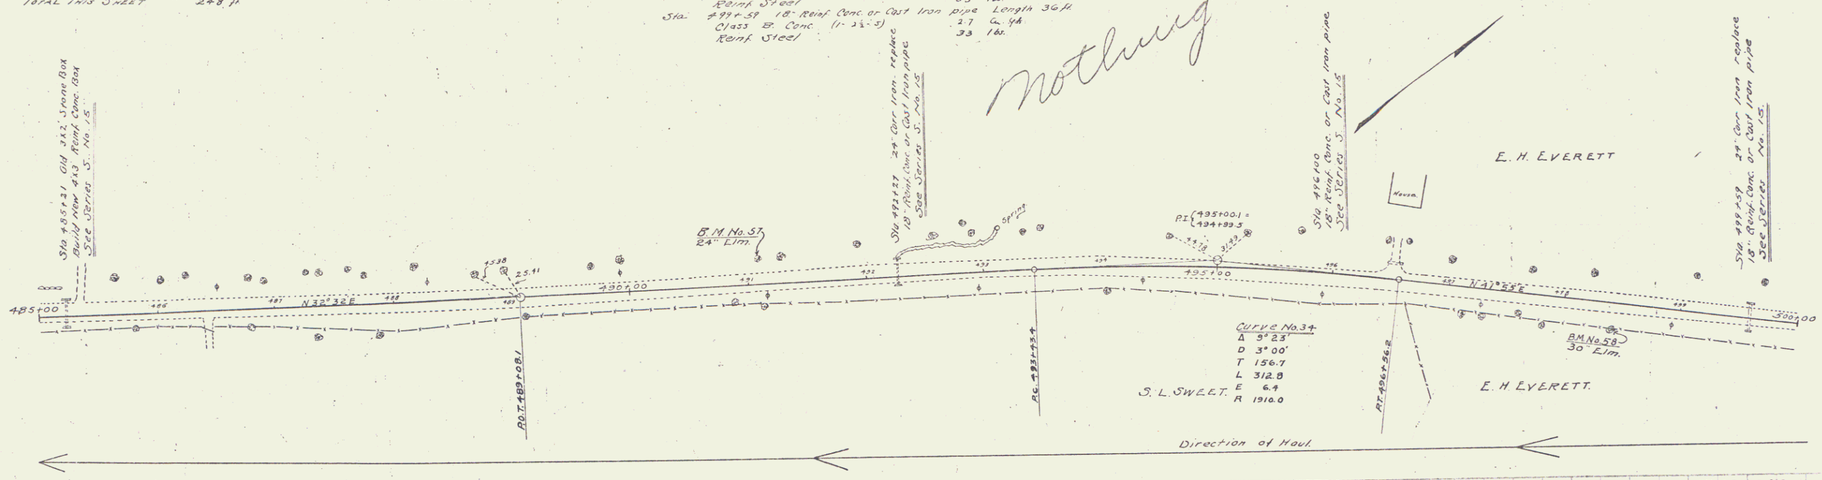

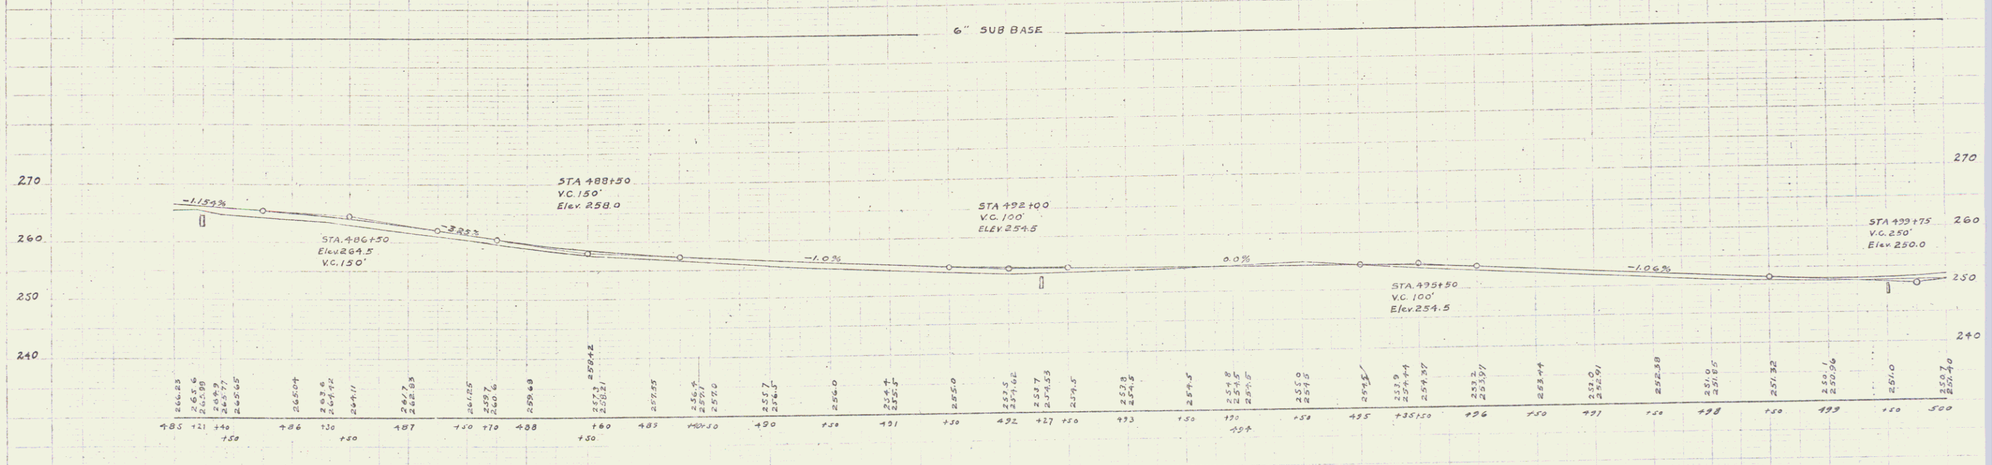

B.M. No 57 Spike in 24" Elm Tree, Left of Sta. 491+21 Elev. 255.53
B.M. No 58 Spike in 30" Elm Tree, Right of Sta. 498+42 Elev. 248.30

Series F No 738
Sheet 20 of 73