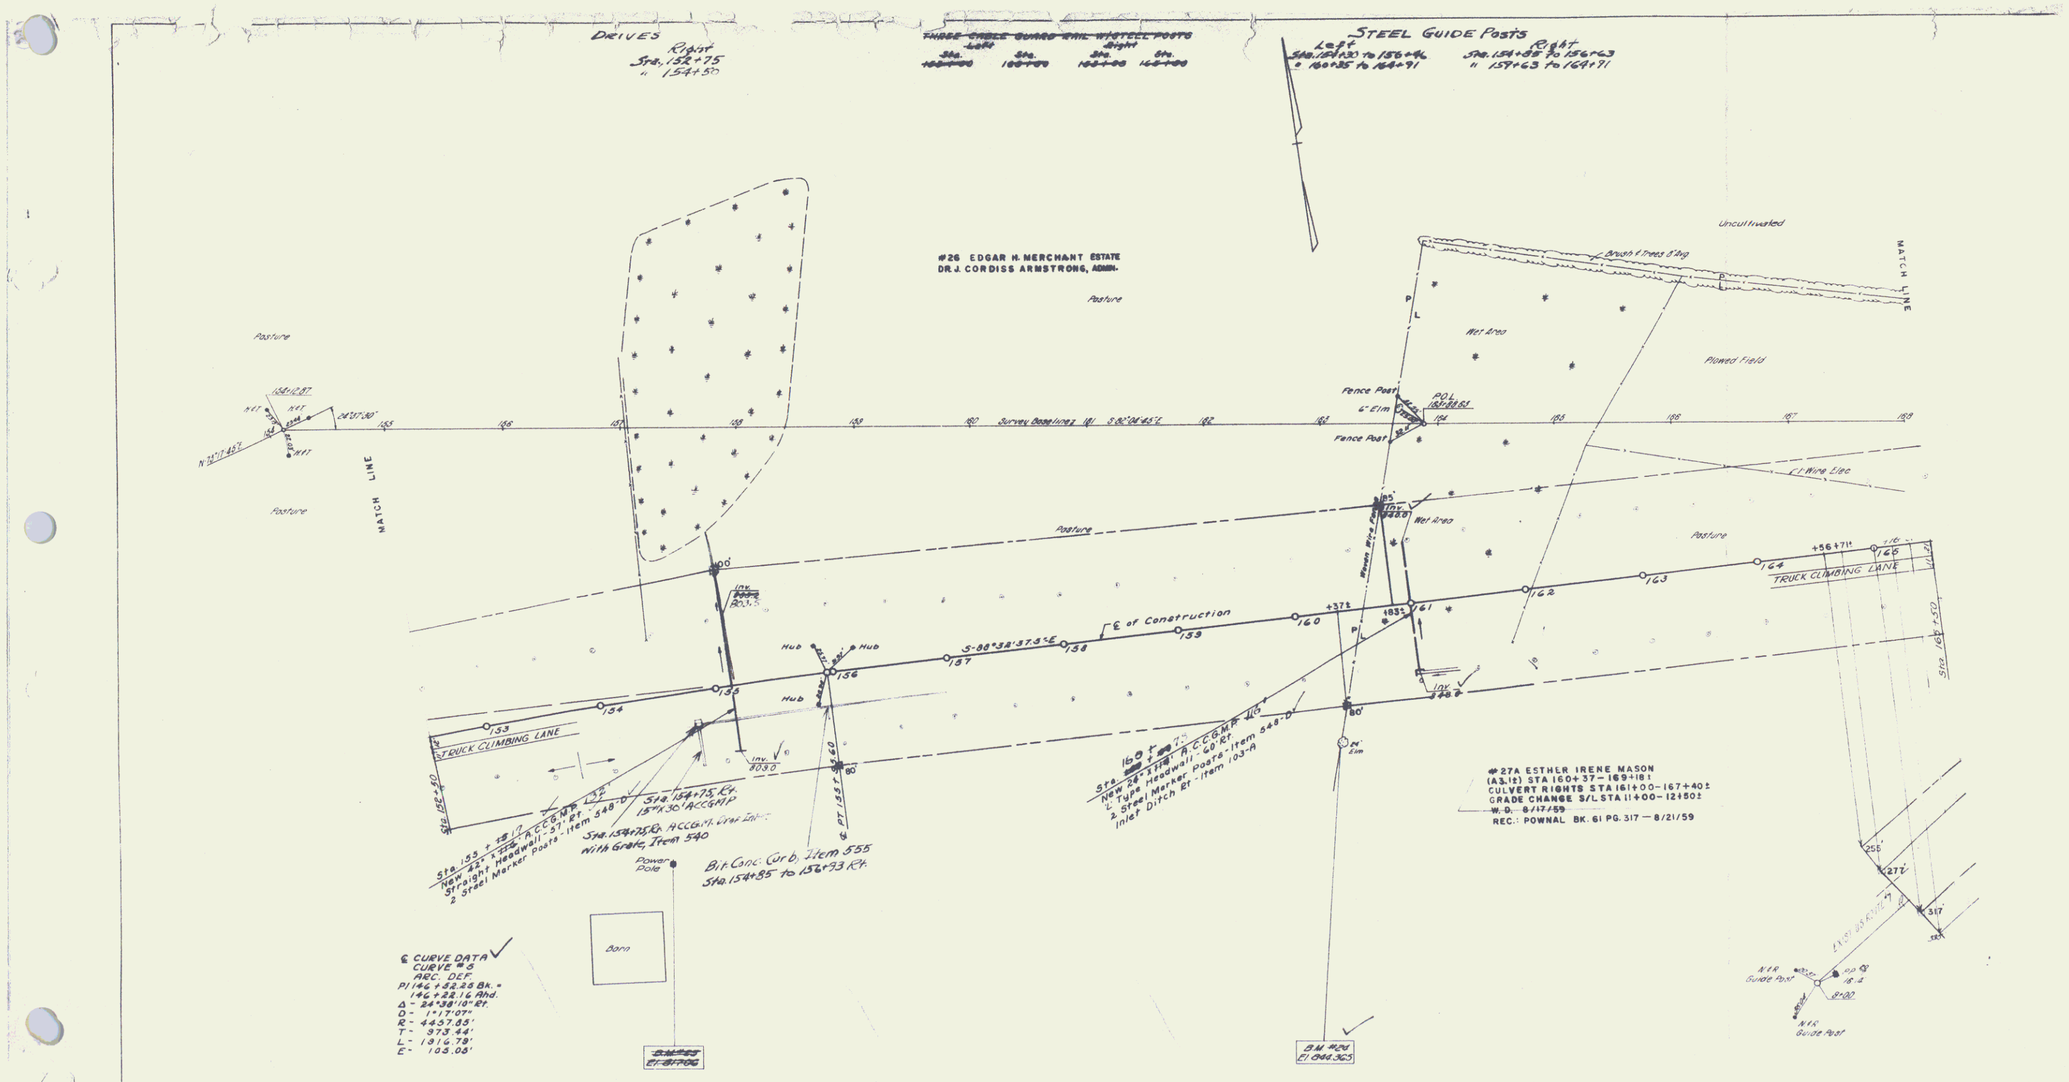
DRIVES
Right
Sta. 152+75
" 154+50
~~THREE CABLE GUARD RAIL W/STEEL POSTS~~
~~Left~~ ~~Right~~
~~Sta. Sta. Sta. Sta.~~
STEEL GUIDE POSTS
Left
Sta. 154+32 to 156+46
" 160+35 to 164+91
Right
Sta. 154+85 to 156+63
" 157+63 to 164+91
#26 EDGAR H. MERCHANT ESTATE
DR. J. CORDISS ARMSTRONG, ADMIN.
Pasture
Uncultivated
Brush & Trees 5' Avg.
MATCH LINE
Wet Area
Plowed Field
Fence Post
6" Elm
POL
Survey Baseline
Fence Post
Wire Elec.
Wet Area
Pasture
TRUCK CLIMBING LANE
℄ of Construction
Hub
Inv.
Power Pole
Barn
Bit. Conc. Curb, Item 555
Sta. 154+85 to 156+93 Rt.
Sta. 154+75 Rt.
15" x 30' ACCGMP
With Grate, Item 540
Sta. 153 + 78 ℄
New 42" x 78" A.C.C.G.M.P. 40' Rt.
Straight Headwall - 51' Rt. - Item 548
2 Steel Marker Posts
Sta. 160 + 77 ℄
New 24" x 44" A.C.C.G.M.P. 40' Rt.
L Type Headwall - 60' Rt.
2 Steel Marker Posts - Item 548
Inlet Ditch Rt. - Item 103-A
#27A ESTHER IRENE MASON
(A3,12) STA 160+37 – 169+18±
CULVERT RIGHTS STA 161+00 – 167+40±
GRADE CHANGE S/L STA 11+00 – 12+50±
W. D. 8/17/59
REC.: POWNAL BK. 61 PG. 317 – 8/21/59
℄ CURVE DATA
CURVE #3
ARC. DEF.
P.I. 146+22.28 Bk. =
146+22.16 Ahd.
Δ - 24°38'10" Rt.
D - 1°17'07"
R - 4457.85'
T - 973.44'
L - 1916.79'
E - 103.08'
B.M. #24 Sta 163100 ℄
R.R. Spike in Root 24" Elm
In Fence Line
Elev. 844.365 - 275' Rt
B.M. #24
El. 844.365
N.R. Guide Post
Elev. 8120 - 325.01
13
ROUTE US 7
TOWN OF POWNAL
PROJECT NO. F 019-1(1)
DRAWN BY
DESIGNED BY
TRACED BY
CHECKED BY
SHEET NO. 31 OF 275