INDEX OF SHEETS

SHEET NO. 1 TITLE PAGE
2 TYPICAL CROSS-SECTION OF IMPROVEMENT 2 1/2" BITUMINOUS CONCRETE PAVEMENT ITEM 301-8 OR 302
3 BANKING AND WIDENING TABLES
4 QUANTITY SHEET (ITEMS)
5 QUANTITY SHEET (DRAINAGE)
6-8 EARTHWORK SHEET
9-15 PLAN AND PROFILE SHEETS
16 CONSTRUCTION DETAILS (DRAINAGE)
17 CONSTRUCTION DETAILS CD1 (DITCHES)
18 CONSTRUCTION DETAILS CD 2 (TYPICAL GRADING)
19 CONSTRUCTION DETAILS CD 4 (GRANITE CURB)
20 STANDARD STRUCTURE SHEET S-40 (BARRICADES, SIGNS & LIGHTS)
21 STANDARD STRUCTURE SHEET S 46-48 (GUARD RAIL)
22 STANDARD STRUCTURE SHEET S 47-48 (DROP INLETS)
23 STANDARD STRUCTURE SHEET S 52-48 (PRECAST DROP INLETS)
24-30 CROSS SECTIONS

STANDARD STRUCTURE SHEET APPROVED BY THE CHIEF ENGINEER, VERMONT STATE DEPARTMENT OF HIGHWAYS

S-40 JUNE 10, 1950

STATE OF VERMONT
DEPARTMENT OF HIGHWAYS

PROPOSED IMPROVEMENT

FEDERAL PROJECT

TOWN OF POWNAL Pin #99R529

COUNTY OF BENNINGTON

U.S. ROUTE 7

WILLIAMSTOWN MASS.—BENNINGTON ROAD

BEGINNING AT THE MASSACHUSETTS-VERMONT STATE LINE AND EXTENDING NORTHERLY 6,652.4 FEET.

LENGTH OF PROJECT 6,652.4 FT. = 1.26 MILES

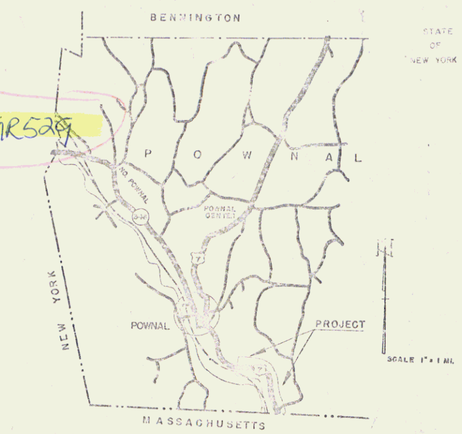

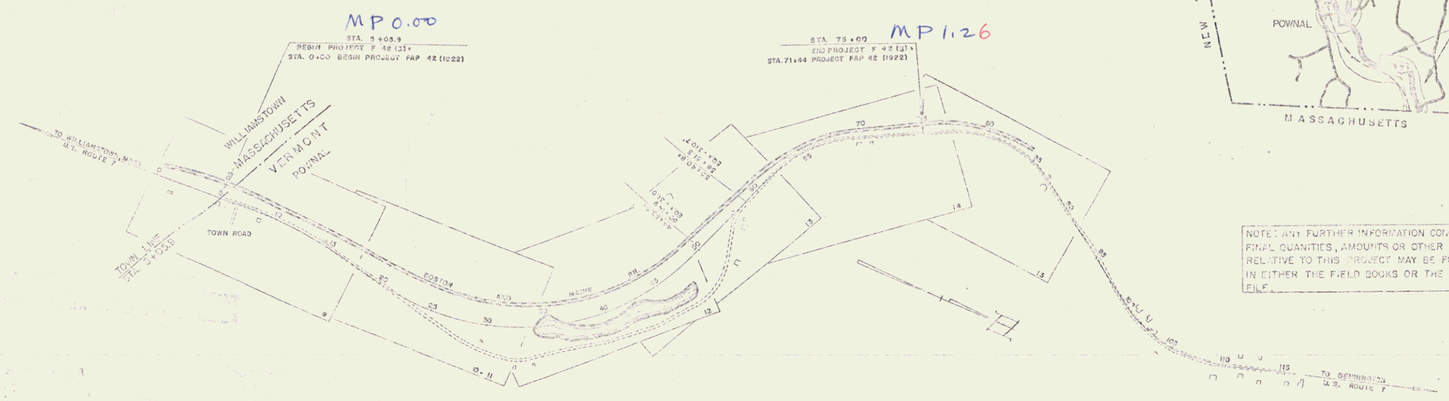

NOTE: ANY FURTHER INFORMATION CONCERNING FINAL QUANTITIES, AMOUNTS OR OTHER DETAILS RELATIVE TO THIS PROJECT MAY BE FOUND IN EITHER THE FIELD BOOKS OR THE ESTIMATE FILE.

PROJECT NAME AND NUMBER	TYPE	PAVEMENT AREA
POWNAL F 42 (3)	BIT. CONC. PAV.	19,500

RECORD PLANS

MATERIALS

SUB-BASE OF GRAVEL LOCAL, HARTE PIT	TAR SOCONY VACUUM, E. PROVIDENCE, R.I.
SUB-BASE OF CR GRAVEL LOCAL, HINMAN	R.C.P. VERMONT CONC. PIPE CORP. WINDSOR, VT.
STAB. GRAVEL BASE HINMAN HOT MIX PLANT	ACCOMP. NEW ENGLAND METAL PIPE CO. PALMER, MASS.
BITUMINOUS CONCRETE HINMAN HOT MIX PL.	C.G. RAIL CABLE AM STEEL & WIRE CO. N. HAVEN, C.
ASPHALT SOCONY VACUUM, E. PROVIDENCE, R.I.	GRANITE CURB CHELMSFORD, MASS.

CONTRACTOR W.H. HINMAN, INC.	CONTRACT DATED AUG. 8, 1952
REG. ENGINEER THOMAS L. DUDLEY	CONTRACT STARTED AUGUST 8, 1952
INSPECTOR	CONTRACT COMPLETED JULY 7, 1953
RECORD PLANS BY L. DUDLEY - J.M. TURNER	CONTRACT ACCEPTED

RIGHT-OF-WAY DIVISION
TOWN FILE
PERPETUAL
Rte ~~Town of~~ US7
(To Be Returned To R.O.W. Division)

DEPARTMENT OF COMMERCE
BUREAU OF PUBLIC ROADS

F 42 (3)

~~STEARNS R. JENKINS~~

US7

US 7