F.D. ROAD DIST. NO.	STATE	PROJ. NO.	FISCAL YEAR	SHEET NO.	TOTAL SHEETS
9	VT.				

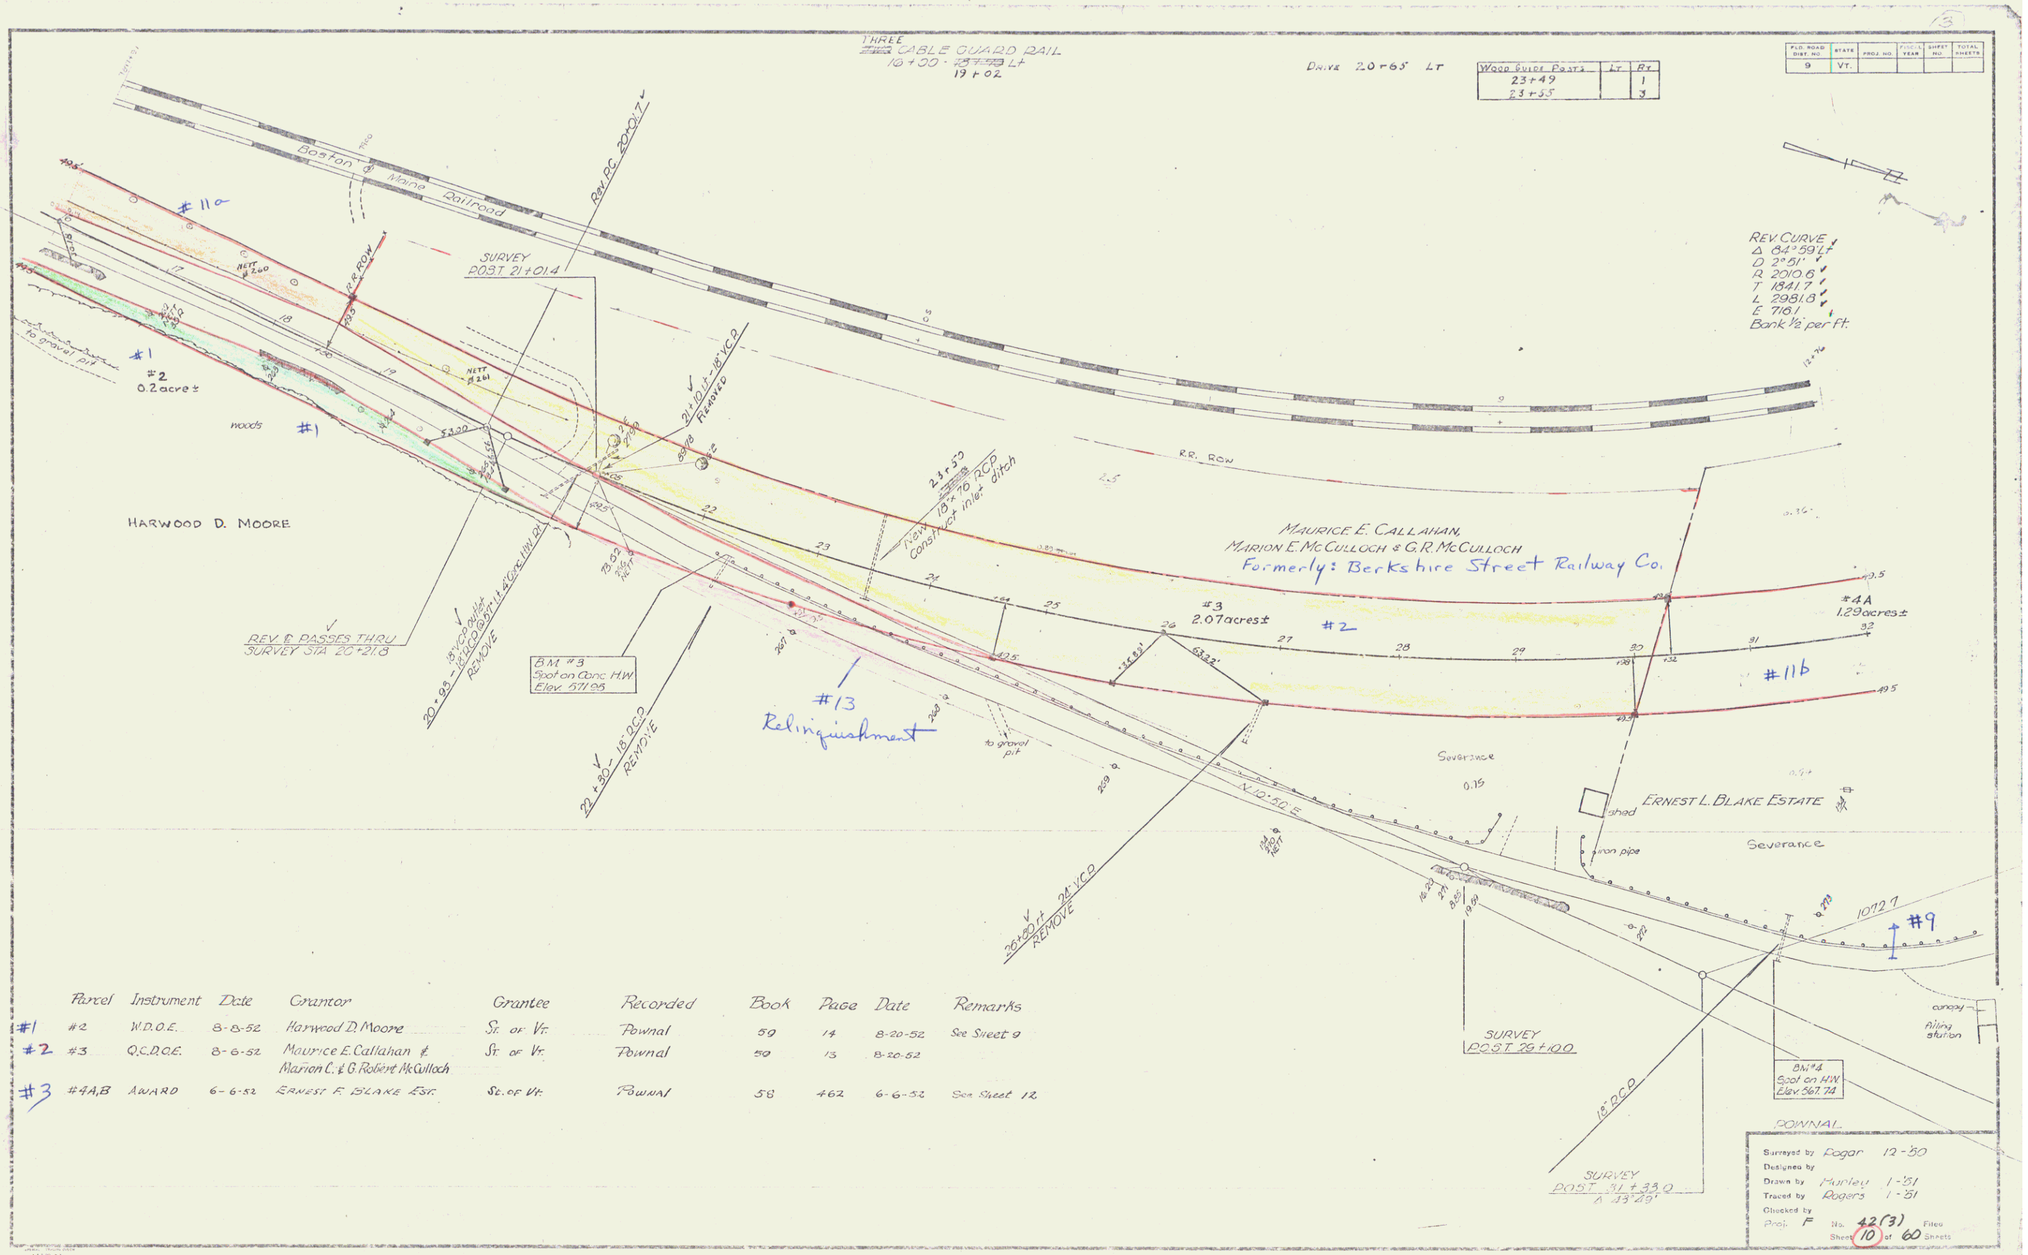

	Parcel	Instrument	Date	Grantor	Grantee	Recorded	Book	Page	Date	Remarks
#1	#2	W.D.O.E.	8-8-52	Harwood D. Moore	St. of Vt.	Pownal	50	14	8-20-52	See Sheet 9
#2	#3	Q.C.D.O.E.	8-6-52	Maurice E. Callahan & Marion C. & G. Robert McCulloch	St. of Vt.	Pownal	50	13	8-20-52	
#3	#4A,B	AWARD	6-6-52	ERNEST F. BLAKE EST.	St. of Vt.	Pownal	58	462	6-6-52	See Sheet 12

Surveyed by Rogar 12-'50
Designed by
Drawn by Hurley 1-'51
Traced by Rogers 1-'51
Checked by
Proj. F No. 42(3) Files
Sheet 10 of 60 Sheets

3