PARCEL	INSTRUMENT	DATE	GRANTOR	GRANTEE	RECORDED BERLIN BOOK	PAGE	DATE	REMARKS

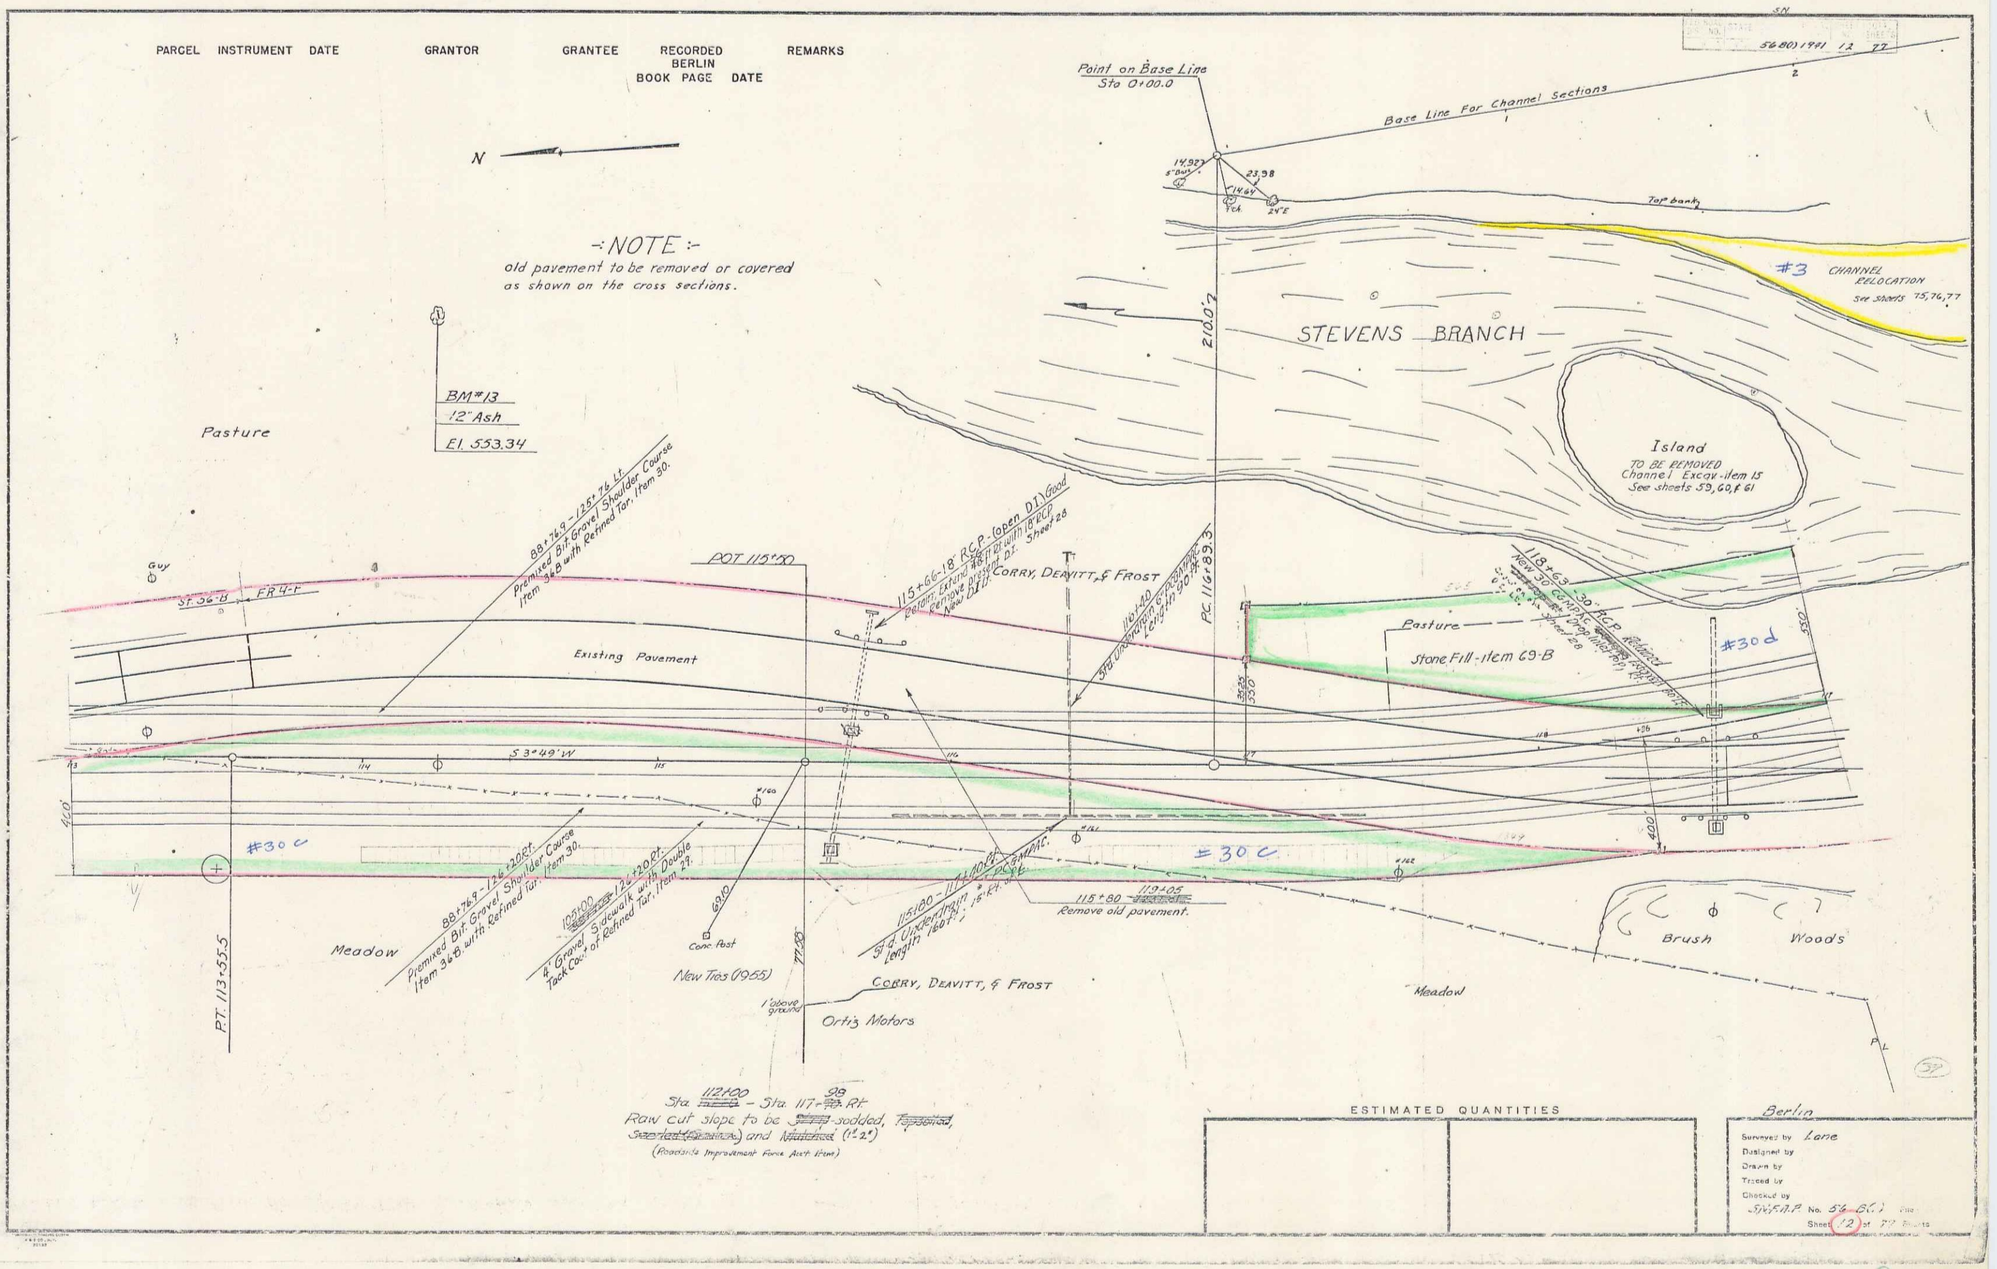

9