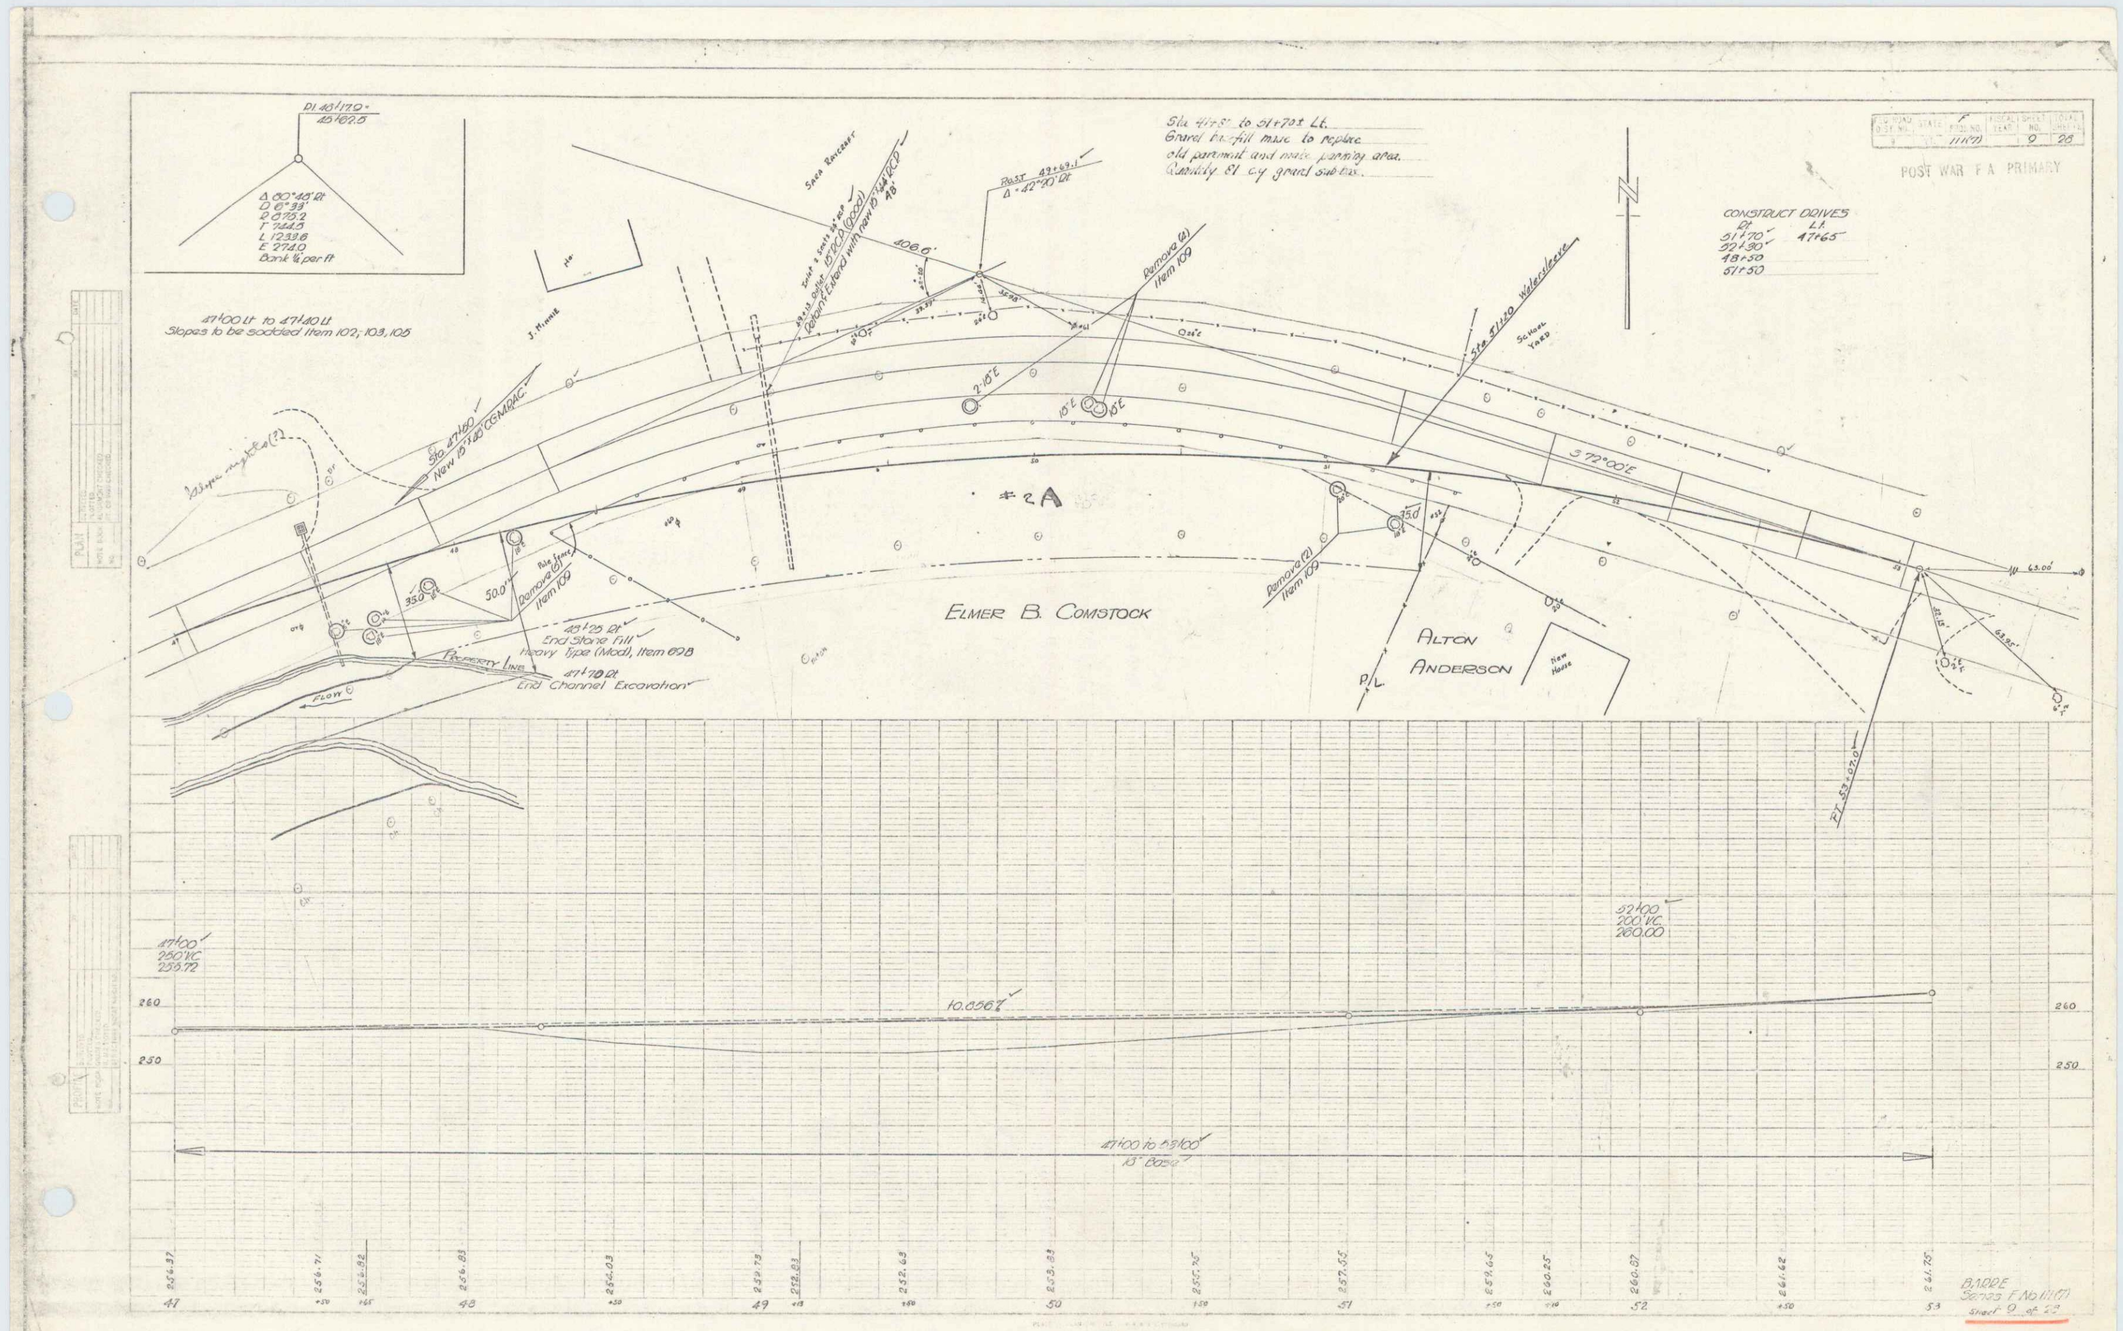
POST WAR F.A. PRIMARY
Sta 47+81 to 51+70± Lt.
Gravel ex-fill mix to replace
old pavement and make parking area.
Quantity 81 c.y. gravel sub-base.
CONSTRUCT DRIVES
Rt. Lt.
51+70 47+65
52+90
48+50
51+50
PI. 48+170
Δ 80°45' Rt
D 6°38'
R 873.2
T 744.5
L 1233.8
E 277.0
Bank % per ft
47+00 Lt. to 47+40 Lt.
Slopes to be sodded Item 102, 103, 105
Sta. 47+60
New 15"x30" CGMPAC
Remove (2) Item 109
Sta. 51+20 Widen Culvert
Δ 72°00'E
#2A
ELMER B. COMSTOCK
ALTON ANDERSON
P/L
New House
Remove Fence
Remove (2) Item 109
End Stone Fill
Heavy Type (Mod), Item 698
End Channel Excavation
PROPERTY LINE
FLOW
J. Minnie
47+00
250.72 VC
250.72
52+00
10.856%
47+00 to 53+00
18" Base
BARRE

4