FED. ROAD DIST. NO.	STATE	F PROJ. NO.	FISCAL YEAR	SHEET NO	TOTAL SHEETS
3	VT.	111(7)		10	28

POST WAR F.A. PRIMARY

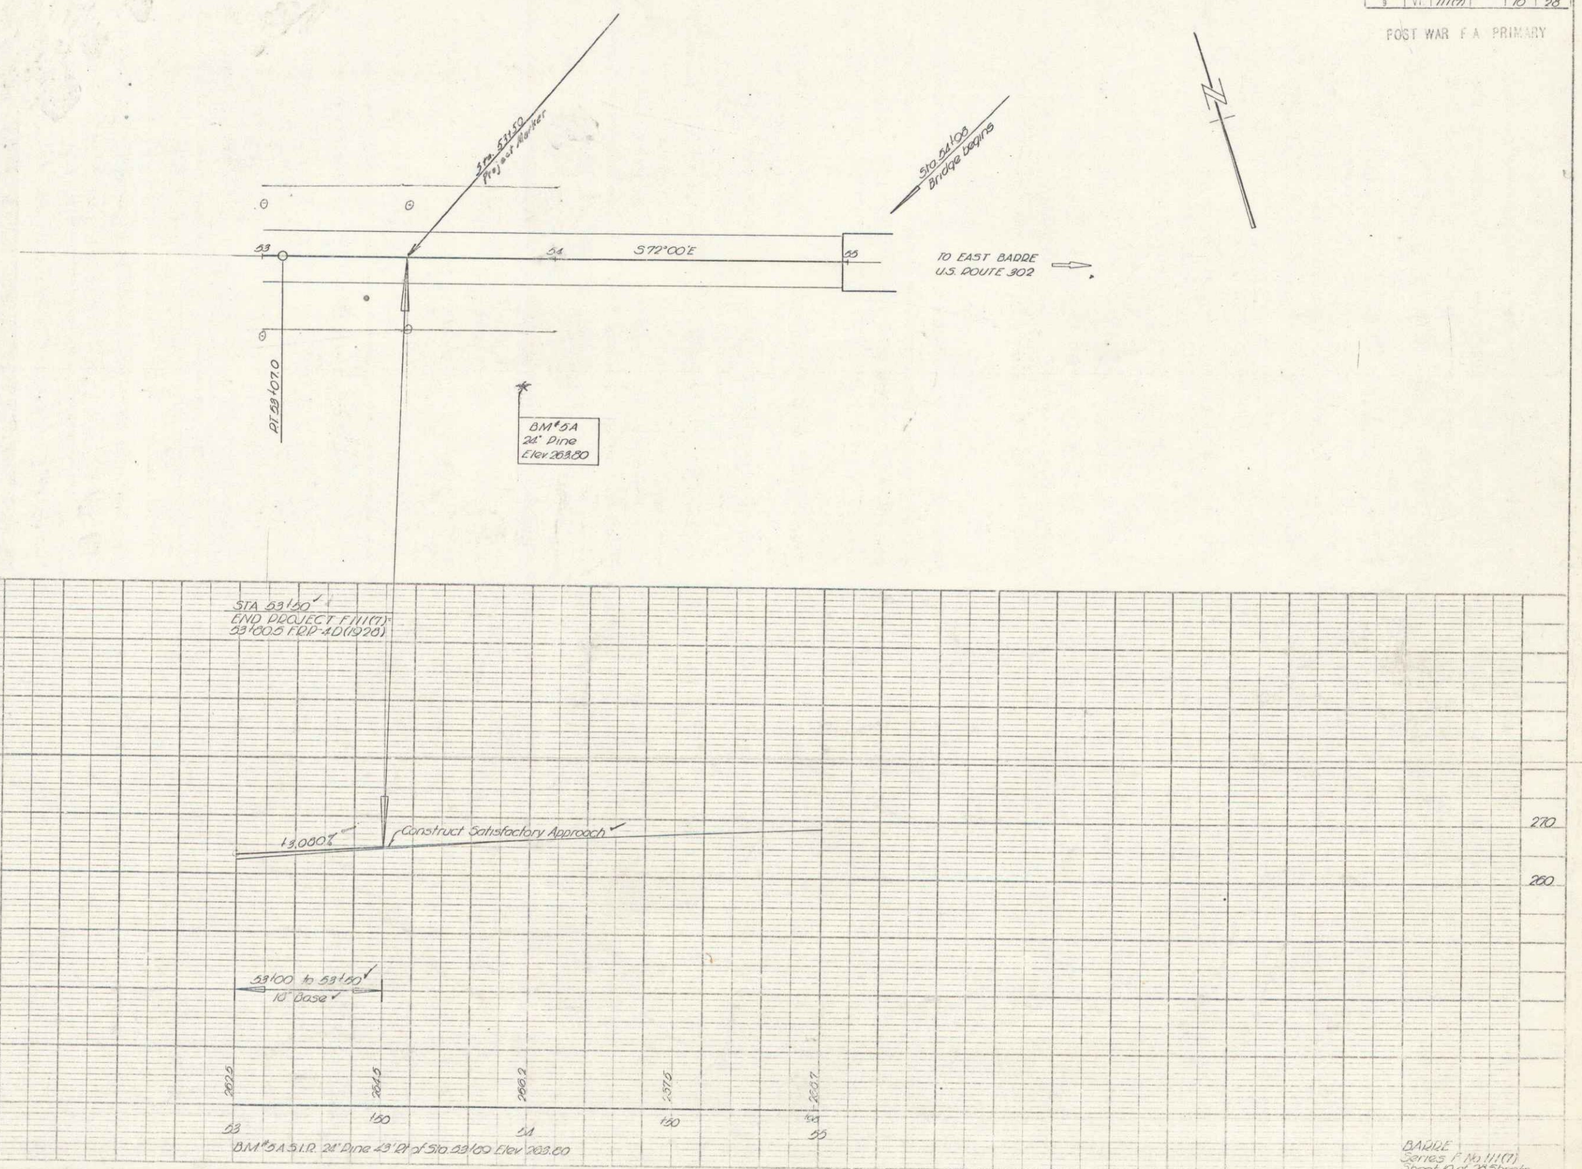

BARRE
Series F No. 111(7)
Sheet 10 of 28 Sheets

5