TOWN OF BARRE
COUNTY OF WASHINGTON
U.S. ROUTE 302
BARRE-EAST BARRE ROAD
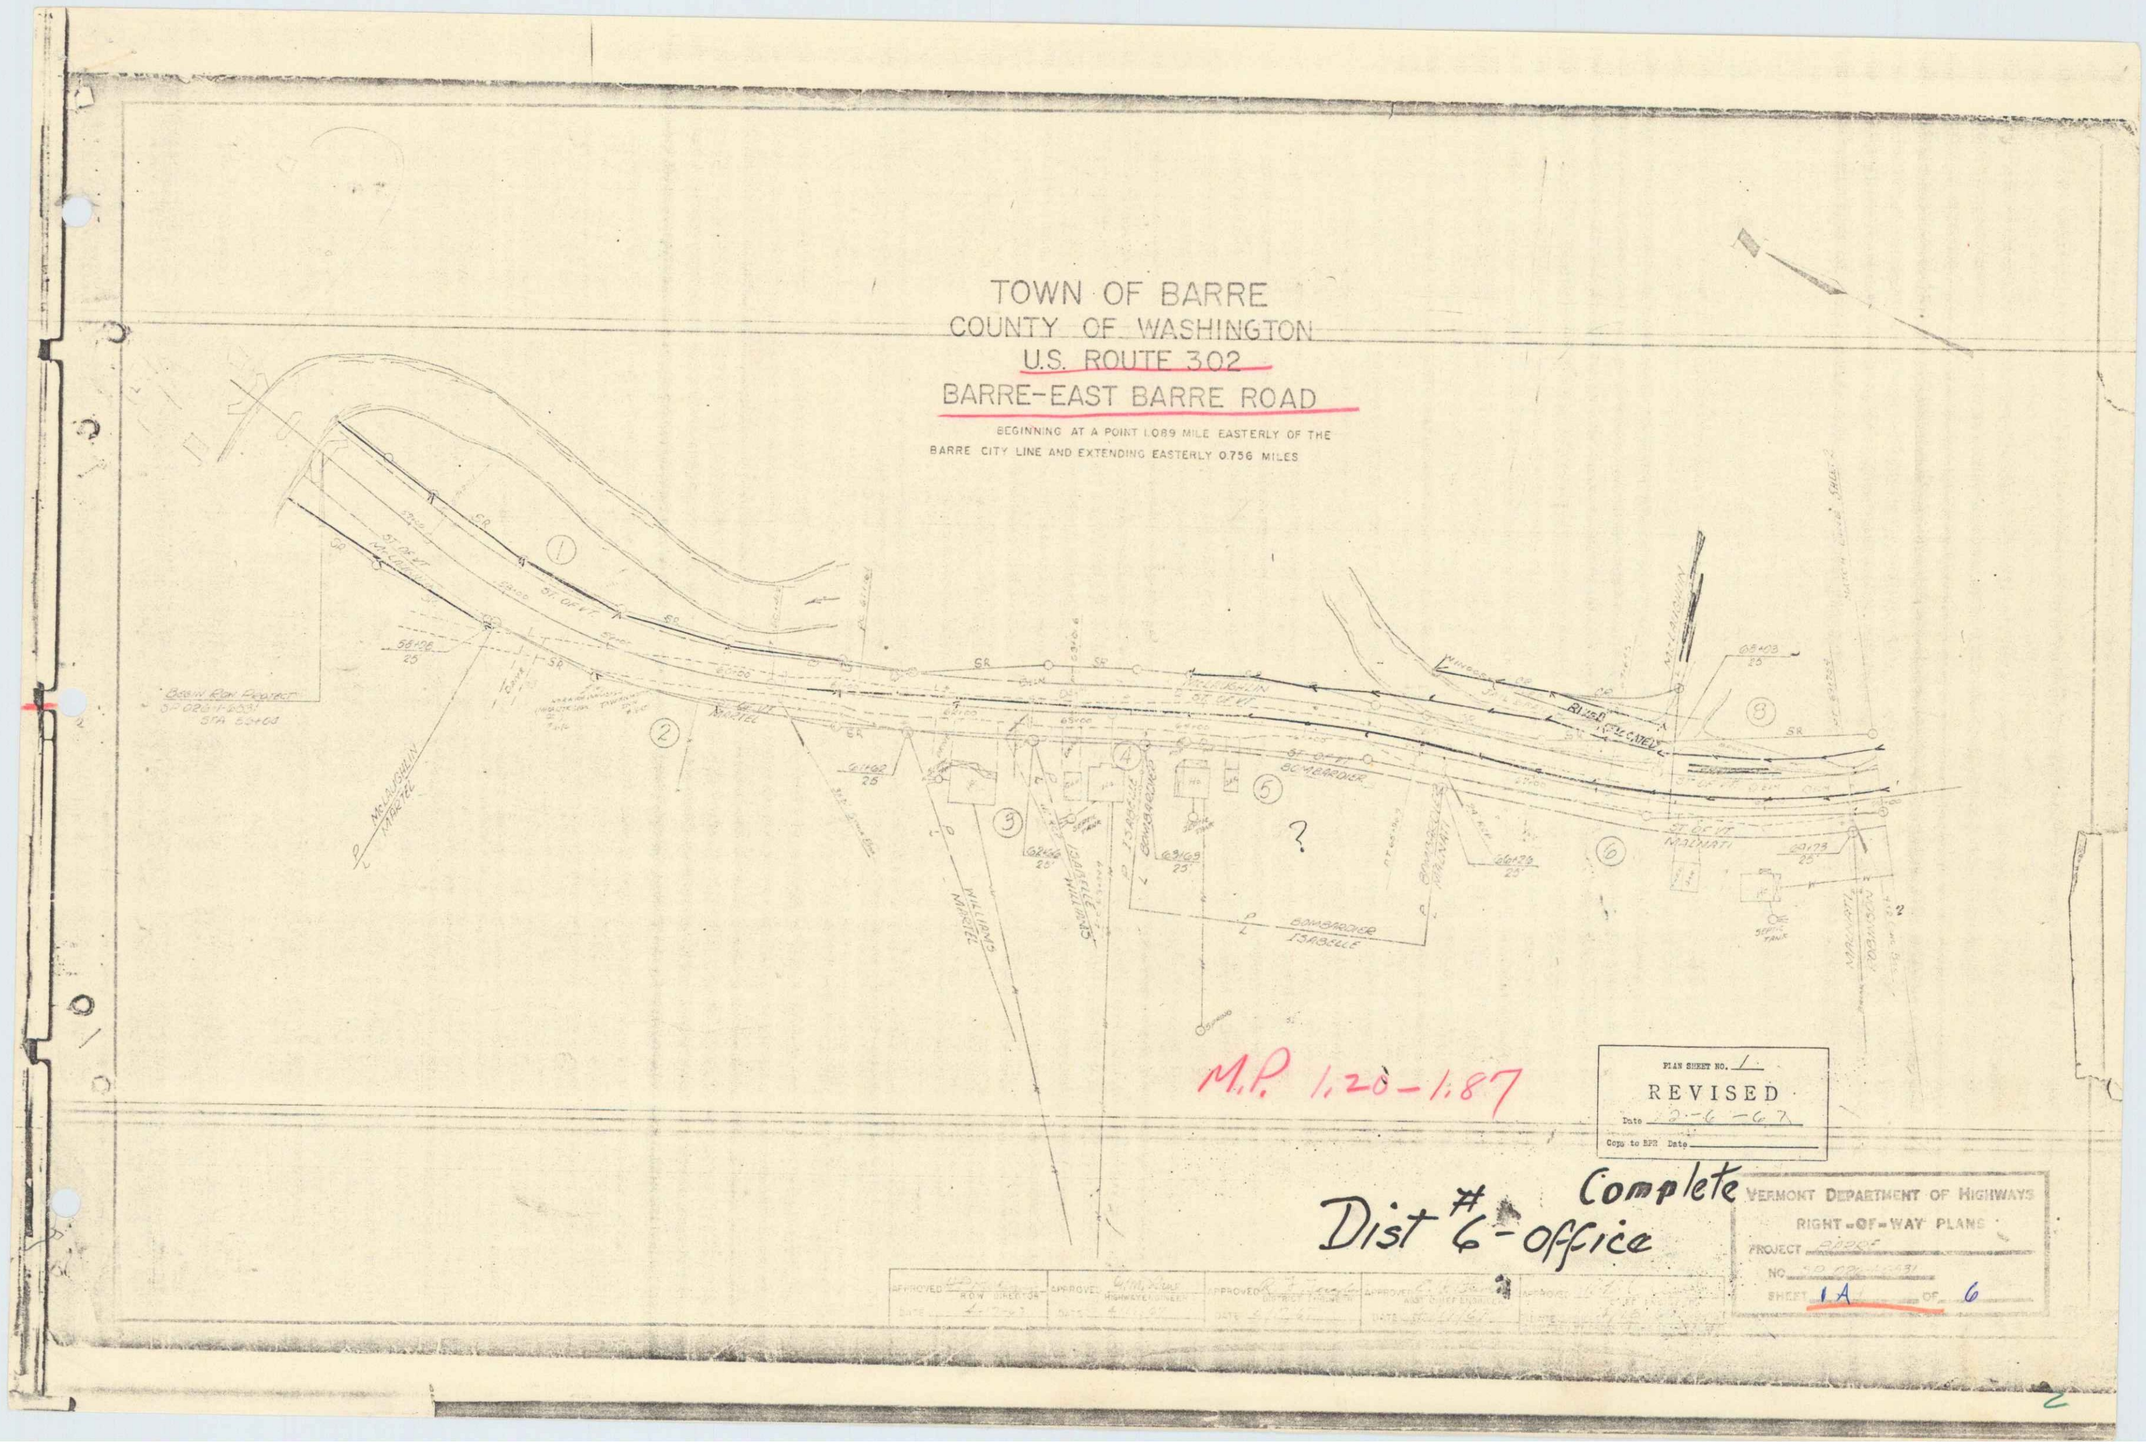
BEGINNING AT A POINT 1.089 MILE EASTERLY OF THE BARRE CITY LINE AND EXTENDING EASTERLY 0.756 MILES