Guard Rail, Std St Beam w/St Posts (6'-3" Spacing) Type I
57+00' - 57+70 RT
57+00 - 59+85 LT

SURVEY DATA
Δ 37° 22' Lt
Dc 9° Lt
Rc 636.62'
Ls 150'
θs 6°45' Lt
Δc 23°52'
Es 37.0'

REV. DATA
Δ 37° 22' Lt
Dc 10° Lt
Rc 572.96
Ls 200
θ 10°
Δc 17°22'
LT 138.55
ST 66.86
Y 11.61'
Es 35.0'
Bank .052' per ft.

Sand Borrow
57+00' 1+40

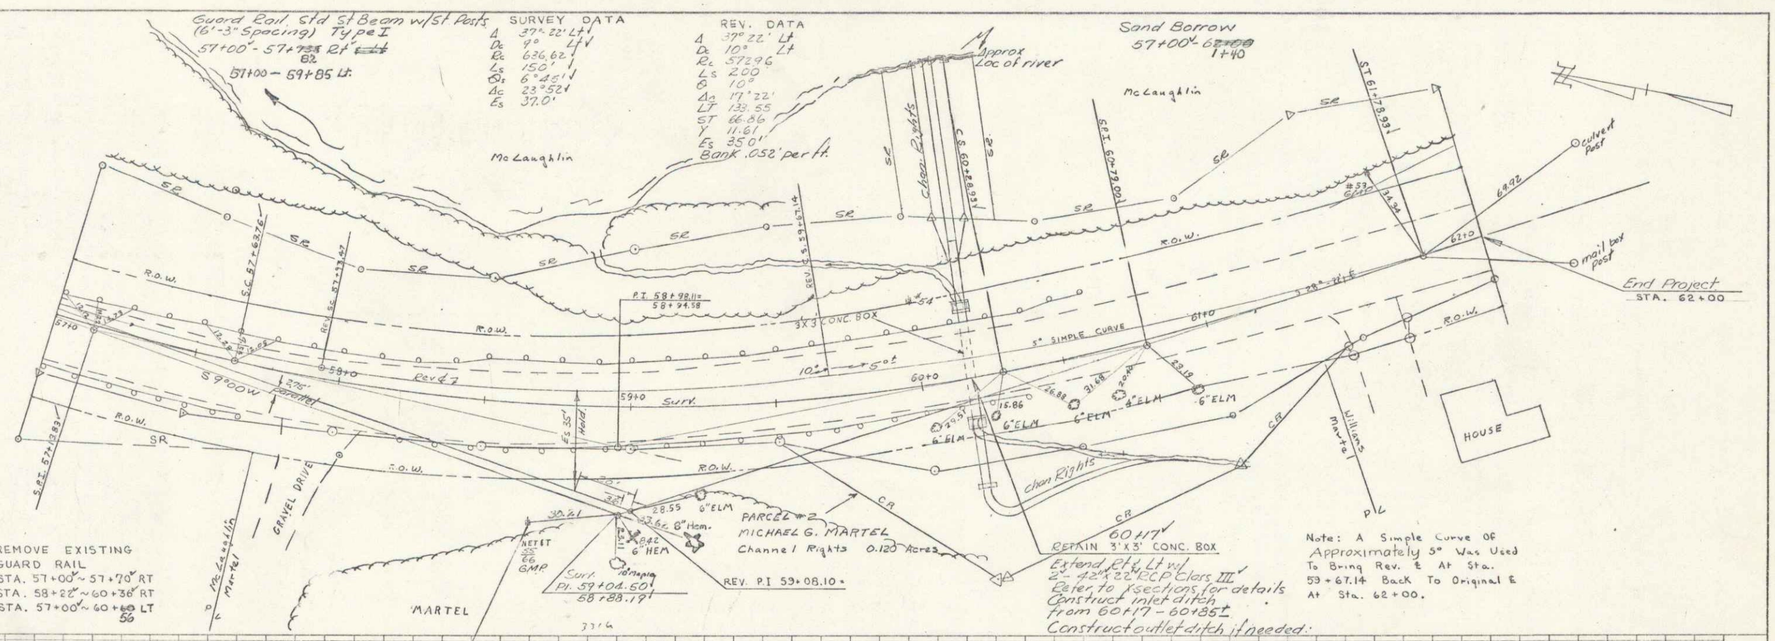

REMOVE EXISTING GUARD RAIL
STA. 57+00' ~ 57+70' RT
STA. 58+22' ~ 60+36' RT
STA. 57+00' ~ 60+56 LT

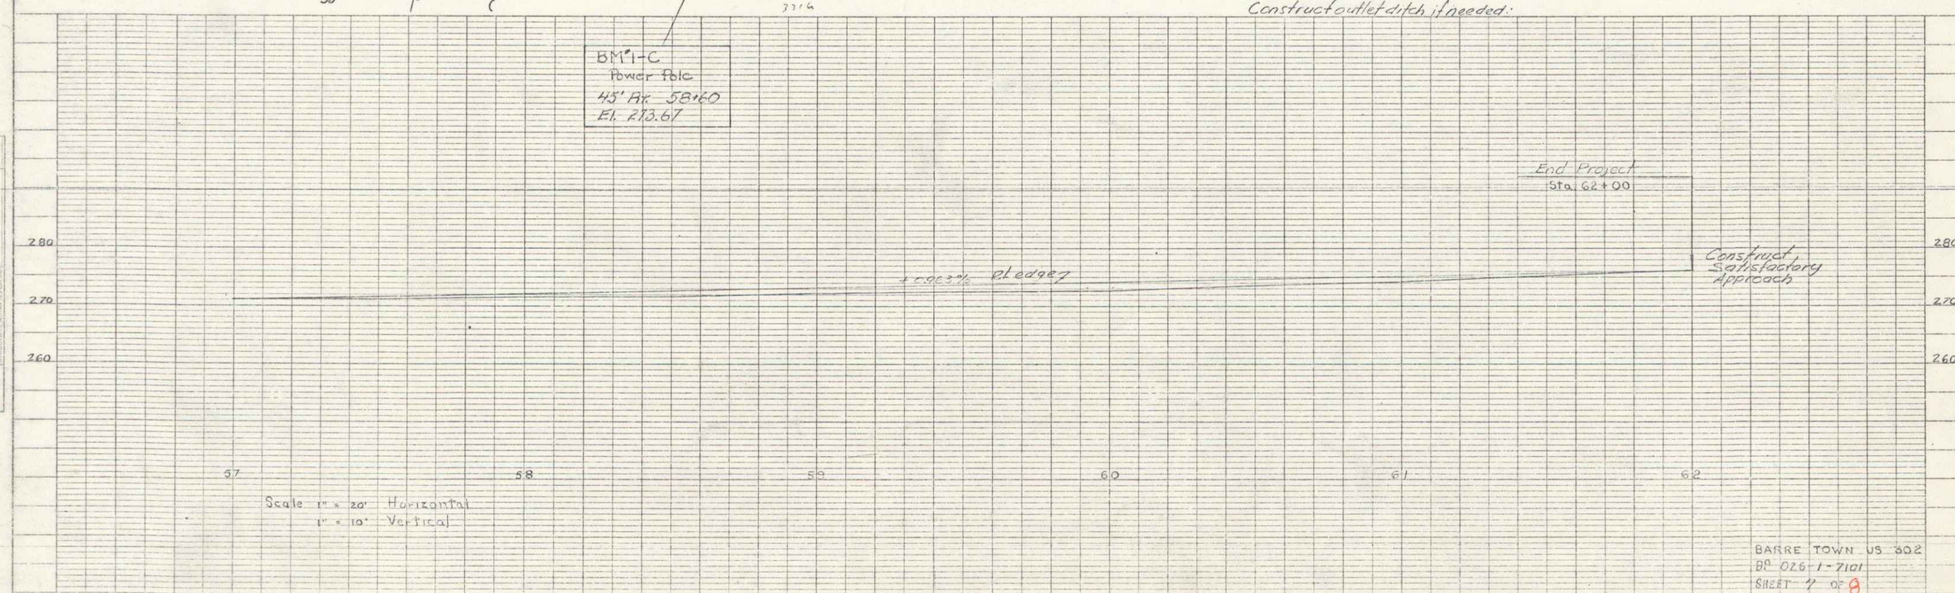

Scale 1" = 20' Horizontal
1" = 10' Vertical

BARRE TOWN US 302
BR 026-1-7101
SHEET 7 OF 8


3