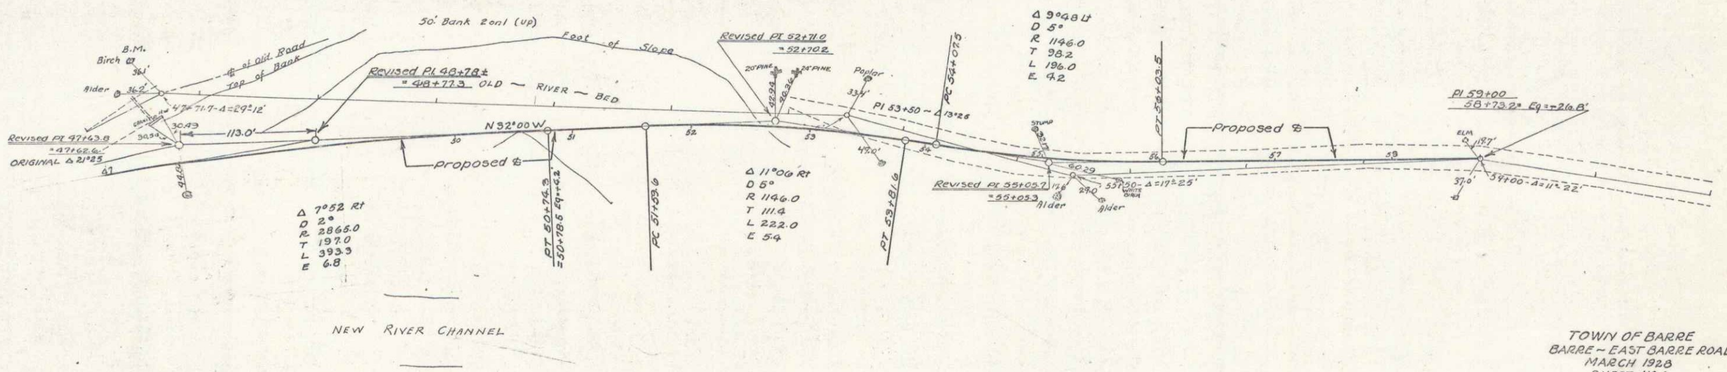

TOWN OF BARRE
BARRE - EAST BARRE ROAD
MARCH 1928
SHEET NO 4

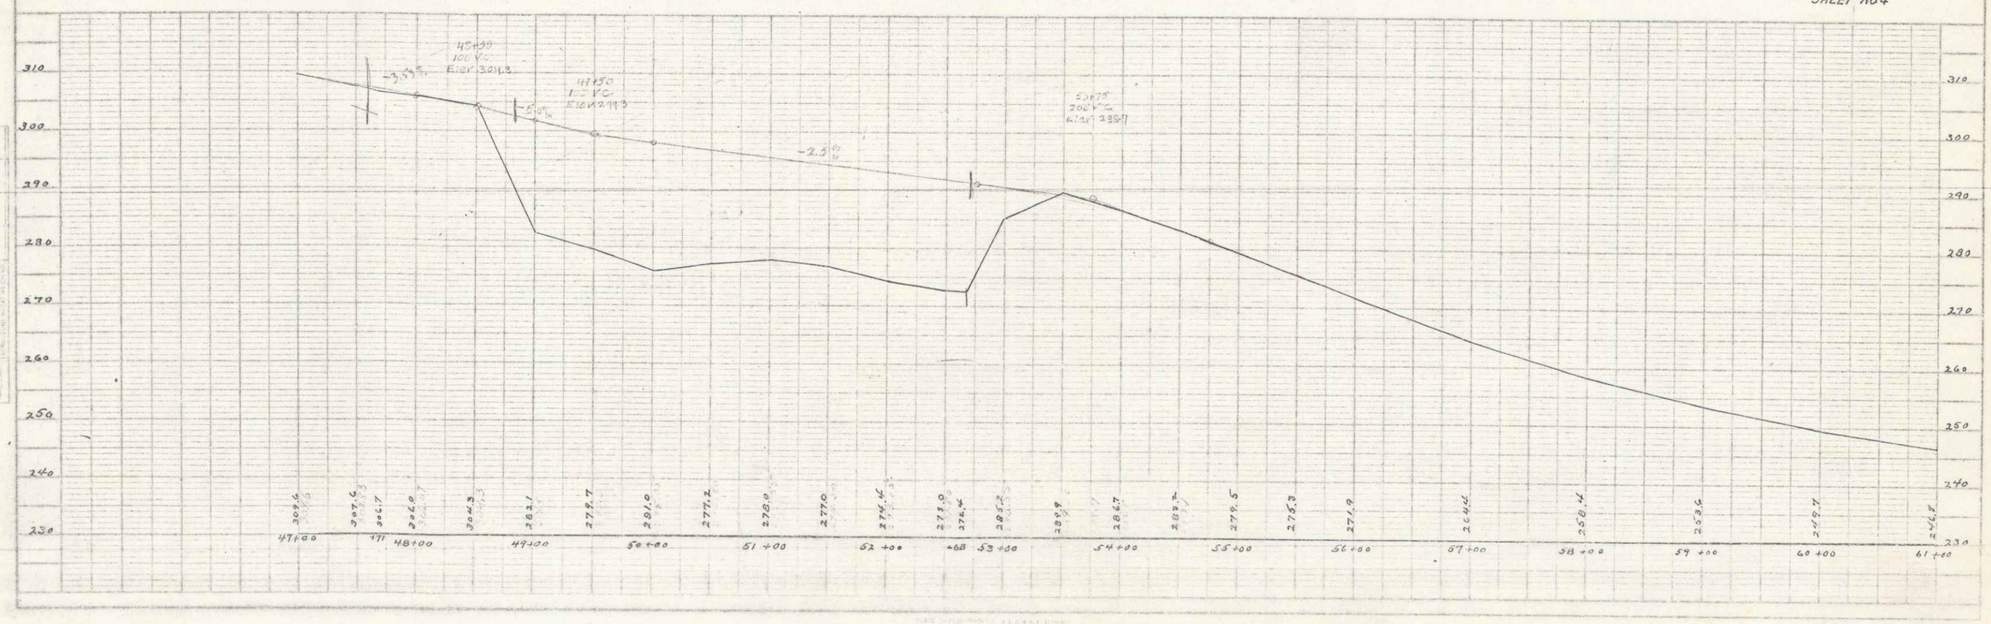

SHEET NO 4 4