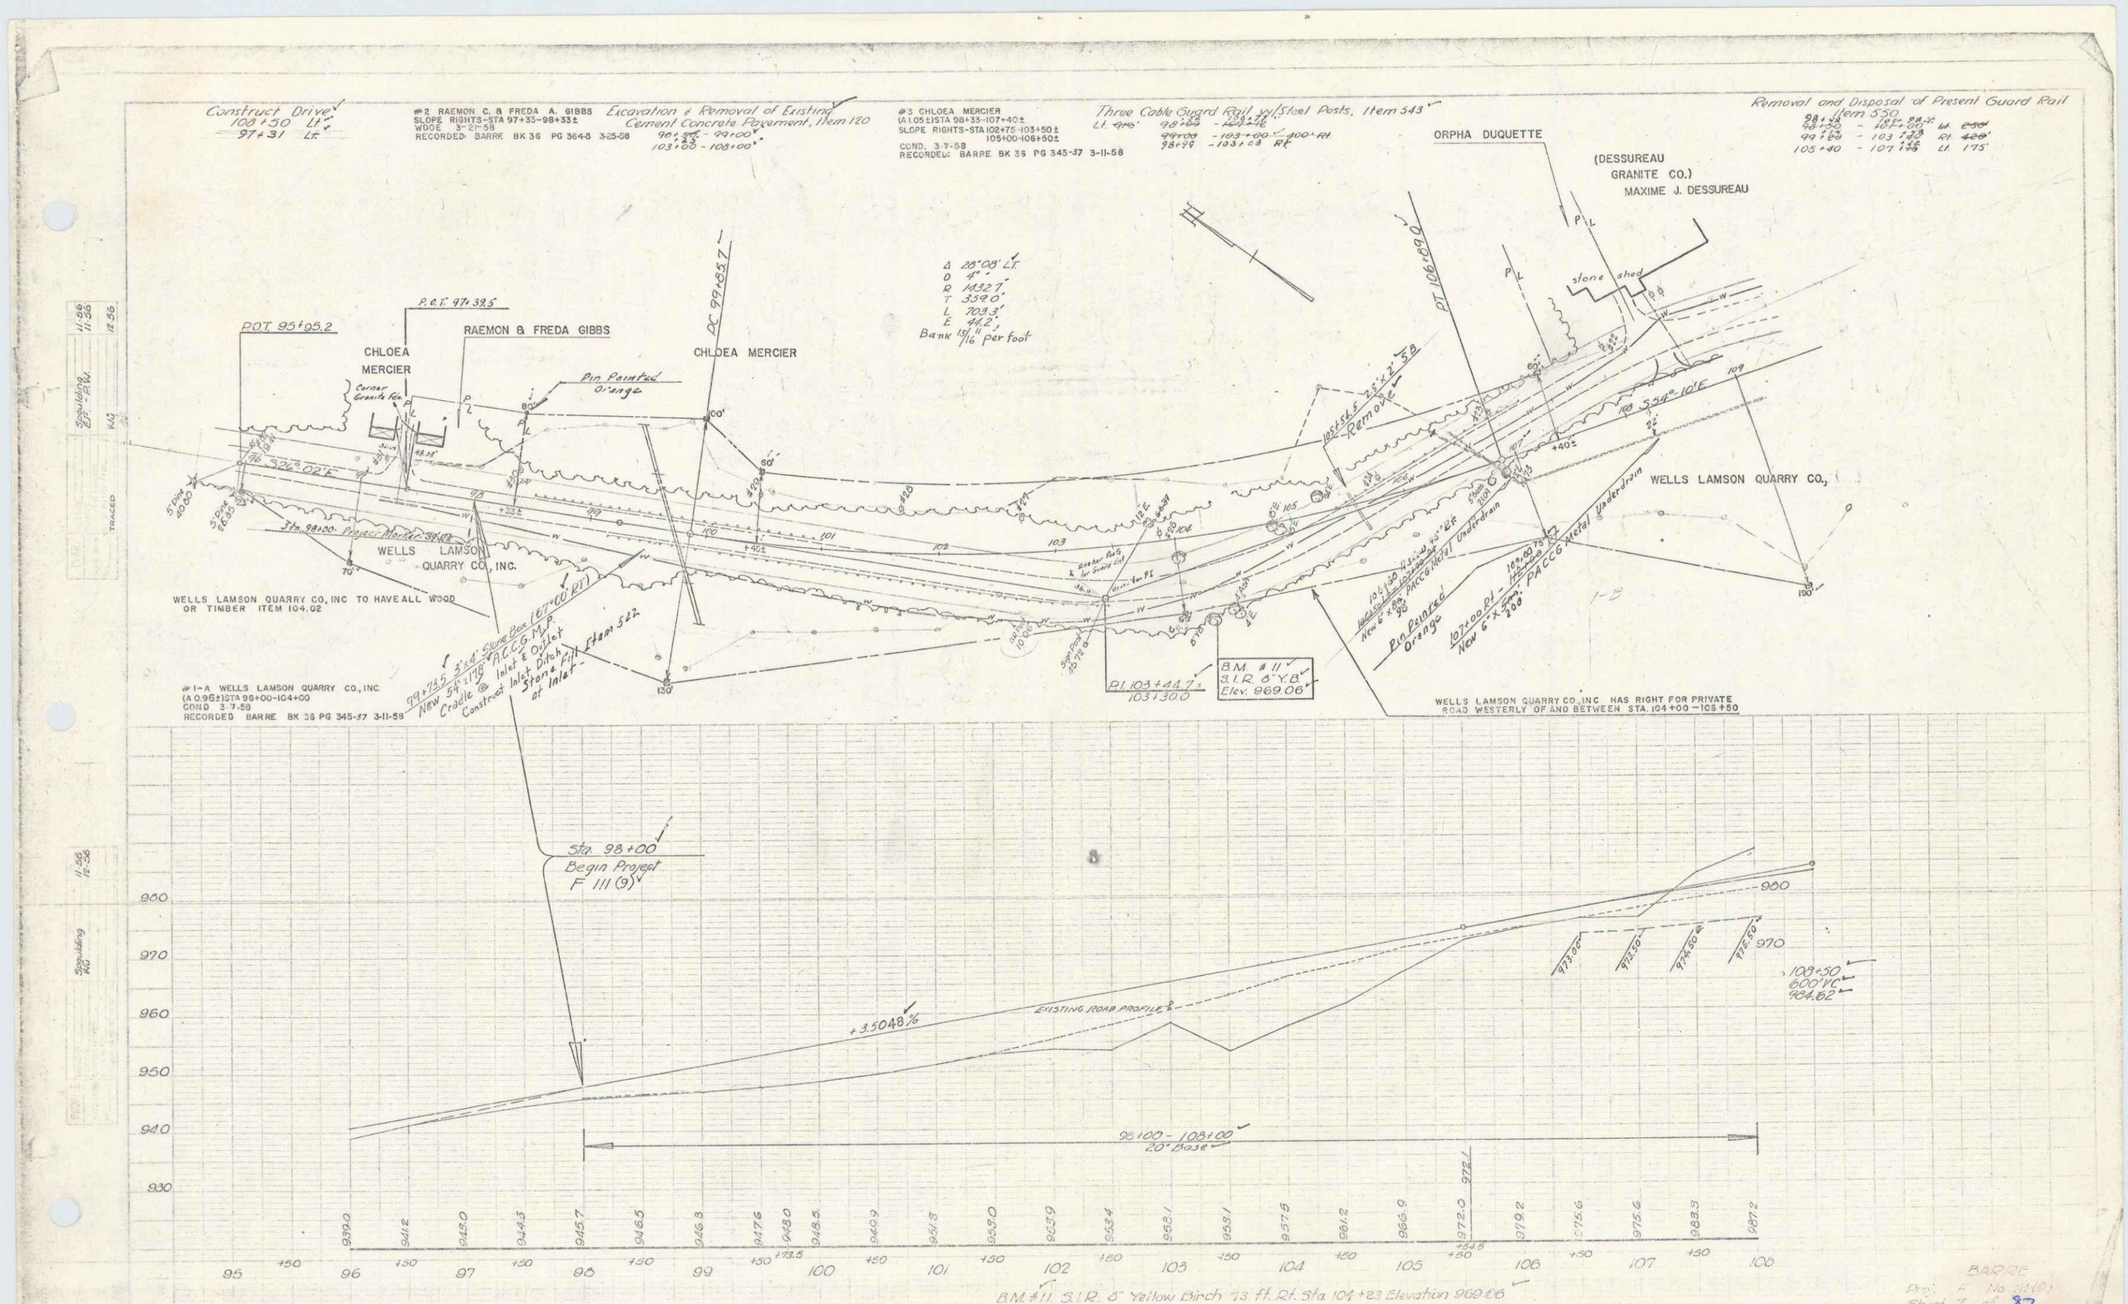
Construct Drive 108+50 Lt. 97+31 Lt.
#2 RAEMON C. & FREDA A. GIBBS
SLOPE RIGHTS-STA 97+33-98+33±
WIDE 3-2-58
RECORDED BARRE BK 36 PG 364-5 3-25-58
Excavation & Removal of Existing Cement Concrete Pavement, Item 120
90+00 - 99+00
103+00 - 108+00
#3 CHLOEA MERCIER
(A 1.05±) STA 98+33-107+40±
SLOPE RIGHTS-STA 102+75-103+50±
105+00-106+50±
COND. 3-7-58
RECORDED: BARRE BK 36 PG 345-57 3-11-58
Three Cable Guard Rail w/Steel Posts, Item 543
Removal and Disposal of Present Guard Rail Item 550
ORPHA DUQUETTE
(DESSUREAU GRANITE CO.)
MAXIME J. DESSUREAU
stone shed
Δ 28°08' Lt.
D 4°
R 1432.7'
T 359.0'
L 703.3'
E 44.2'
Bank 1 15/16" per foot
P.O.T. 95+05.2
P.C.T. 97+32.5
CHLOEA MERCIER
RAEMON & FREDA GIBBS
Pin Painted Orange
PC 99+85.7
PT 106+69.2
Remove
WELLS LAMSON QUARRY CO., INC.
WELLS LAMSON QUARRY CO.,
WELLS LAMSON QUARRY CO. INC TO HAVE ALL WOOD OR TIMBER ITEM 104.02
Sta. 98+00 Project Marker
99+73.5 3'x4' Stone Box (67+00 PT)
New 54" x 119' PACCG Pipe
Cradle @ Inlet & Outlet
Construct Inlet Ditch & Stone Fill Item 542 at Inlet
#1-A WELLS LAMSON QUARRY CO., INC.
(A 0.95±) STA 96+00-104+00
COND 3-7-58
RECORDED BARRE BK 36 PG 345-57 3-11-58
PI 103+44.7 = 1031+30.0
B.M. #11 S.I.R. 8" Y.B. Elev. 969.06
Pin Painted Orange
107+00 Rt. - 102+00 Lt.
Nov 6 x 50' PACCG Metal Underdrain
WELLS LAMSON QUARRY CO., INC HAS RIGHT FOR PRIVATE ROAD WESTERLY OF AND BETWEEN STA. 104+00 - 105+50
Sta. 98+00 Begin Project F 111(9)
+3.5048%
EXISTING ROAD PROFILE
98+00 - 108+00 20' Base
108+50 600' VC 984.82
939.0 941.2 943.0 944.3 945.7 946.5 946.8 947.6 948.0 948.5 949.9 951.3 952.0 953.9 954.4 956.1 957.5 961.2 966.9 972.0 979.2 975.6 975.6 983.3 987.2
95 96 97 98 99 100 101 102 103 104 105 106 107 108
B.M. #11 S.I.R. 8" Yellow Birch 13 ft. Rt. Sta. 104+23 Elevation 969.06
BARRE
Proj. F No. 111(9)
Sheet 7 of 87
2