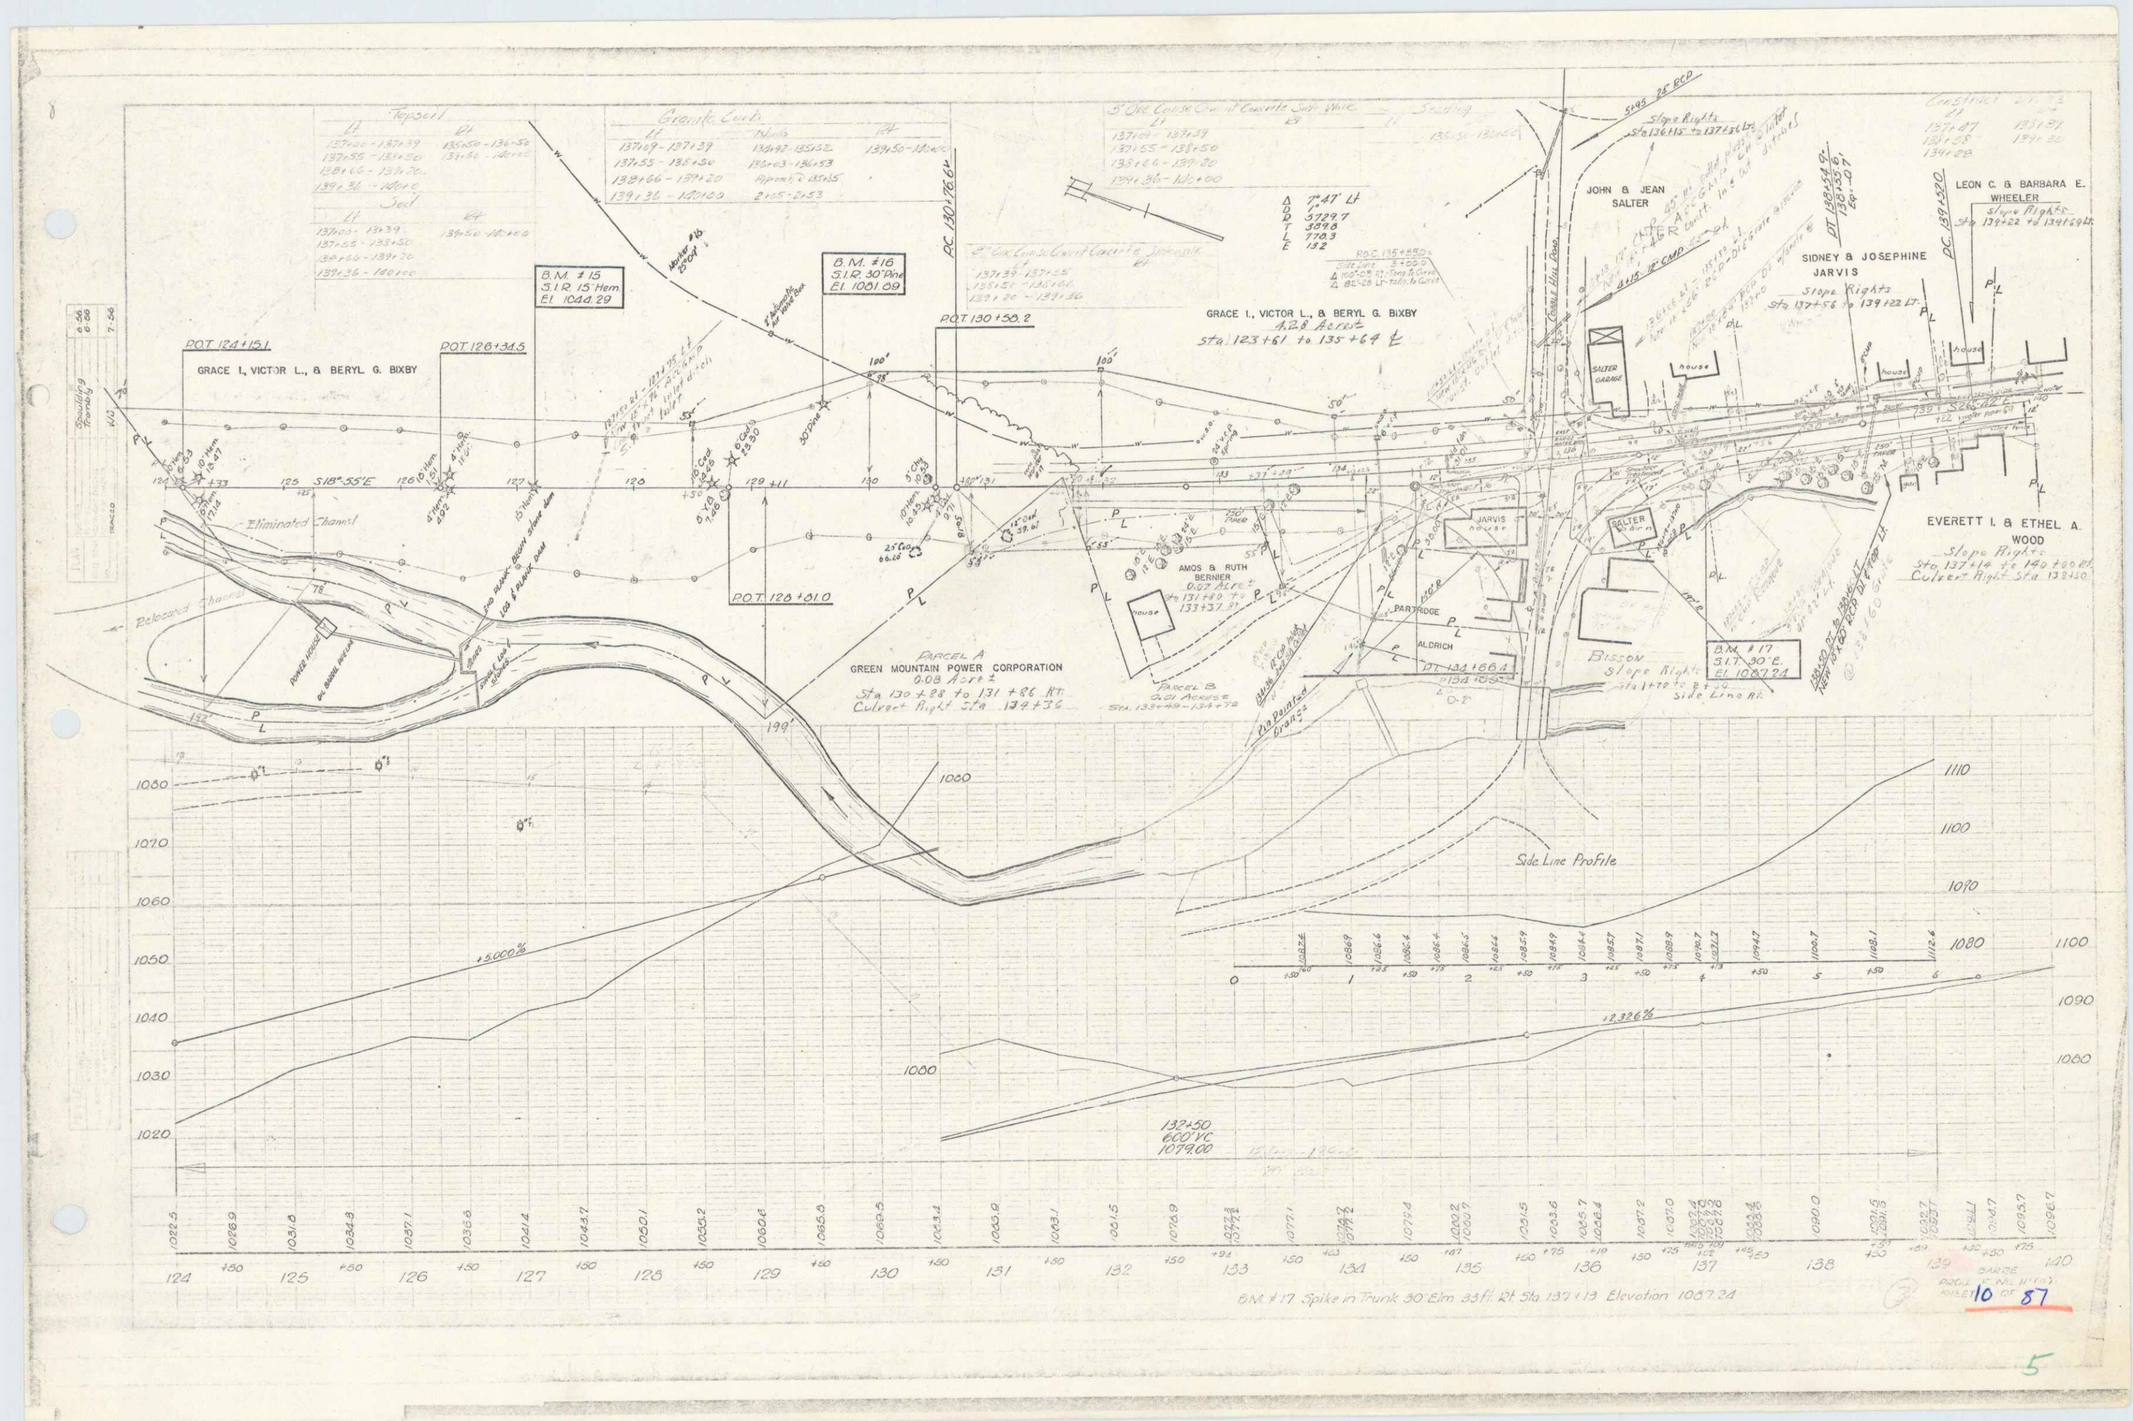
GRACE I., VICTOR L., & BERYL G. BIXBY
POT 124+15.1
POT 128+31.5
POT 128+81.0
POT 130+50.2
B.M. #15
S.I.R. 15" Hem.
El. 1004.29
B.M. #16
S.I.R. 30" Pine
El. 1081.09
S18°-35'E
Eliminated Channel
Relocated Channel
PARCEL A
GREEN MOUNTAIN POWER CORPORATION
0.08 Acre ±
Sta. 130+28 to 131+86 Rt.
Culvert Right Sta. 132+36
PARCEL B
0.01 Acres ±
Sta. 133+49 - 134+72
GRACE I., VICTOR L., & BERYL G. BIXBY
4.28 Acres ±
Sta. 123+61 to 135+64 ℄
AMOS & RUTH BERNIER
0.07 Acre ±
Sta. 131+40 to 133+37.31
JOHN & JEAN SALTER
SIDNEY & JOSEPHINE JARVIS
Slope Rights
Sta. 137+56 to 139+22 Lt.
LEON C. & BARBARA E. WHEELER
Slope Rights
Sta. 139+22 to 139+69 Lt.
EVERETT I. & ETHEL A. WOOD
Slope Rights
Sta. 137+16 to 140+00 Rt.
Culvert Right Sta. 138+30
BISSON
Slope Rights
Sta. 140+70 to 141+00
Side Line Rt.
BM #17
S.I.T. 30" E.
El. 1087.24
JARVIS
SALTER
PARTRIDGE
ALDRICH
Side Line Profile
+5.000%
+2.326%
132+50
600' VC
1079.00
BM #17 Spike in Trunk 30" Elm 33 ft. Rt. Sta. 137+13 Elevation 1087.24
BANGE
PROJECT NO. 11-7-11
SHEET 10 OF 87
5