

**GUARD RAIL REQUIRED**  
**ON LEFT**  
 Sta. 25+23 to 26+55 Length 232 ft.  
 36+34 to 37+18 " 24 "

**ON RIGHT**  
 Sta. 27+73 to 27+97 Length 24 ft.  
 36+81 to 37+05 " 24 "

**TOTAL THIS SHEET 328 ft.**

**NEW CULVERTS REQUIRED**

Sta. 27+75 3'-5" Reinforced Concrete Culvert  
 1'-2" x 4" Concrete 6.0 cu yds.  
 1'-2" x 5" " 12.1 "  
 Reinforcing Steel 208 lbs.

Sta. 37+00 16" Con. I.P. with Drop Inlet  
 1'-2" x 5" Concrete 1.8 cu yds.

**SUB BASE REQUIRED**  
 Sta. 25+43 to 30+50 Length 394 ft.  
 37+00 to 38+00 " 500 "







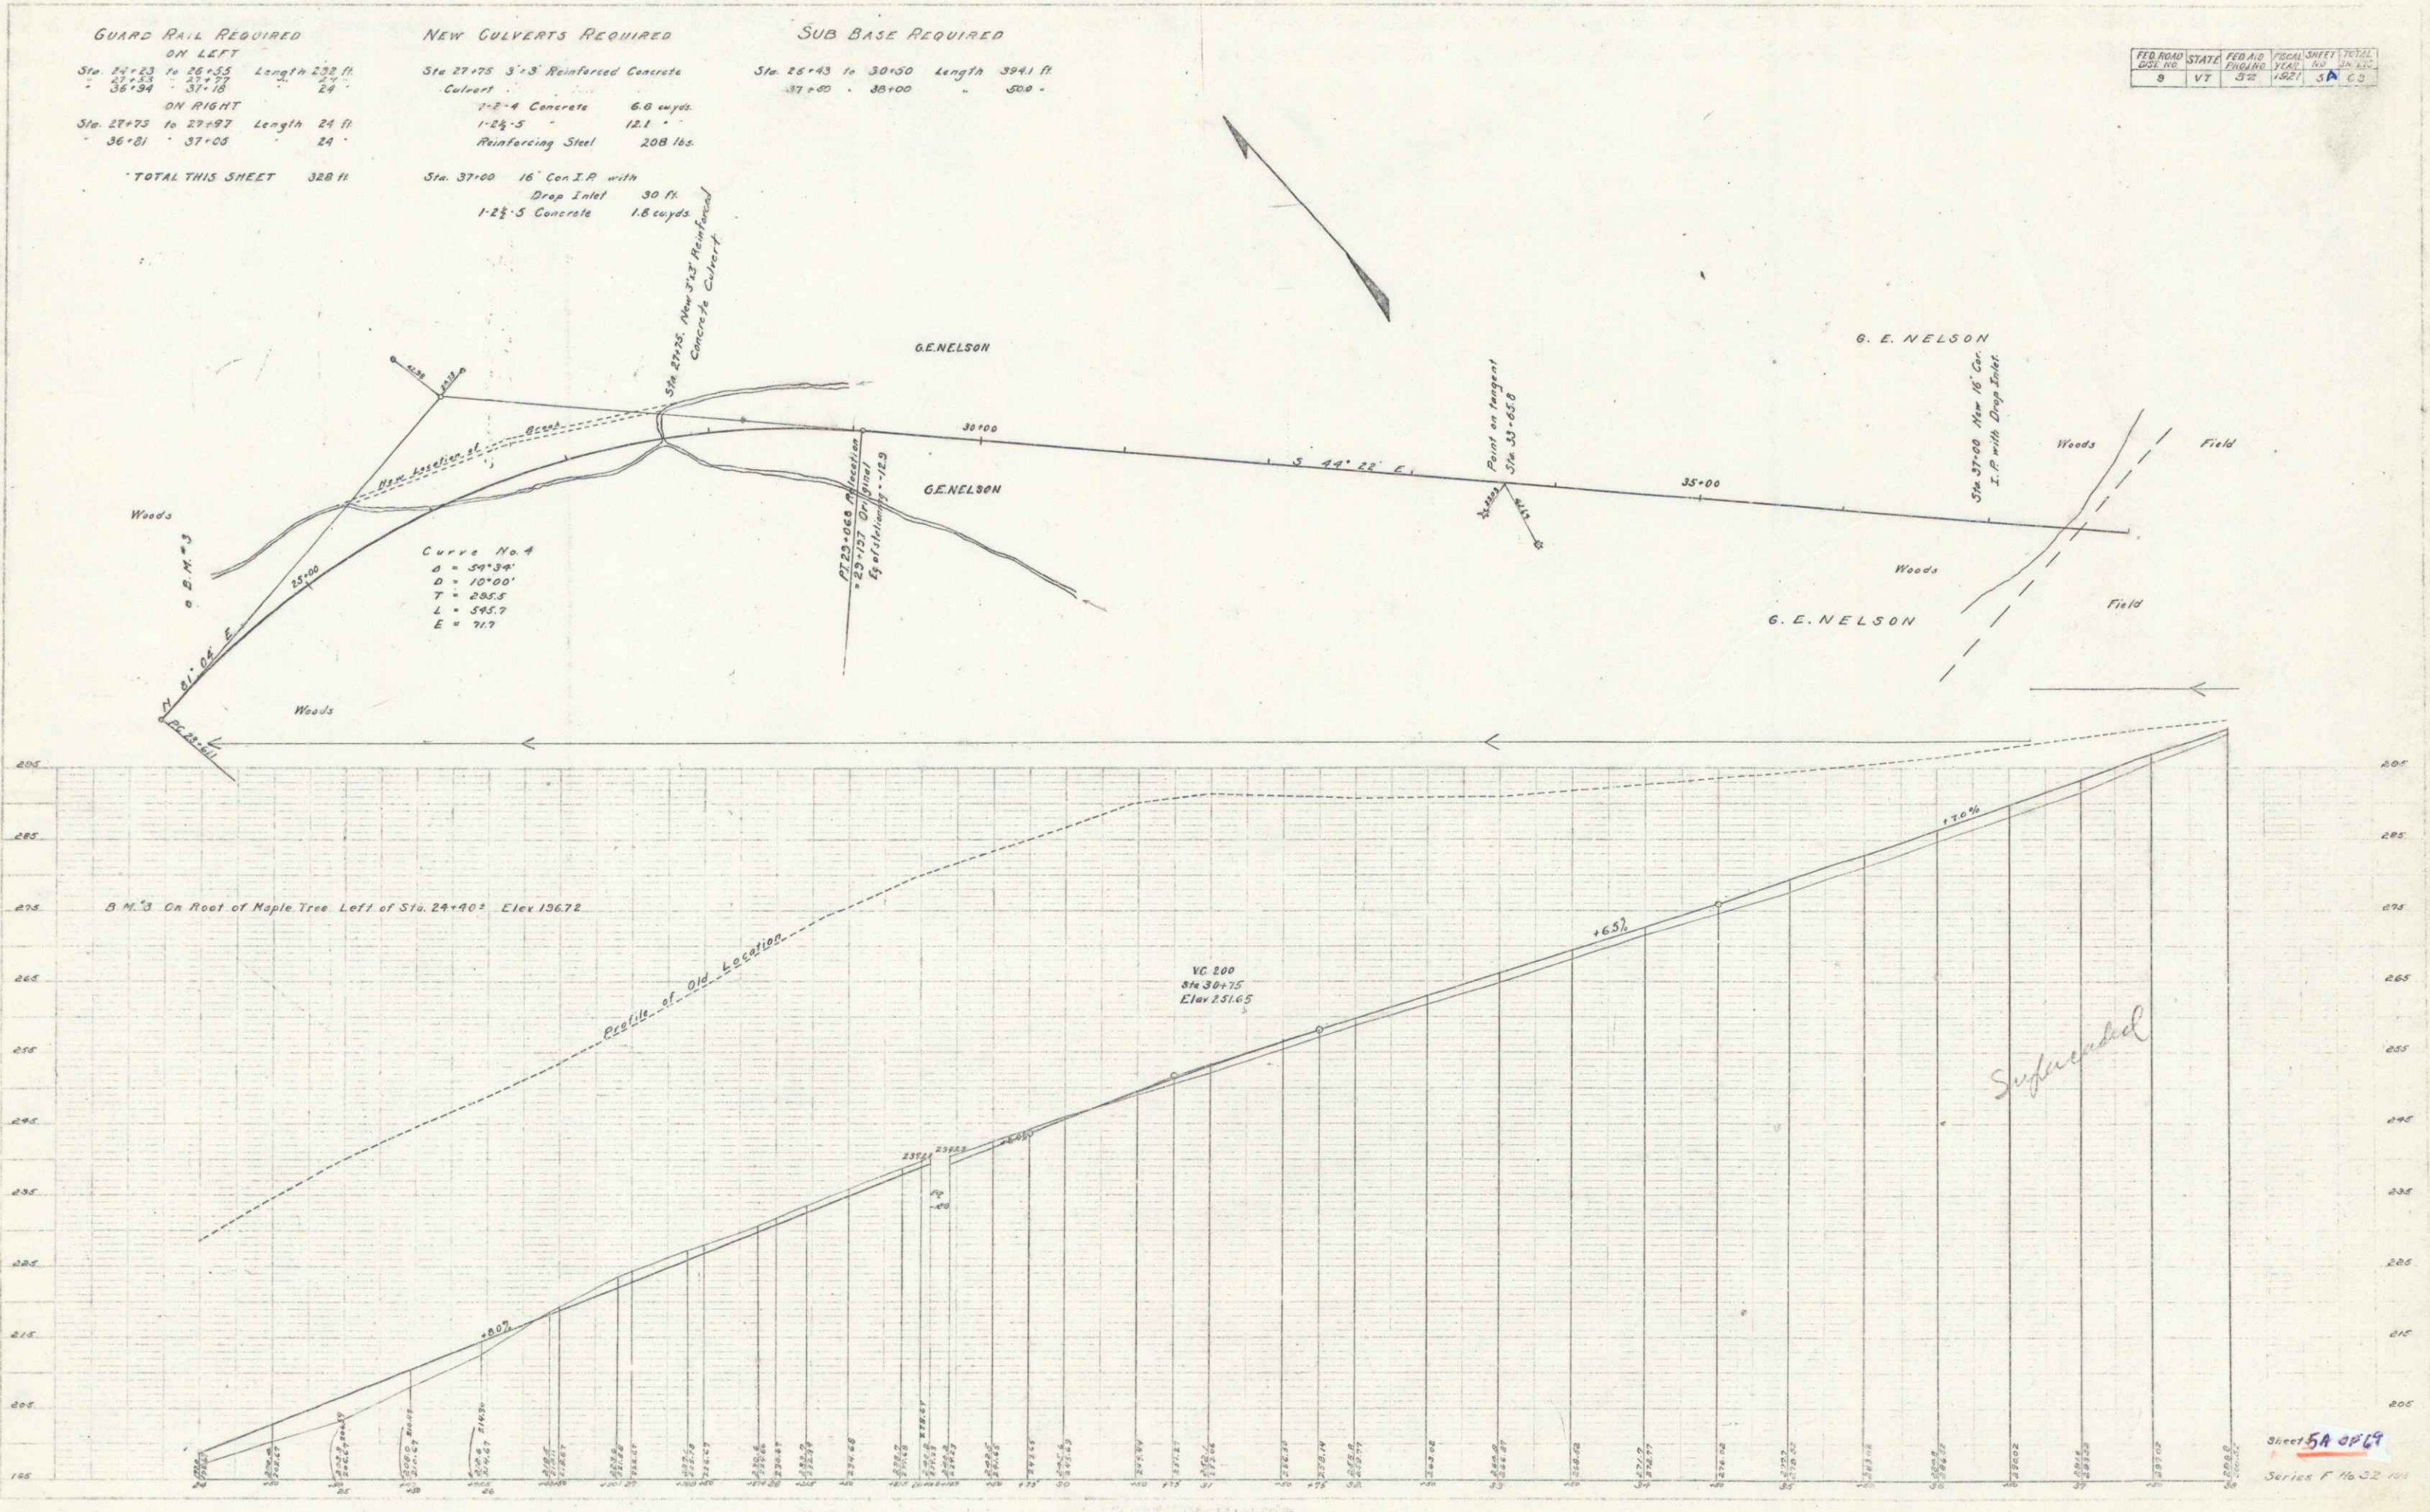

Sheet 5A 004  
 Series F No 52 700