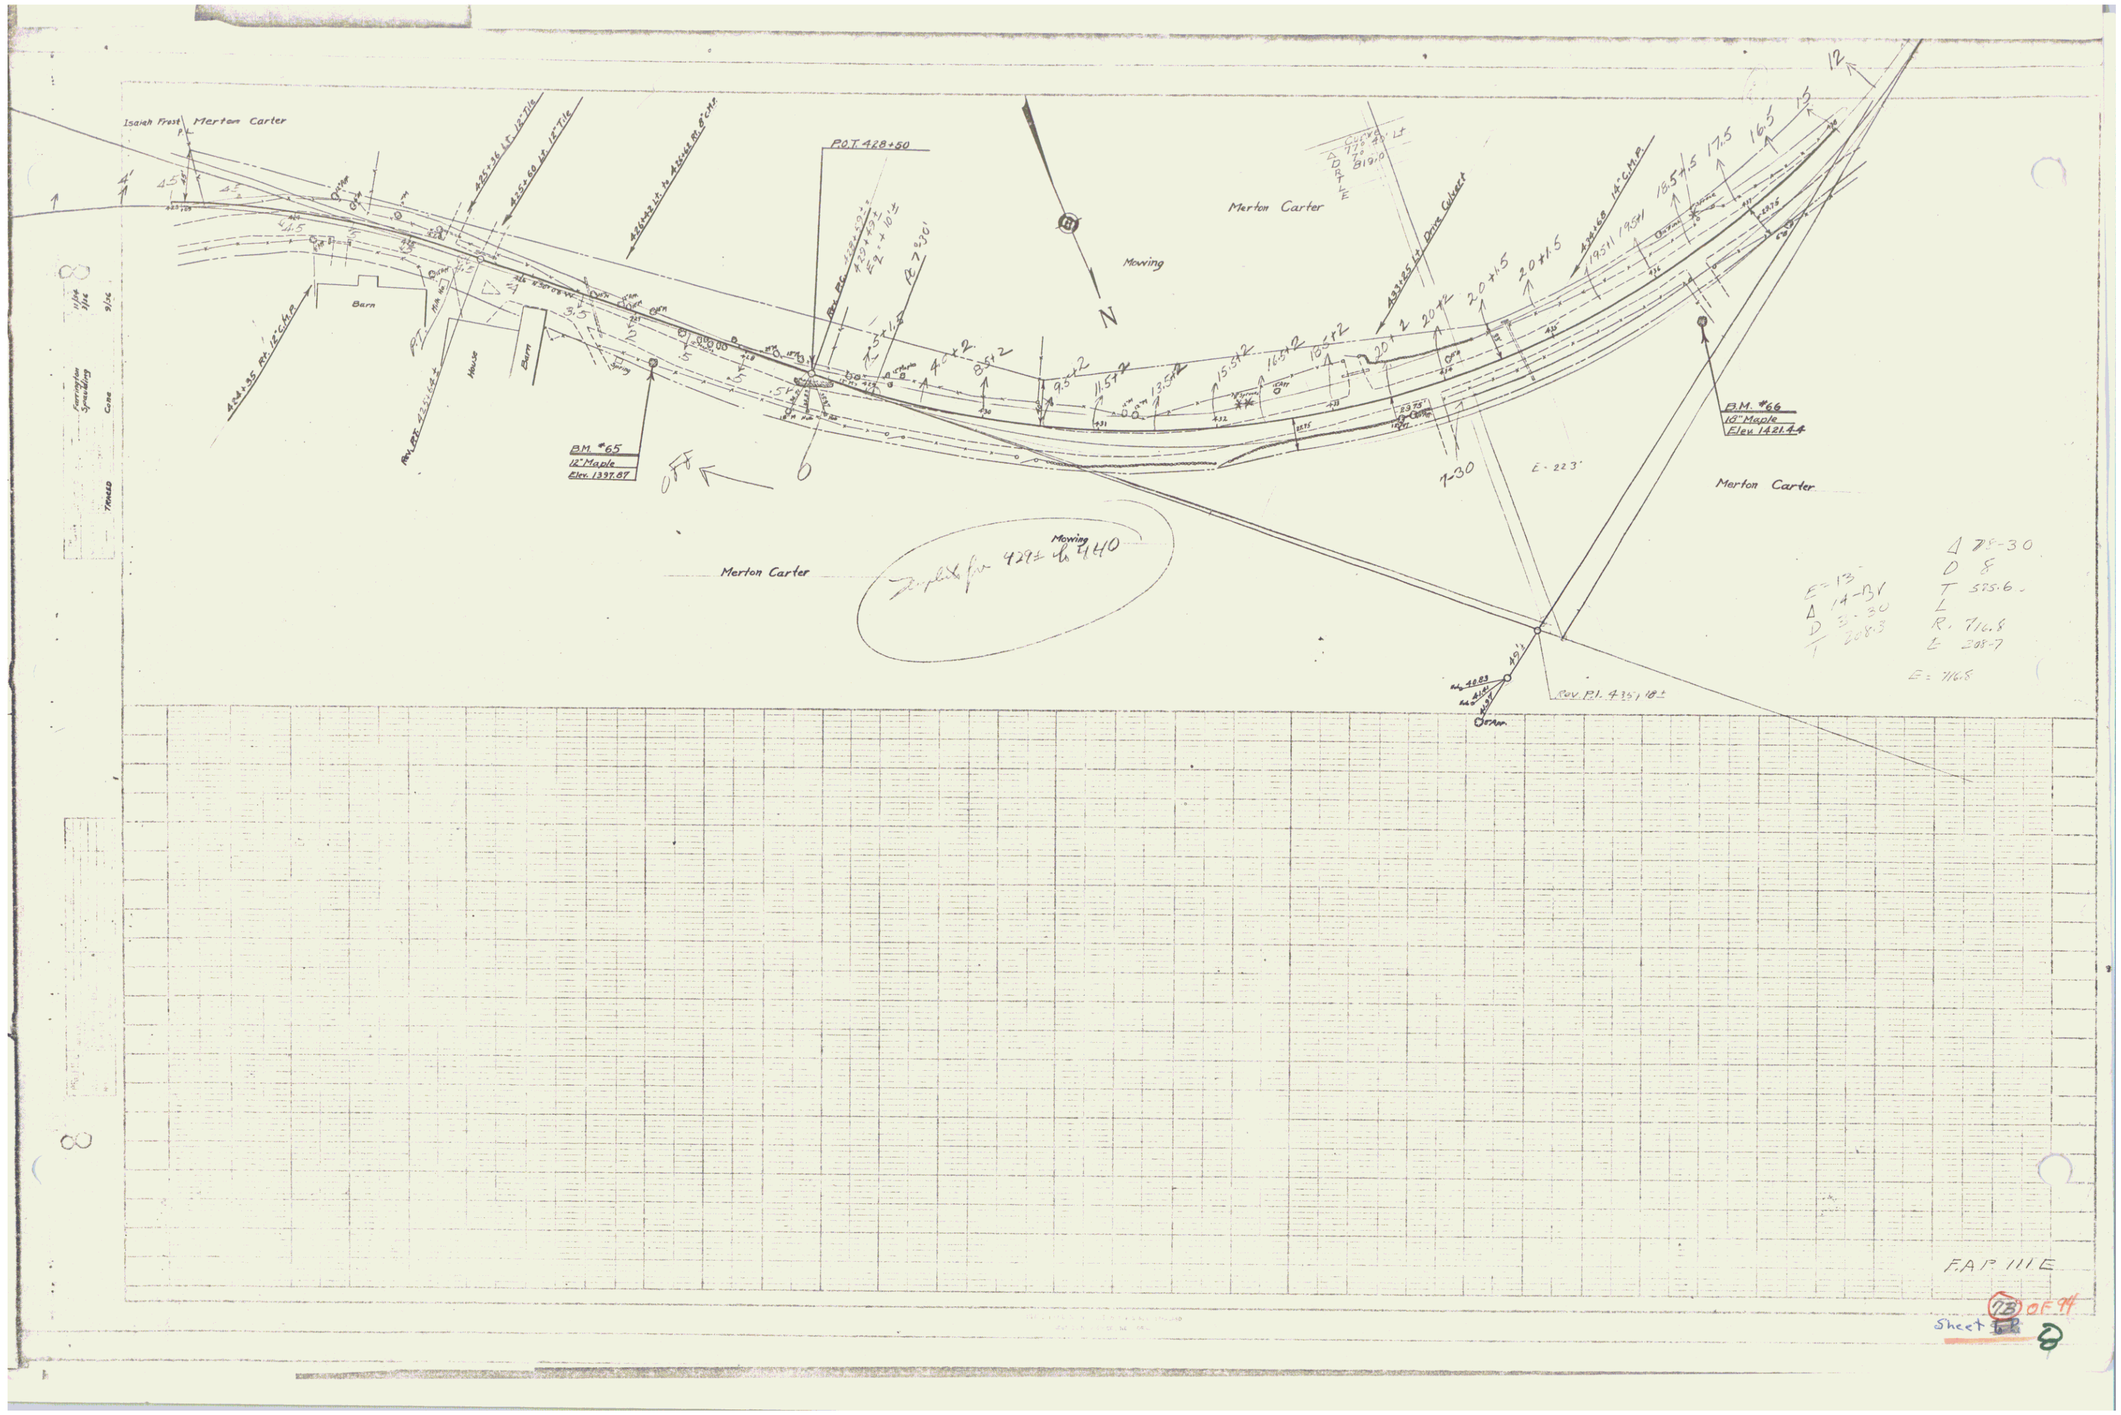
Isaiah Frost
Merton Carter
Barn
House
Barn
P.O.T. 428+50
B.M. #65
12" Maple
Elev. 1397.87
Mowing
Merton Carter
Merton Carter
Mowing
Merton Carter
B.M. #66
10" Maple
Elev. 1421.44
E - 223'
Merton Carter
Rev. Pl. 435+18±
Δ 75-30
D 8
T 575.6
L
R. 716.8
L 208.7
E: 716.8
E: 13
Δ 14-34
D 3-30
T 268.3
F.A.P. 111 E
Sheet 73 of 74