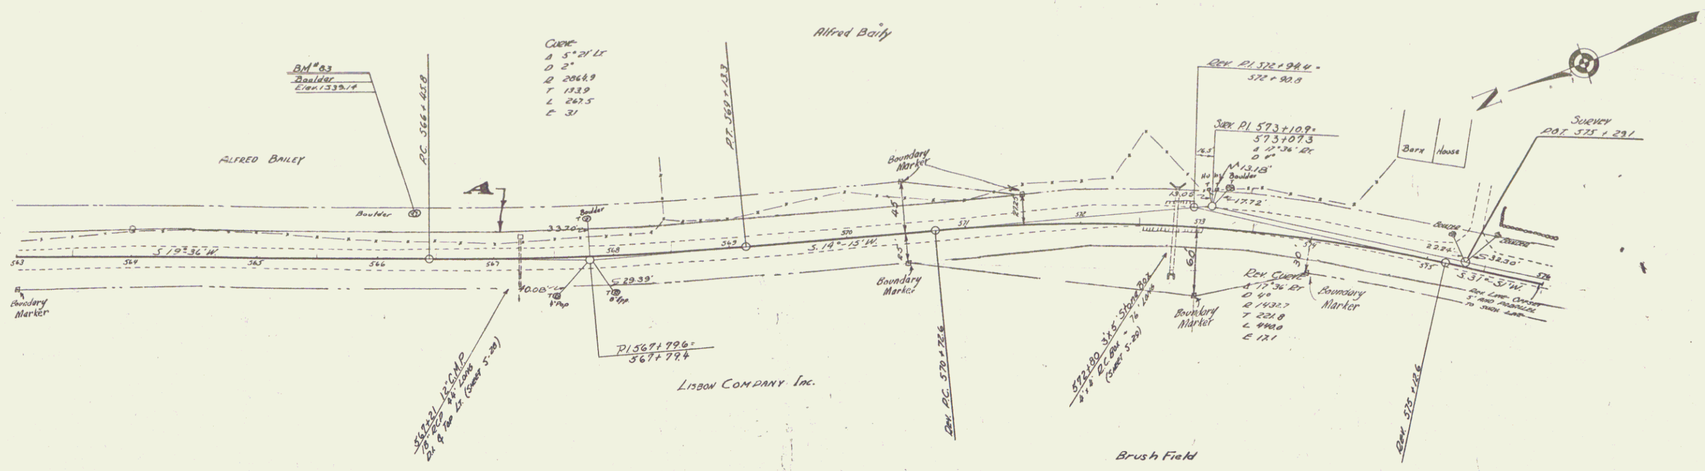

PARCEL	KIND OF INSTRUMENT	DATE OF INSTRUMENT	GRANTOR	GRANTEE	RECORDED BOOK	PAGE	DATE	REMARKS
A	Q.C.D.	9-30-36	ALFRED & EVAL BAILEY	Jt. of Vt.	27	510	10-7-36	

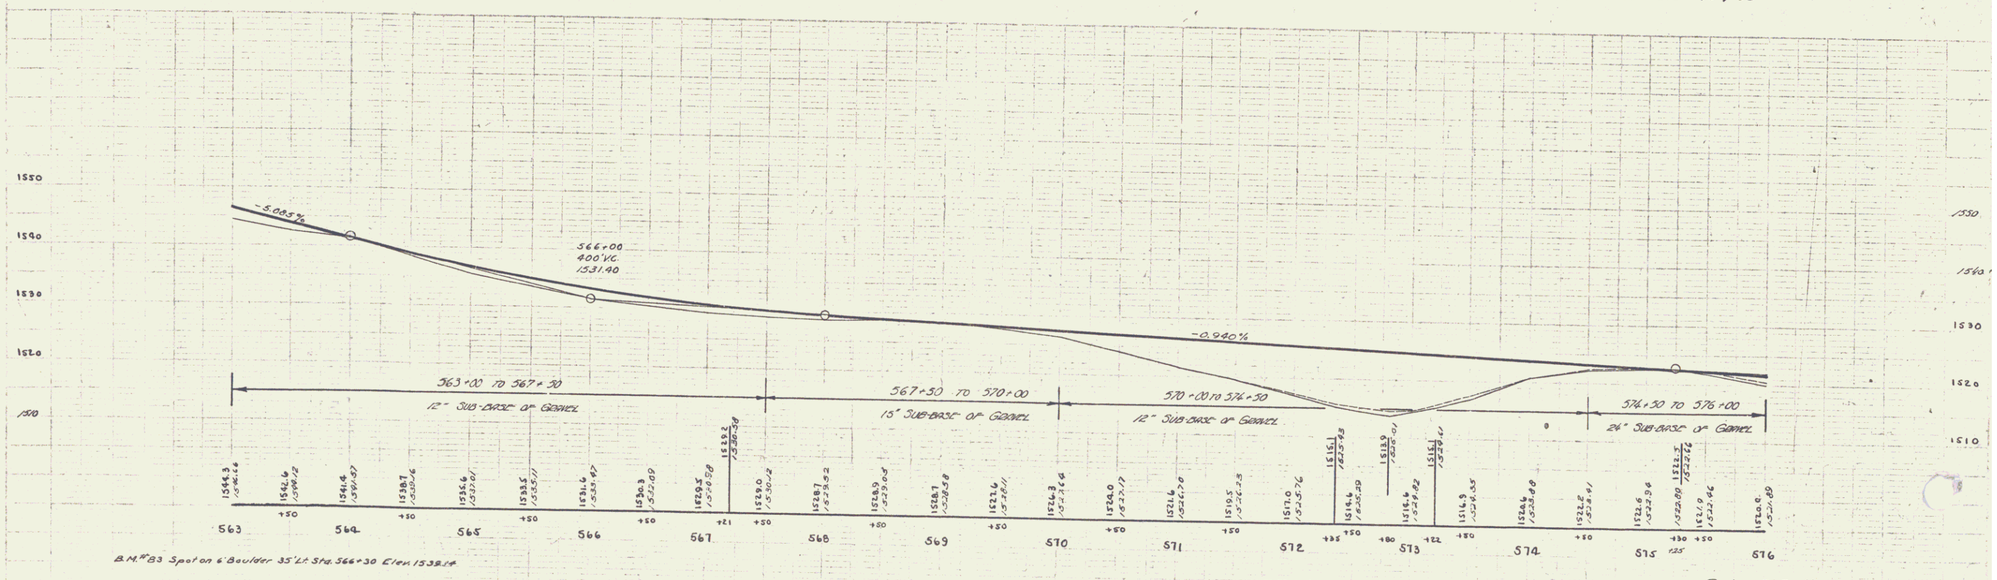

B.M. #83 Spot on 6" Boulder 35' Lt. Sta. 566+30 Elev. 1539.14

Series TAP No. 111-E
Sheet 16 of 94

18