


PARCEL	KIND OF INSTRUMENT	DATE OF INSTRUMENT	GRANTOR	GRANTEE	RECORDED BOOK PAGE DATE	REMARKS
B	W.D.	12-29-32	MARY BECK	STOFFY	19 74 4-5-33	

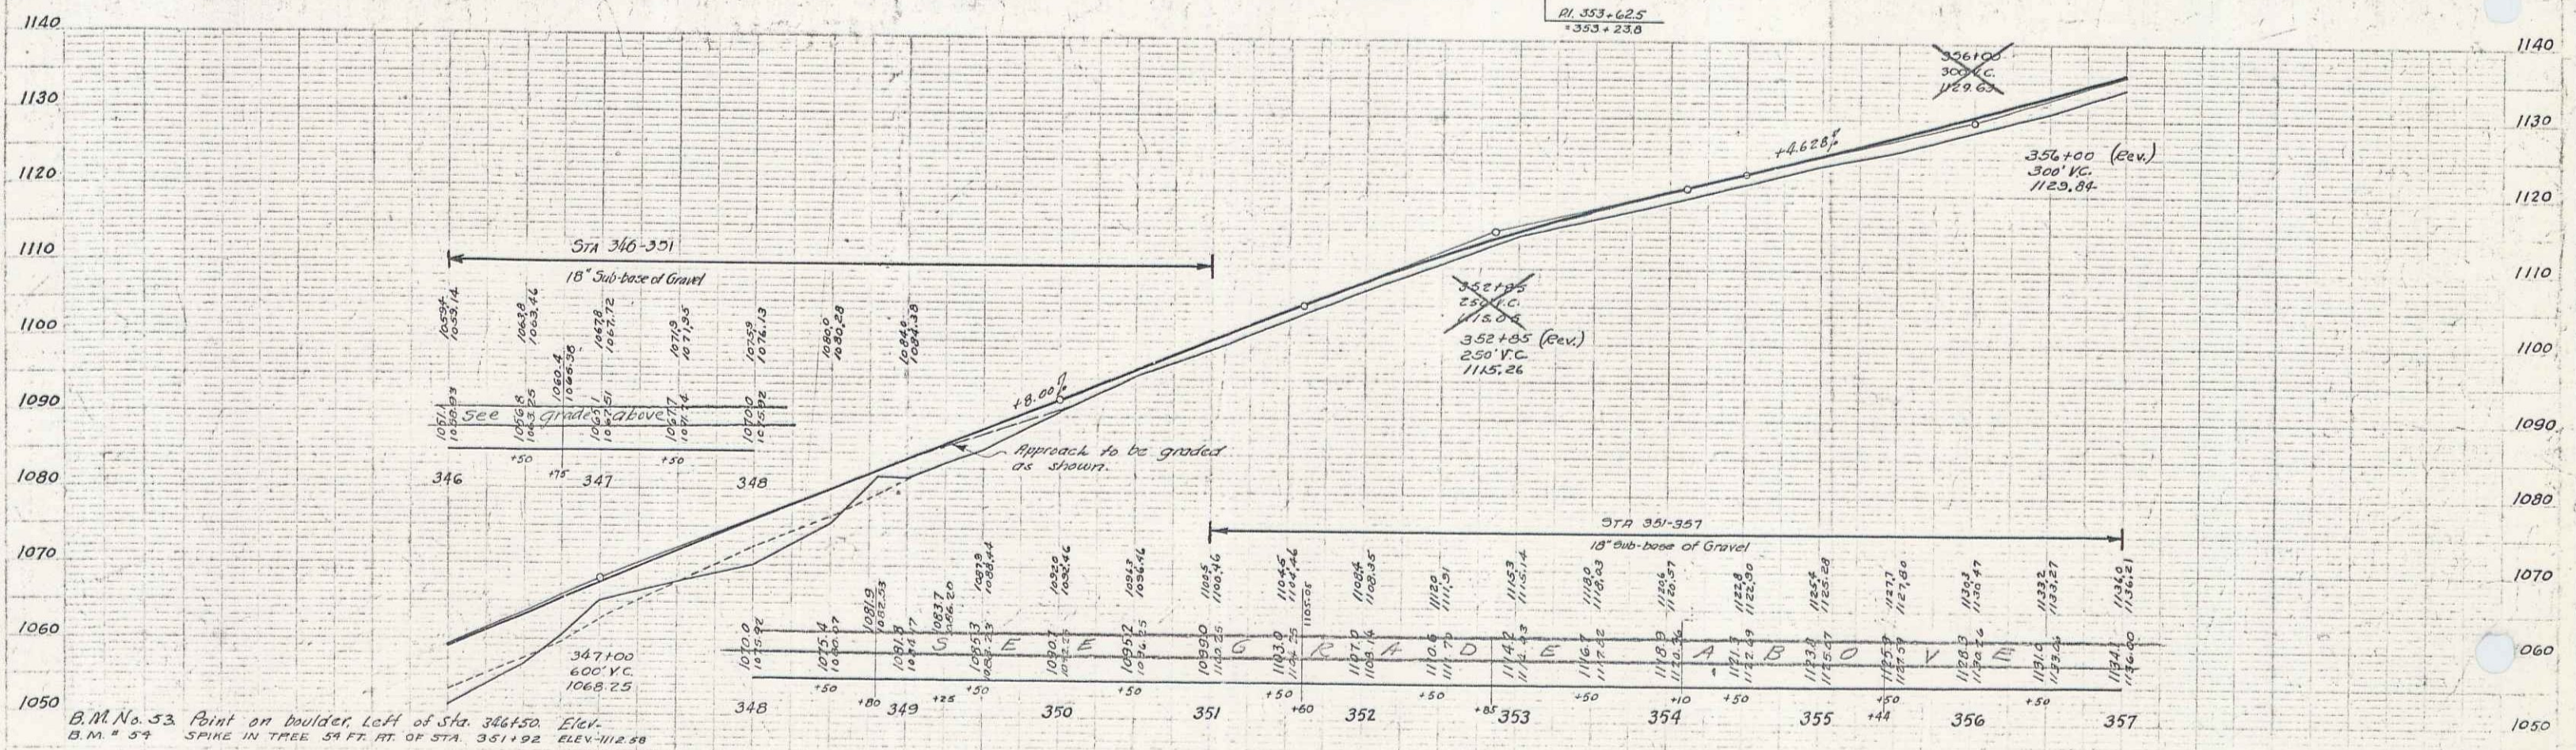

B.M. No. 53 Point on Boulder, Left of Sta. 346+50 Elev.
 B.M. # 59 SPIKE IN TREE 54 FT. RT. OF STA. 351+92 ELEV. 112.58