


Parcel	Kind of Instrument	Date of Instrument	Grantor	Grantee	Recorded	Remarks
A	Q.C.D.	1-31-34	G.M. & O.B. Vance	Sheet 13	876	1-7-34

FED. ROAD DIST. NO. 111-C 1933 4 54
 E.H.H. - 1938 16 70
 N.H.H. - 111-C 1933 4 54

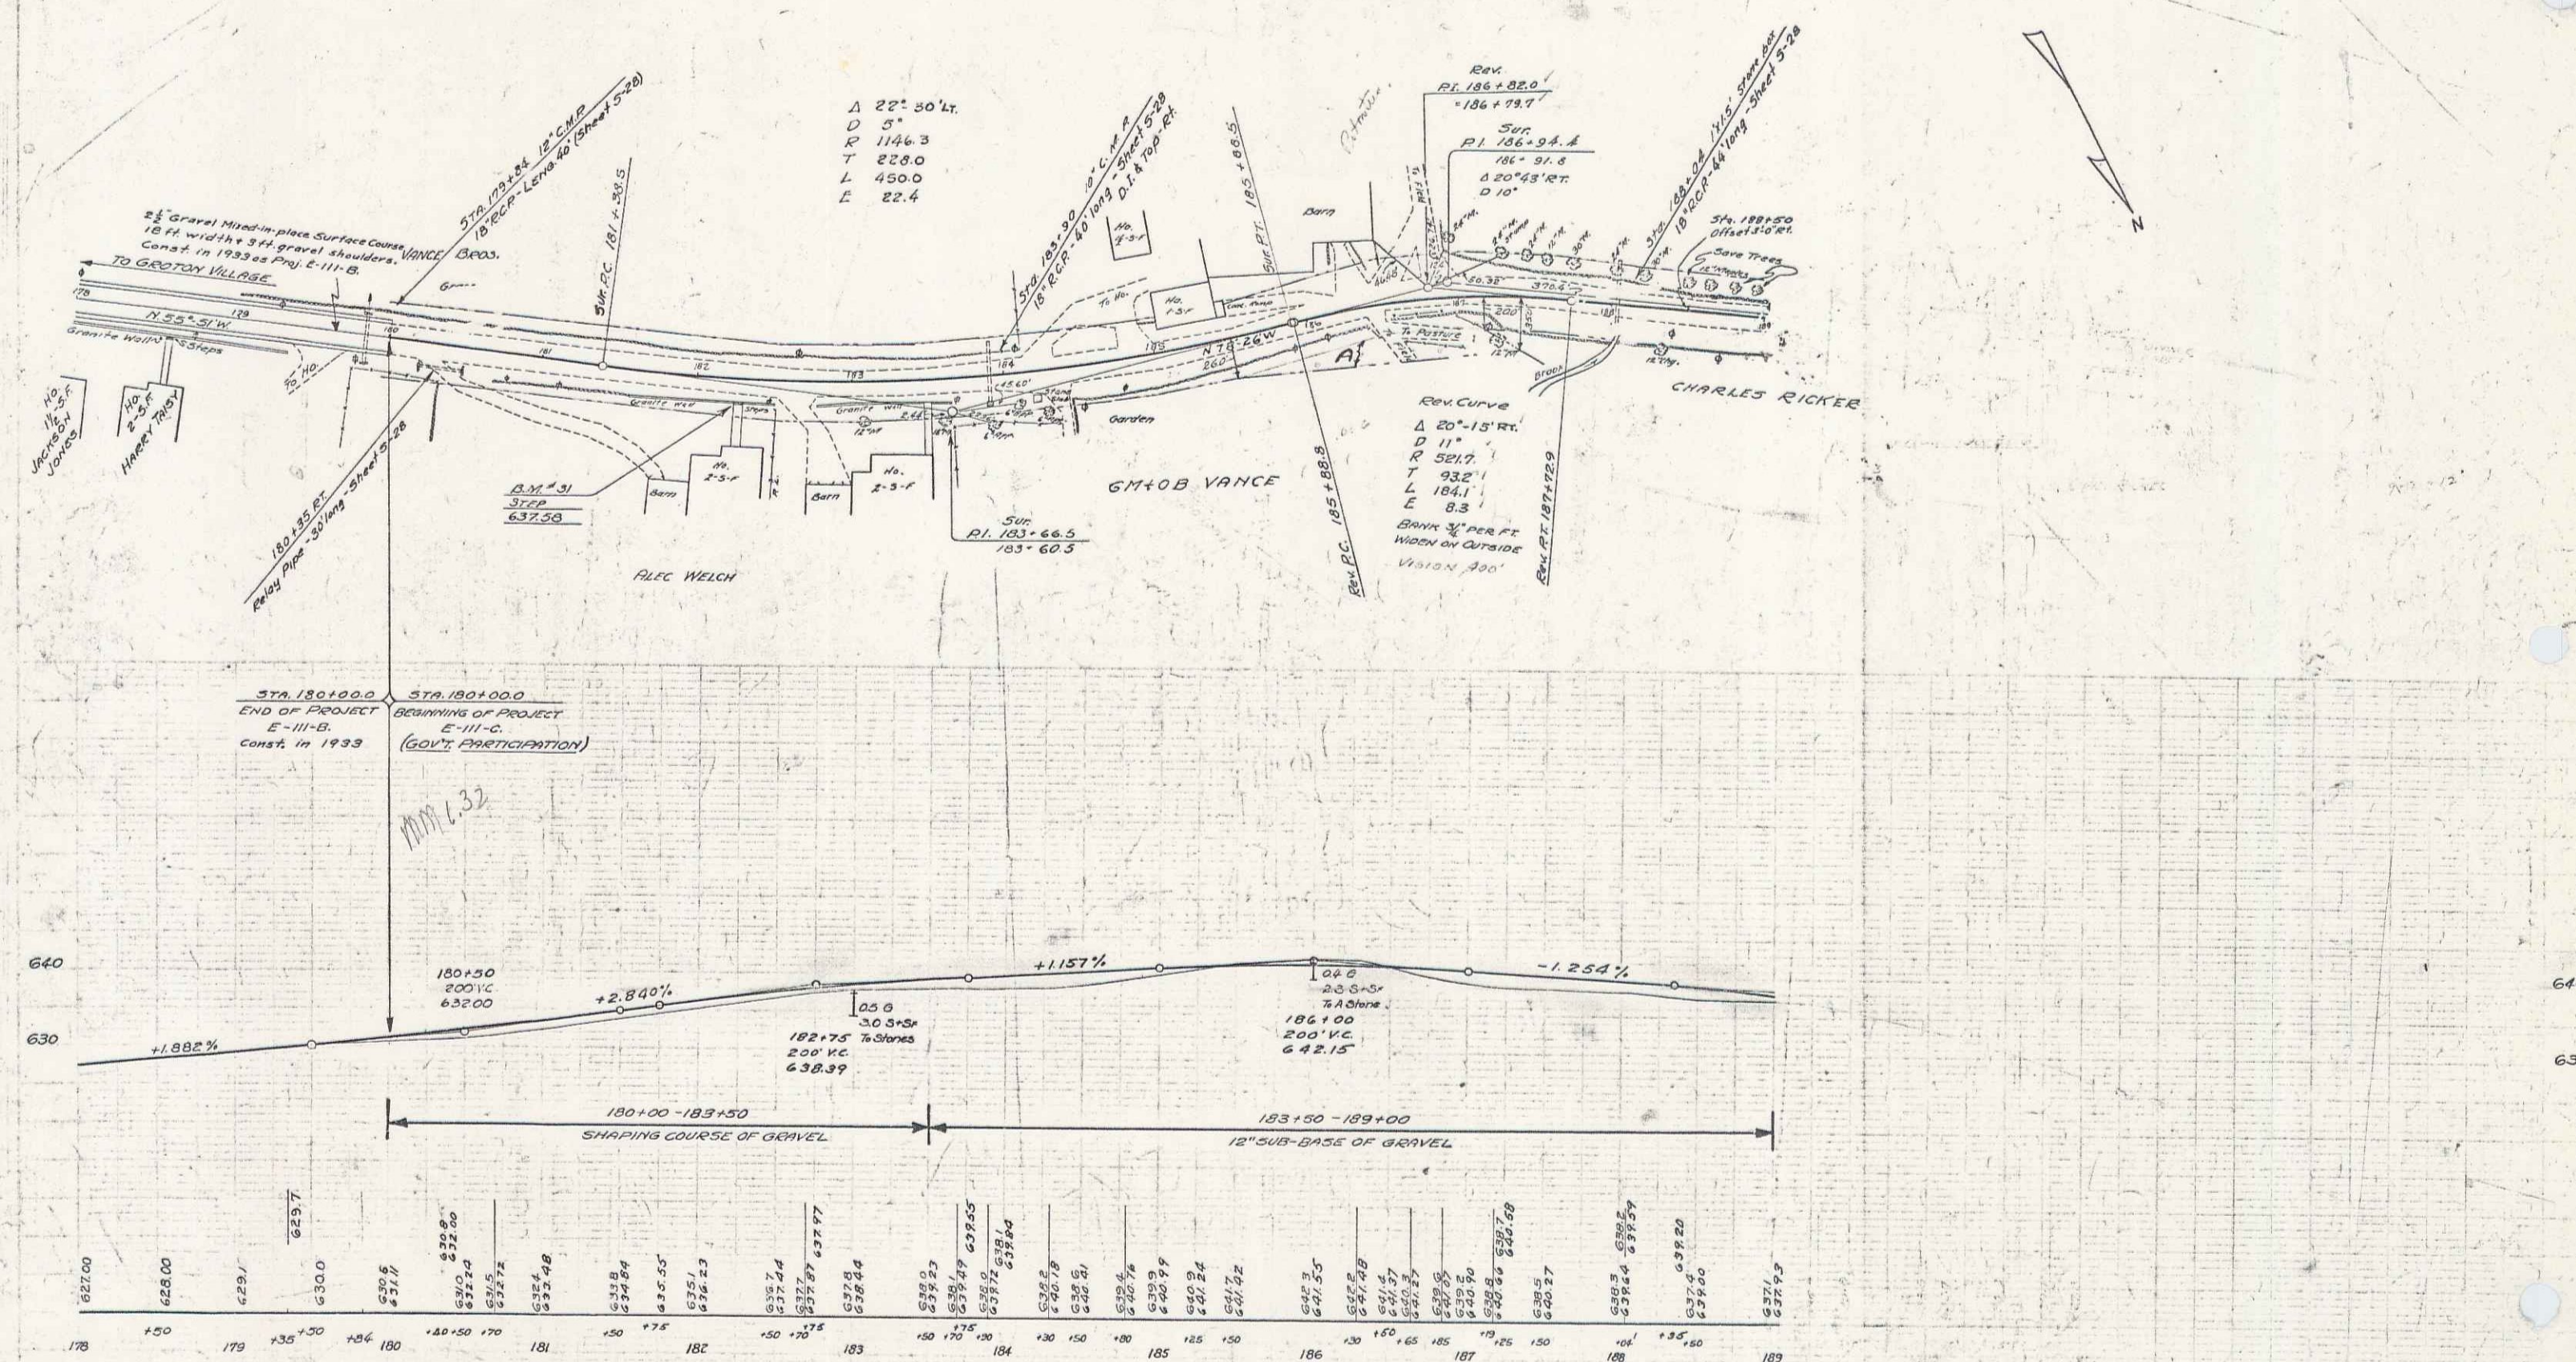

C-4, 8/14/33 4/133

SERIES N.R.H. No. 111-C
 SHEET 4 OF 5A

SERIES NO. E.H.H. - C
 SHEET 16 OF 72

2