


Parcel	Kind of Instrument	Date of Instrument	Grantor	Grantee	Recorded Grantor	Recorded Grantee	Remarks
A	Q.C.D.	1-30-34	Charles Ricker	Stacy	Book 13	Page 674	2-7-34
A'	Q.C.D.	1-30-34	Levi & Francis Wilson	"	13	674	1-7-34
Calc. #1	Agreement	5-14-34	Dexter M. Whitmill	"	"	"	Calc. Sta. 207100

STATE N.H. TUGAL SHEET NO. 11-C 1933 0 5-A

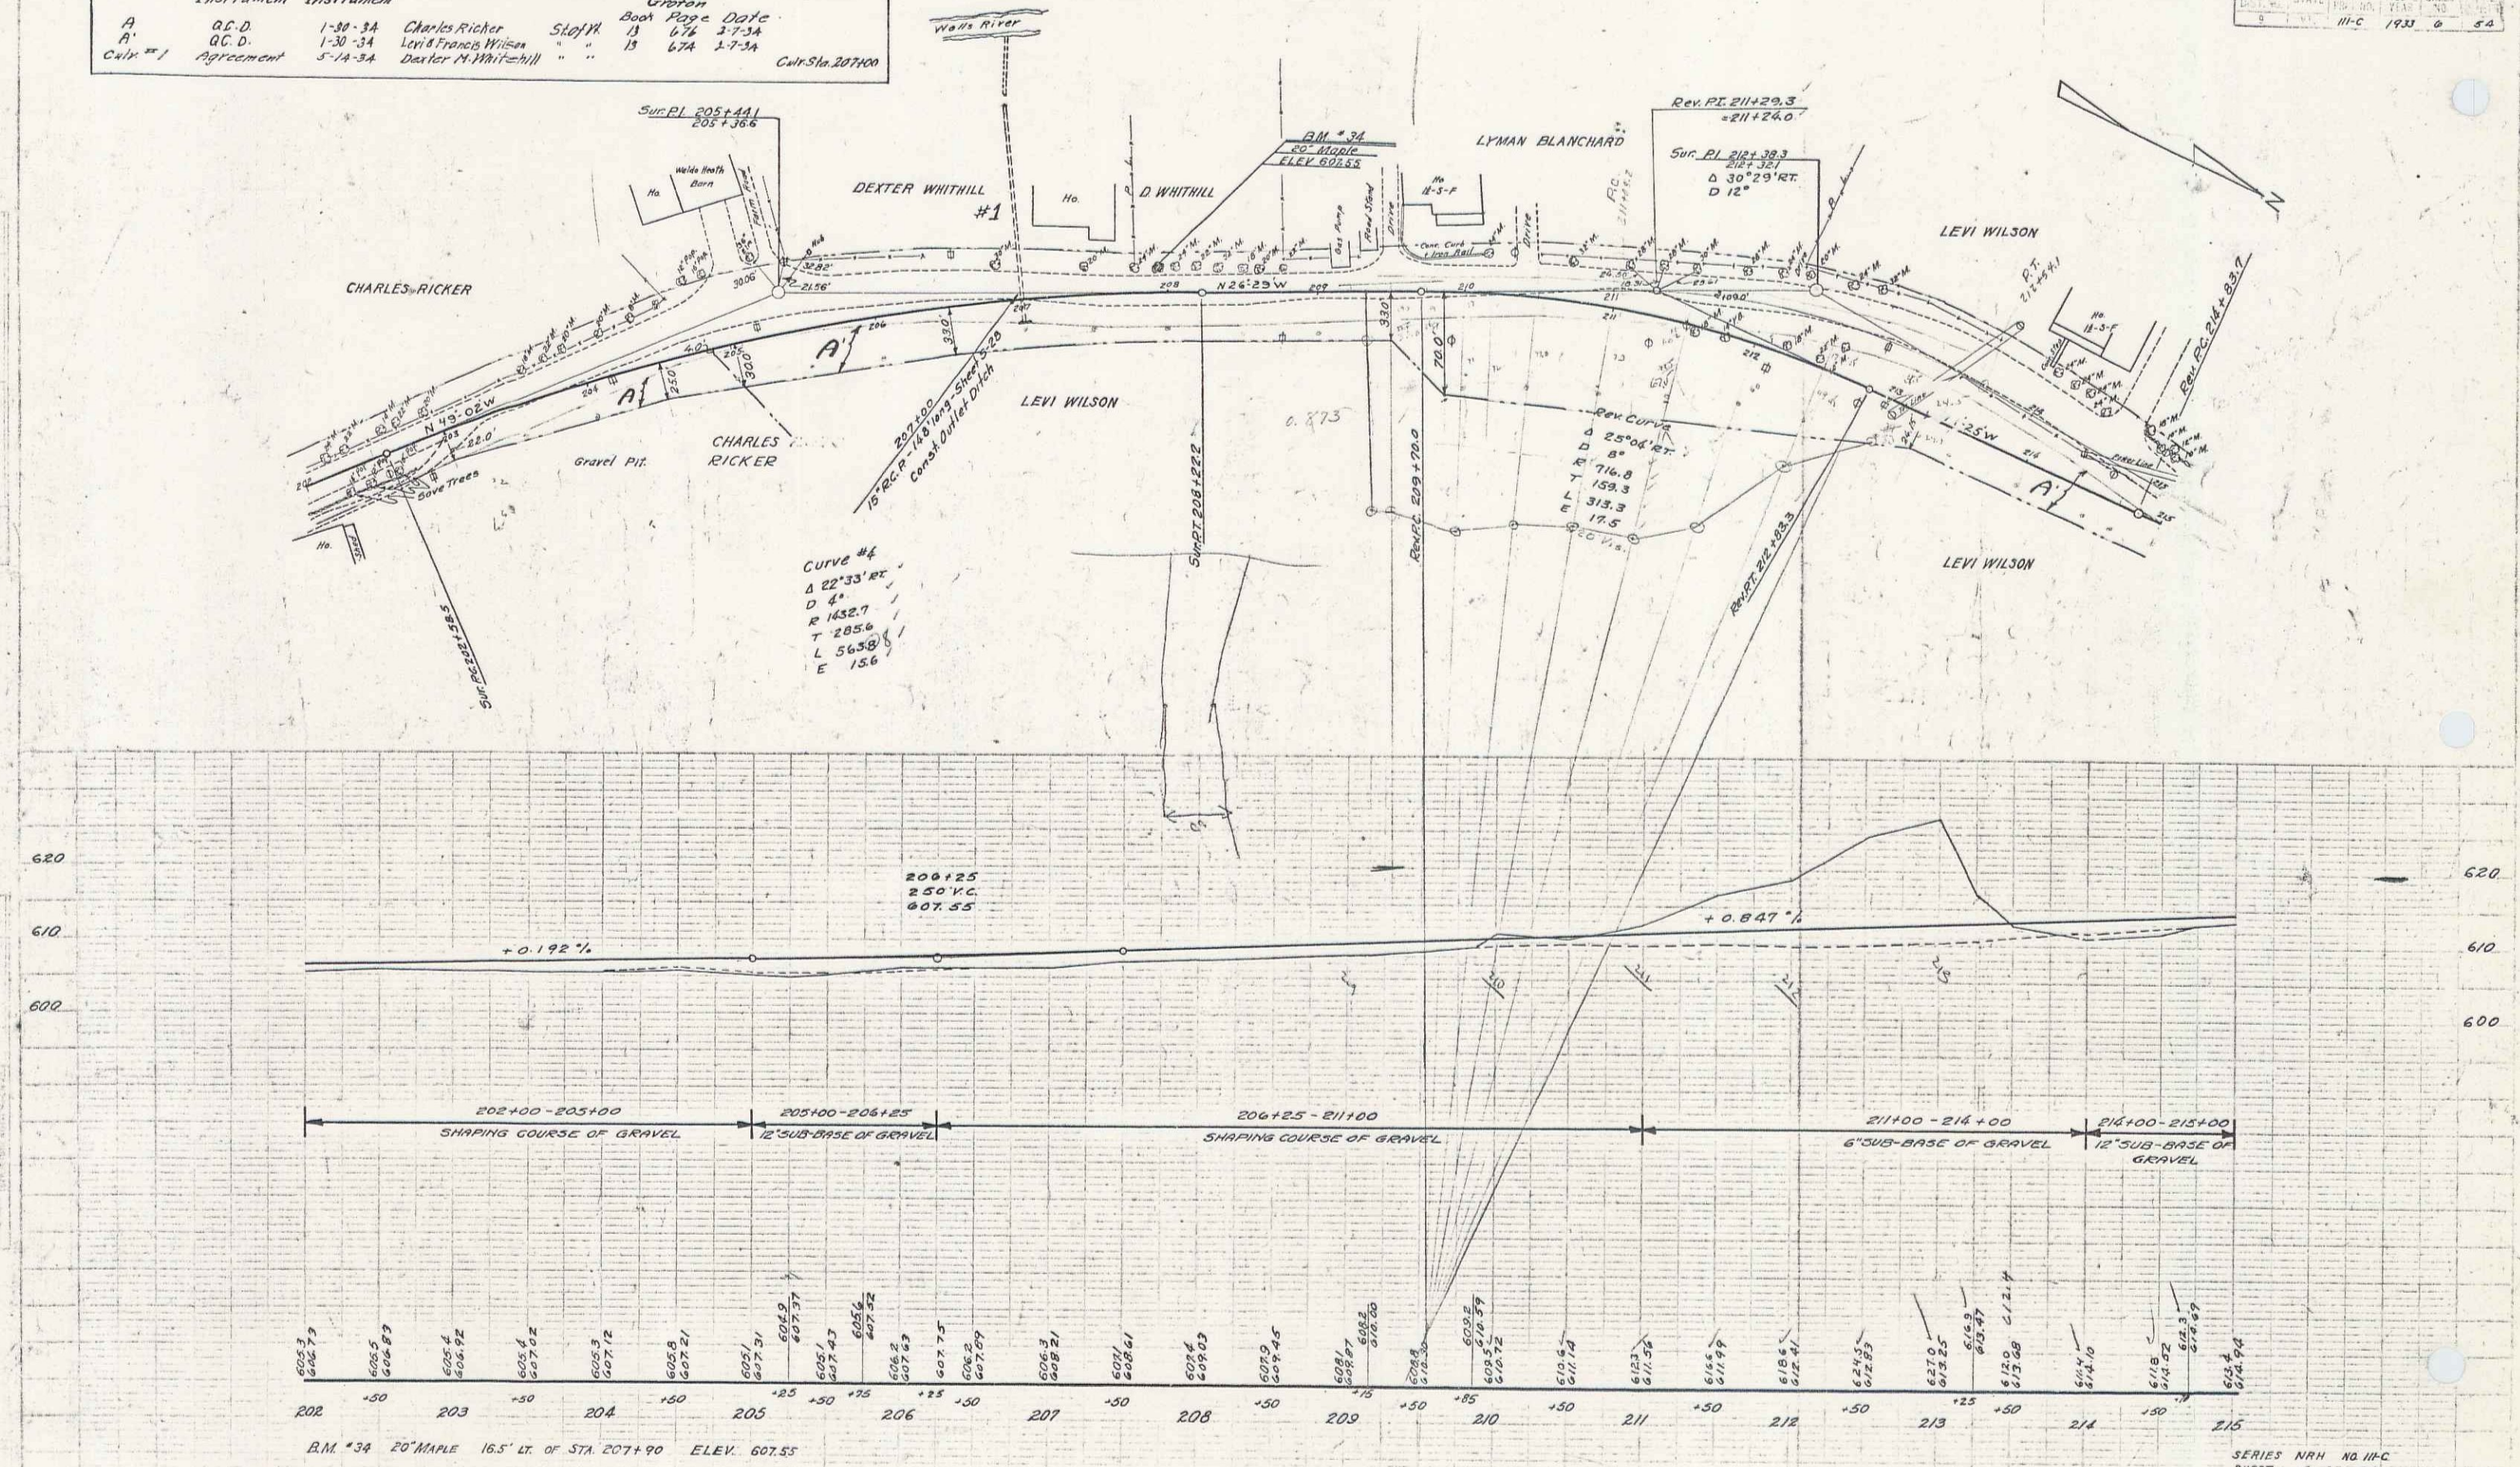

B.M. #34 20" ANGLE 16.5' LY. OF STA. 2071+90 ELEV. 607.55

SERIES NRH NO. 11-C SHEET 6 OF 5-A

4