Parcel	Kind of Instrument	Date of Instrument	Grantor	Grantee	Recorded Groton Book	Page	Date	Remarks
B	Q.C.D.	1-31-34	Sylvanus Annis	St. of Vt.	13	671	3-7-34	
A' & Culv. #1	Q.C.D.	1-31-34	Harry Richer	" "	13	672	3-7-34	Culv. Sta. 264.40
A"	Q.C.D.	1-31-34	Dr. I. N. Eastman	" "	13	675	3-7-34	

N.R.H.
111-C 1933 10 54

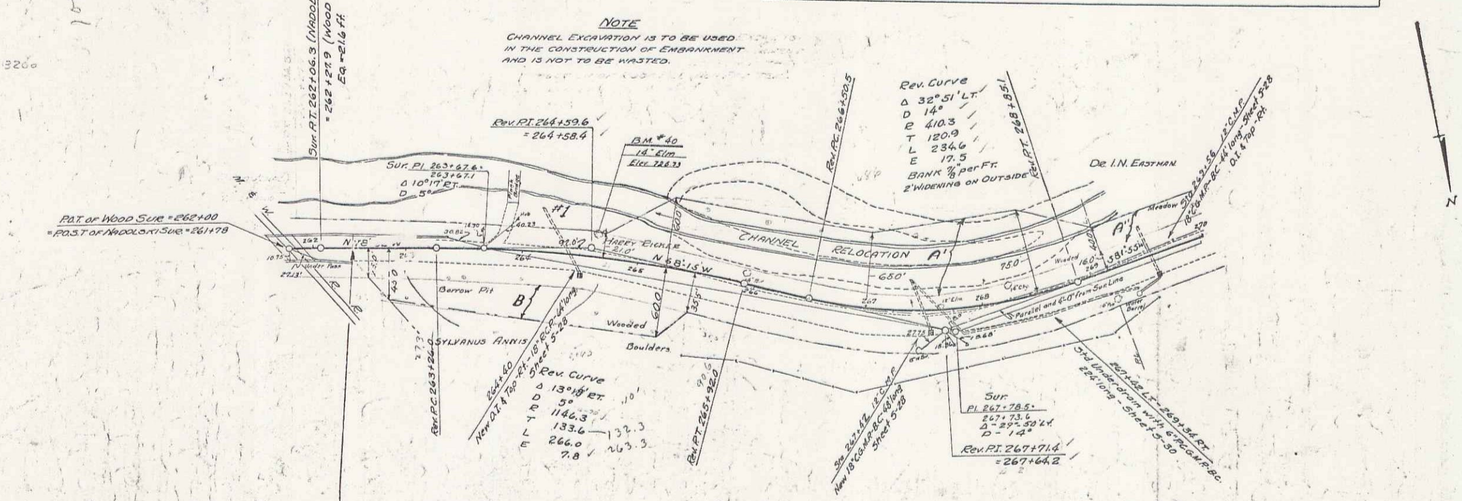

SERIES NRH NO. 111-C
SHEET 10 OF 54