Parcel	Kind of Instrument	Date of Instrument	Grantor	Grantee	Recorded Reregate Book	Page	Date	Remarks
A,B,C,D (Cult.#1)	Q.C.D	7-17-33	H.L. James	Stefft.	15	376	9-15-33	Cult. St. 68+00

STATE	ROUTE	SECTION	SHEET	TOTAL SHEETS
		F111-B 1933	8	72

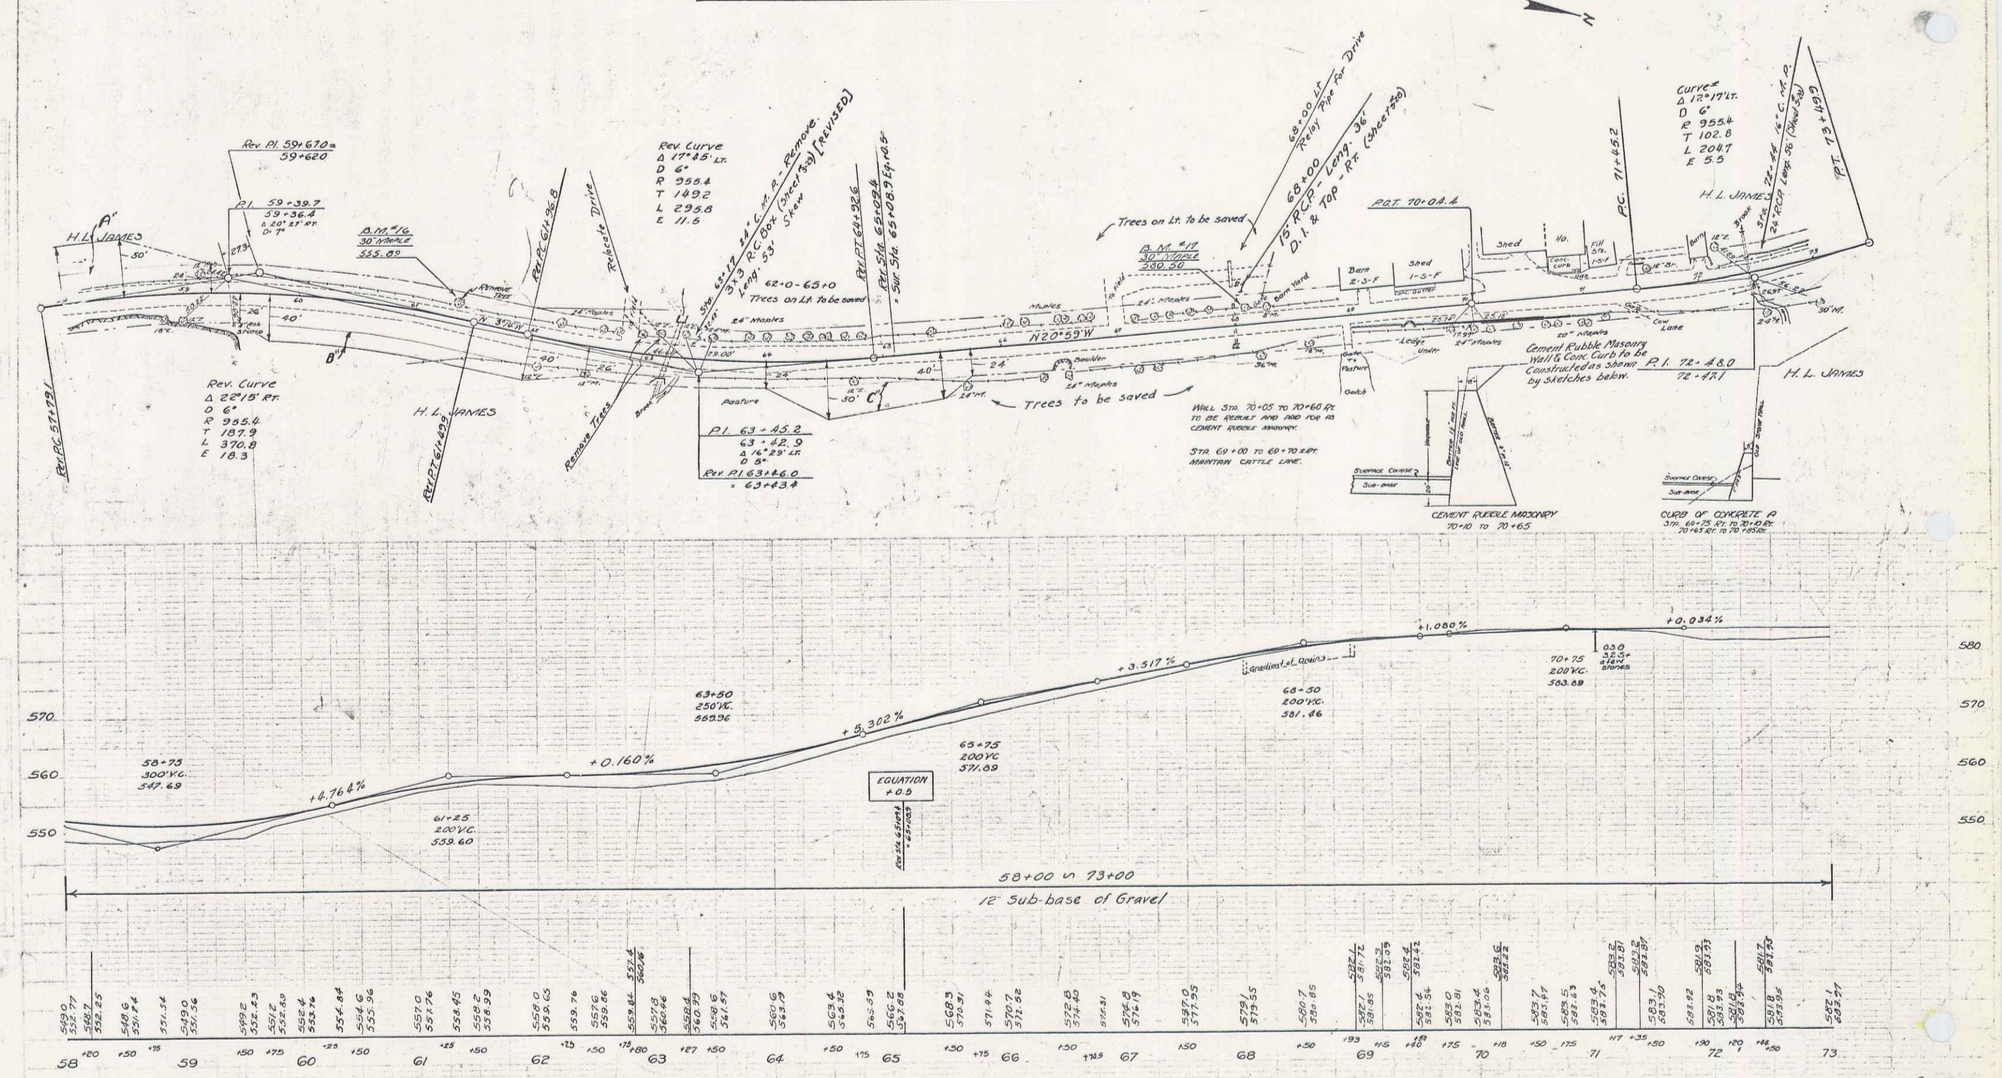

B.M. #16 Spike in root of 30" Maple 19 ft. Lt. of Sta. 61+35 Elev. 555.89
B.M. #17 " " " " " " 10 " " " 68+10 " 580.50

Series No. F111-B
Sheet 8 of 72