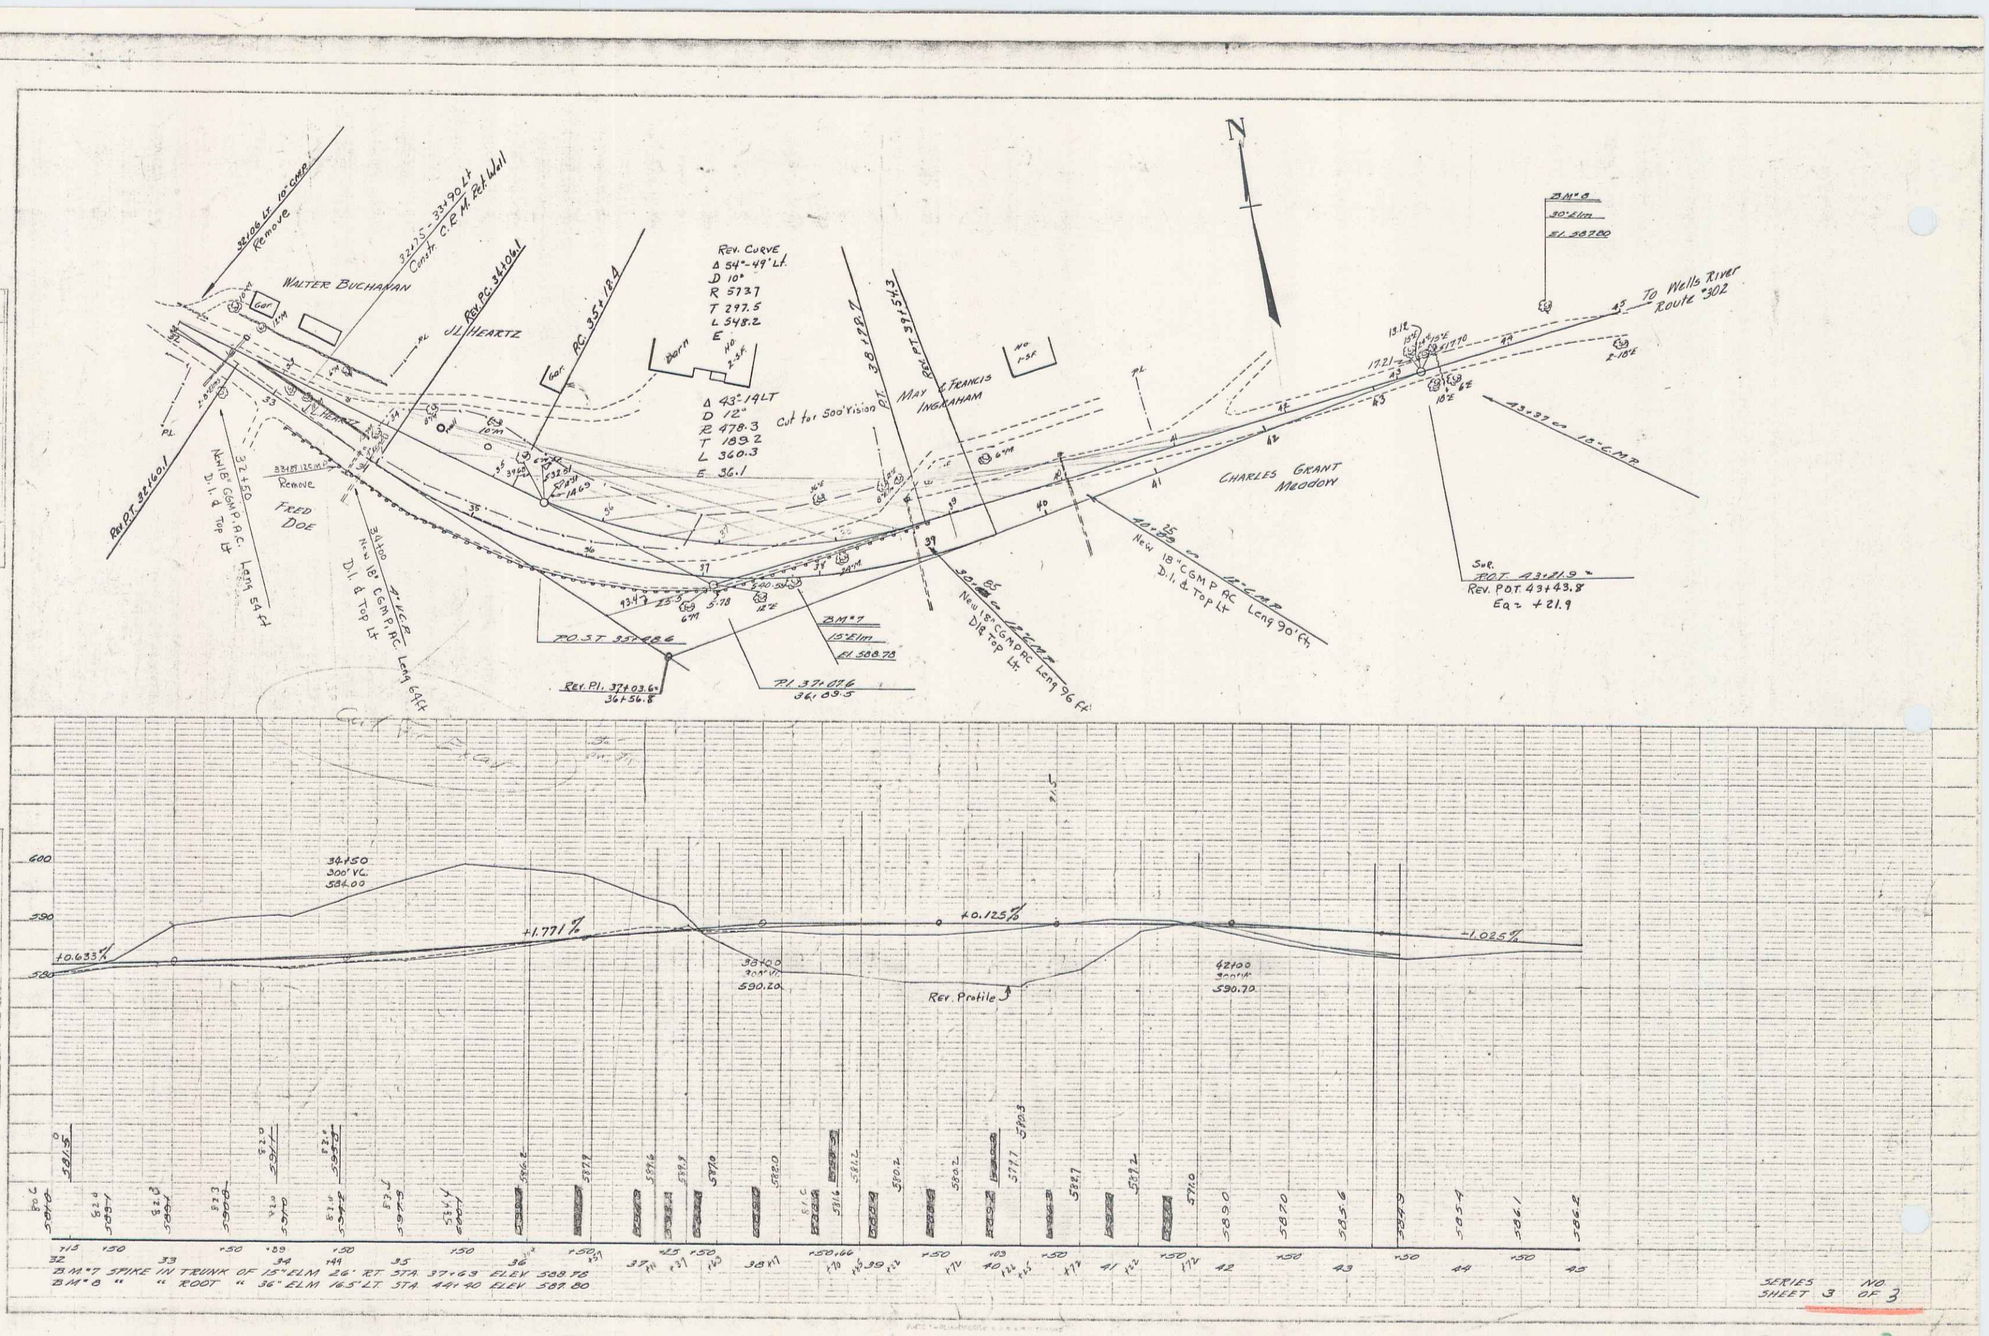
N
Rev. Curve
Δ 54°-49' Lt.
D 10°
R 573.7
T 297.5
L 548.2
E
Δ 43°-19 LT
D 12°
R 478.3
T 189.2
L 360.3
E 36.1
Cut for 500' Vision
Walter Buchanan
J.L. Heartz
Rev. Pt. 32+60.1
Remove
Fred Doe
May & Francis Ingraham
Charles Grant Meadow
To Wells River Route #302
New 18" CGMP AC Leng 90' Ft.
New 18" CGMP AC Leng 96 Ft.
New 18" CGMP AC Leng 64 Ft.
New 18" CGMP AC Leng 54 Ft.
Rev. P.O.T. 43+43.8
Eq = +21.9
P.O.T. 35+48.6
Rev. Pl. 37+03.6
36+56.8
Pl 37+07.6
36+03.5
BM #7
15" Elm
El 588.78
BM #8
30" Elm
El 587.80
34+50
300' VC.
584.00
+0.633%
+1.771%
+0.125%
-1.025%
38+00
300' VC.
590.20
42+00
300' VC.
590.70
Rev. Profile
BM #7 SPIKE IN TRUNK OF 15" ELM 26' RT STA 37+63 ELEV 588.78
BM #8 " " ROOT " 36" ELM 46' LT STA 44+40 ELEV 587.80
SERIES 3 NO
SHEET 3 OF 3

Page 3 of 3