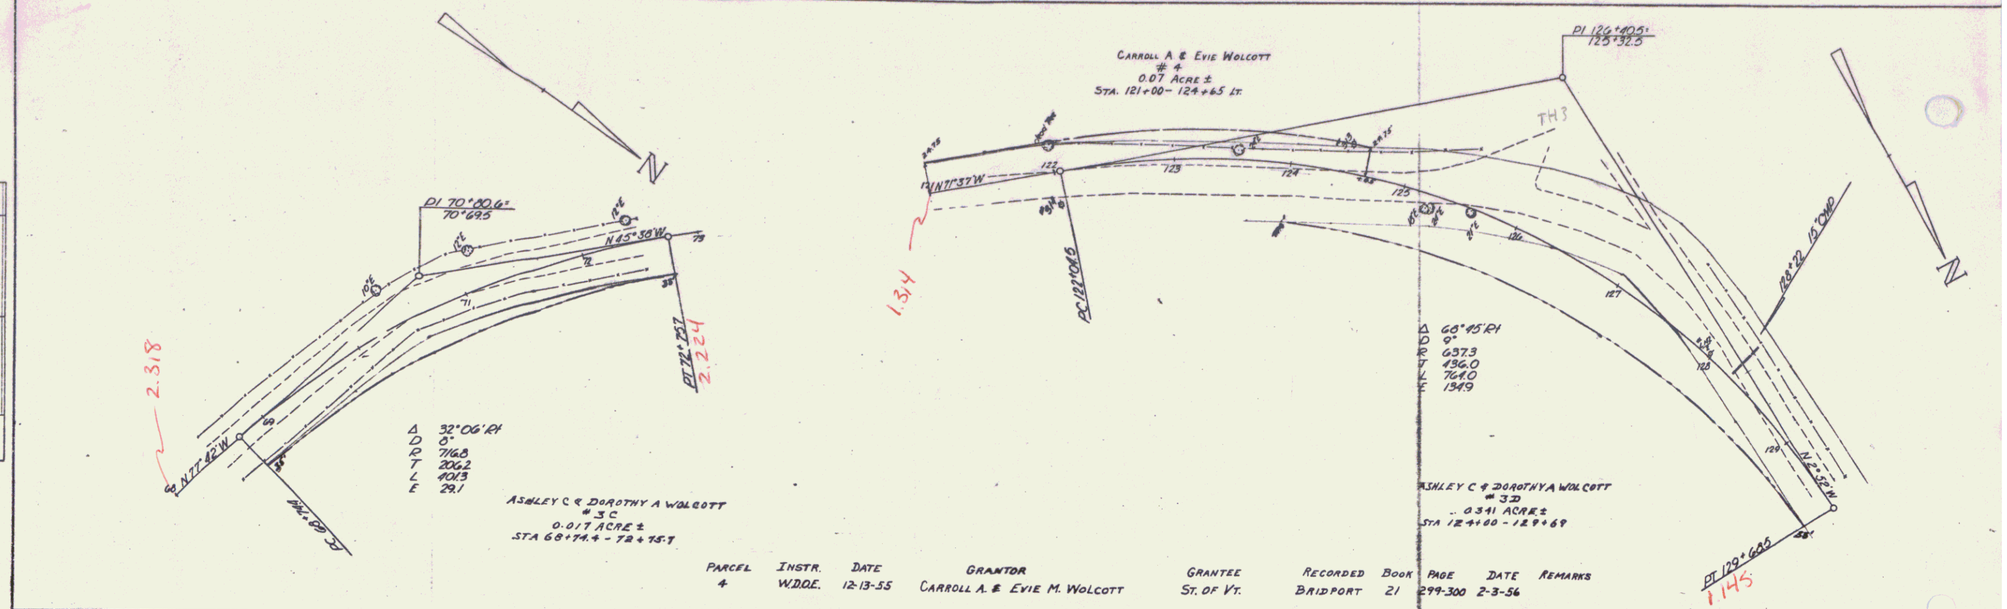

PARCEL	INSTR.	DATE	GRANTOR	GRANTEE	RECORDED	BOOK	PAGE	DATE	REMARKS
4	W.D.O.E.	12-13-55	CARROLL A. & EVIE M. WOLCOTT	ST. OF VT.	BRIDPORT	21	299-300	2-3-56	

PLAN
NOTE BOOK NO.
SURVEYED
PLOTTED
DESIGNED
CHECKED
DATE
BY

PROFILE
NOTE BOOK NO.
SURVEYED
PLOTTED
DESIGNED
CHECKED
R. W.R. NOTES
DIRECTOR OF OPERATING DIVISION
DATE
BY

BRIDPORT - ADDISON
St. 69(L)
SHEET 3

3

PLATE 1 - PLAN AND PROFILE U.P.R.R. & N.E. STANDARD
KEUFFEL & ESSER CO., NEW YORK.
No. 348-1C