



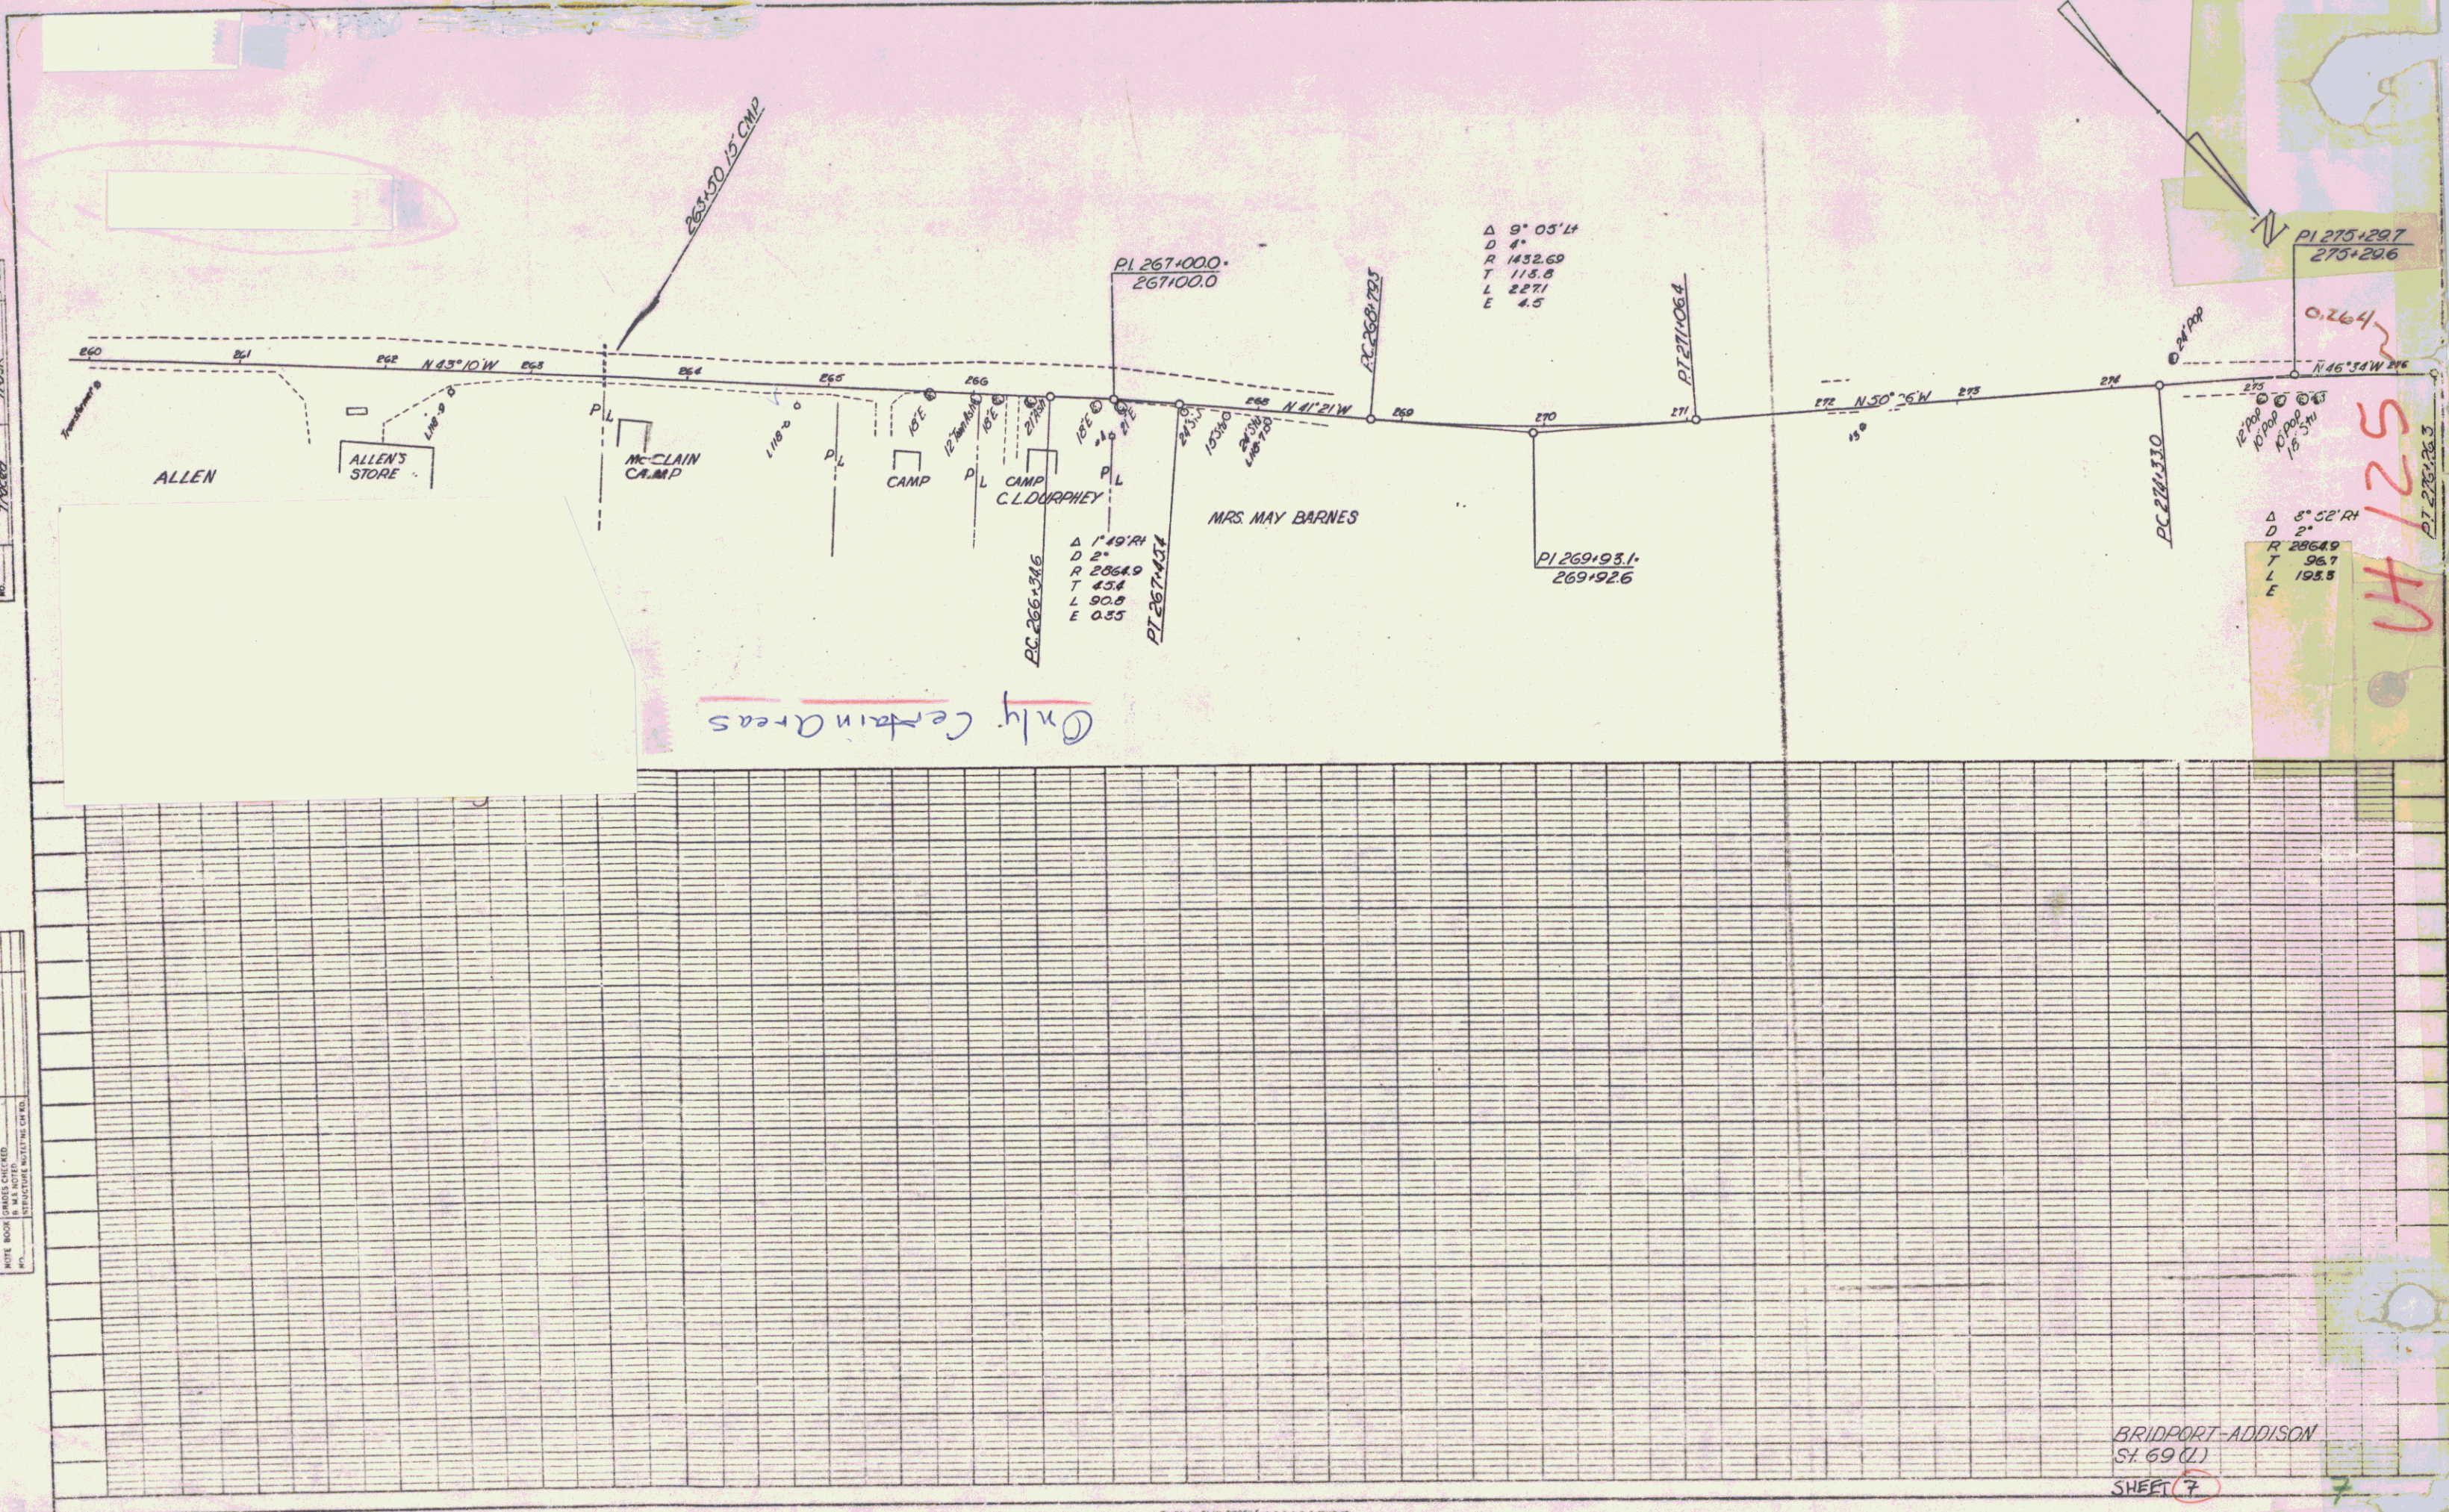


PLATE 14-PLAN-PROFILE © P.A.M. & SONS  
 MADE IN U.S.A. NEW YORK  
 1/4" = 40' PLAN  
 1" = 40' PROFILE

BRIDPORT-ADDISON  
 ST. 69 (L)  
 SHEET 7