FED. ROAD DIST. NO.	STATE	PROJ. NO.	FISCAL YEAR	SHEET NO.	TOTAL SHEETS
3	VT.	60(1)		15	76

POST WAR F A SECONDARY

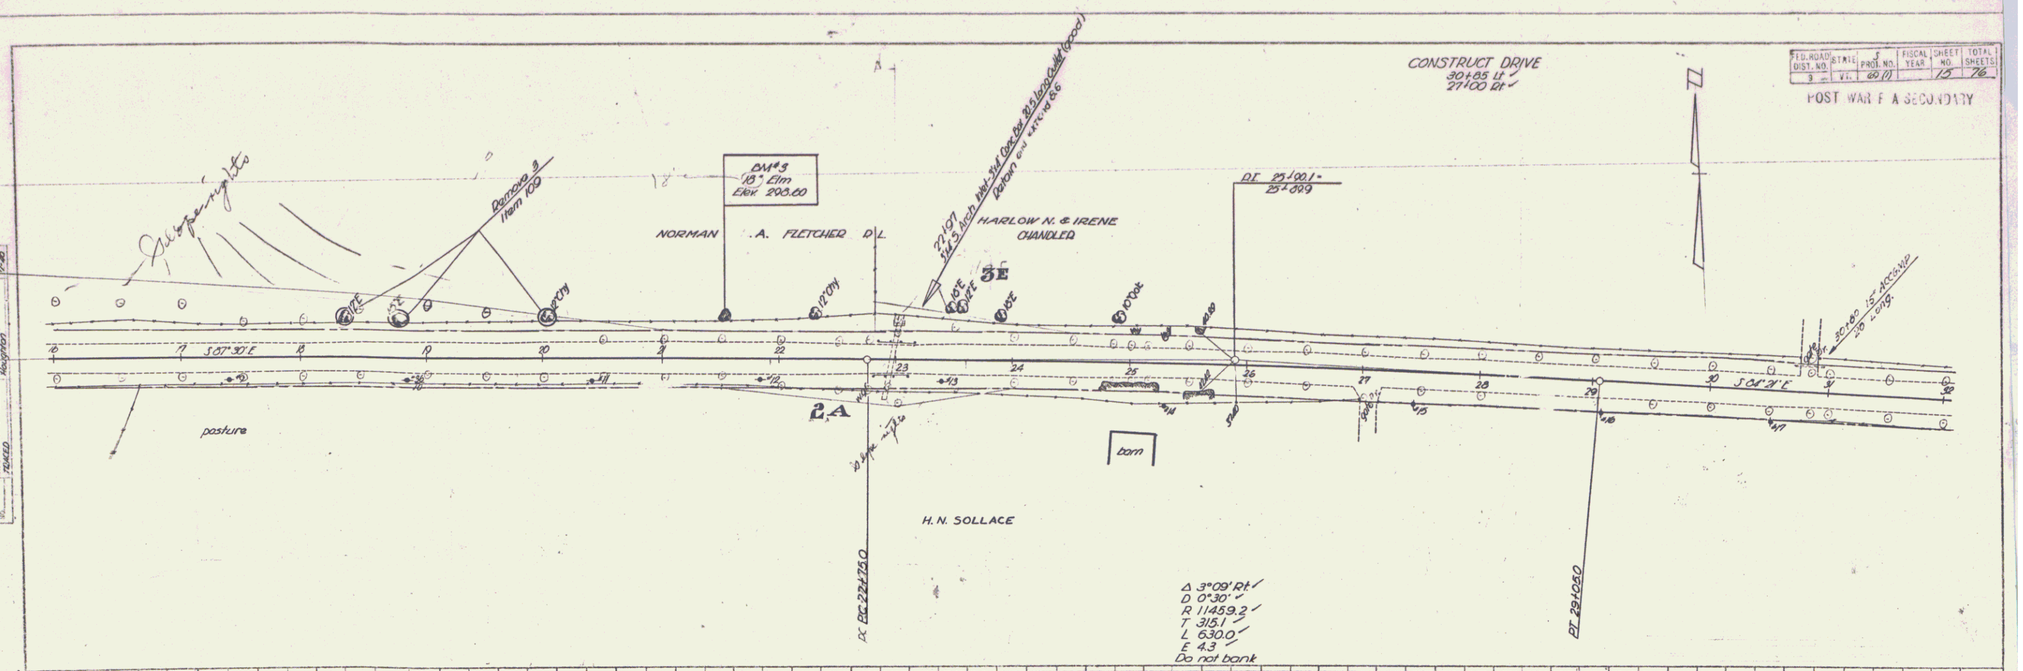

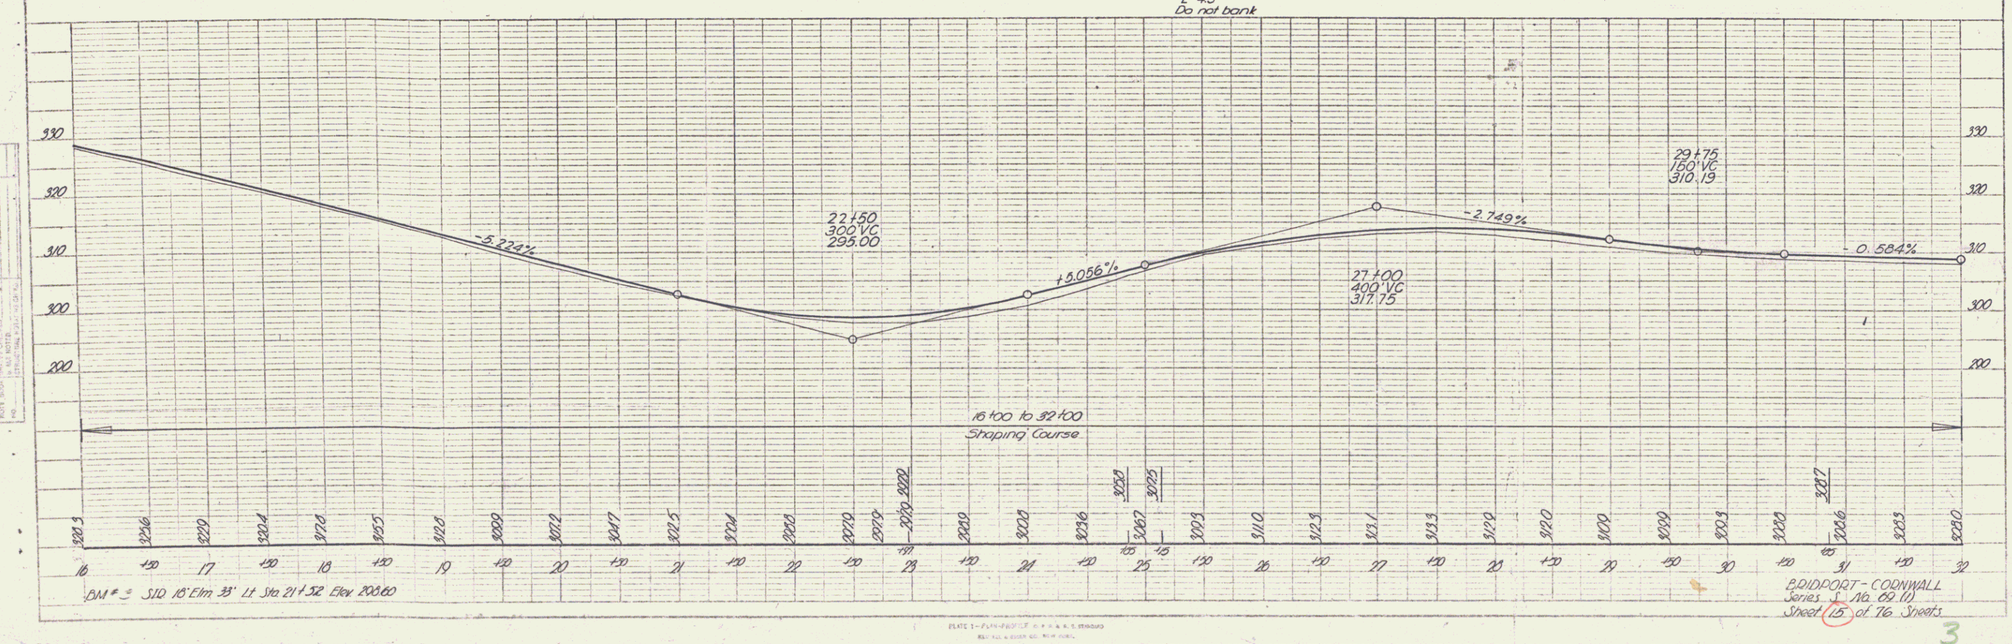

BOIDDORT - CORNWALL
Series 1 No. 60 (1)
Sheet 15 of 76 Sheets

3