FED. ROAD DIST. NO.	STATE	PROJ. NO.	FISCAL YEAR	SHEET NO.	TOTAL SHEETS
3	VT.	6011		21	76

PARCEL	INSTRUMENT	DATE	GRANTOR	GRANTEE	RECORDED BRIDPORT BOOK	PAGE	DATE	REMARKS
10 A&B	W.D.O.E.	10-28-48	HILTON E. & MILDRED M. NEWTON	ST. OF VT.	20	768-9-70	10-29-48	
11 A	W. D.	6-8-49	HUGH D. & MILDRED D. LONGEY	ST. OF VT.	21	10	6-9-49	Spring & well rights

The wall at sta. 116+70.5 is to be reconstructed by the State of Vermont Department of Highways, under the direction of E.B. Bly, District Highway Commissioner, during the construction of this project.
The contractor shall perform his operations in such a manner that the existing wall may be used until its reconstruction is complete.

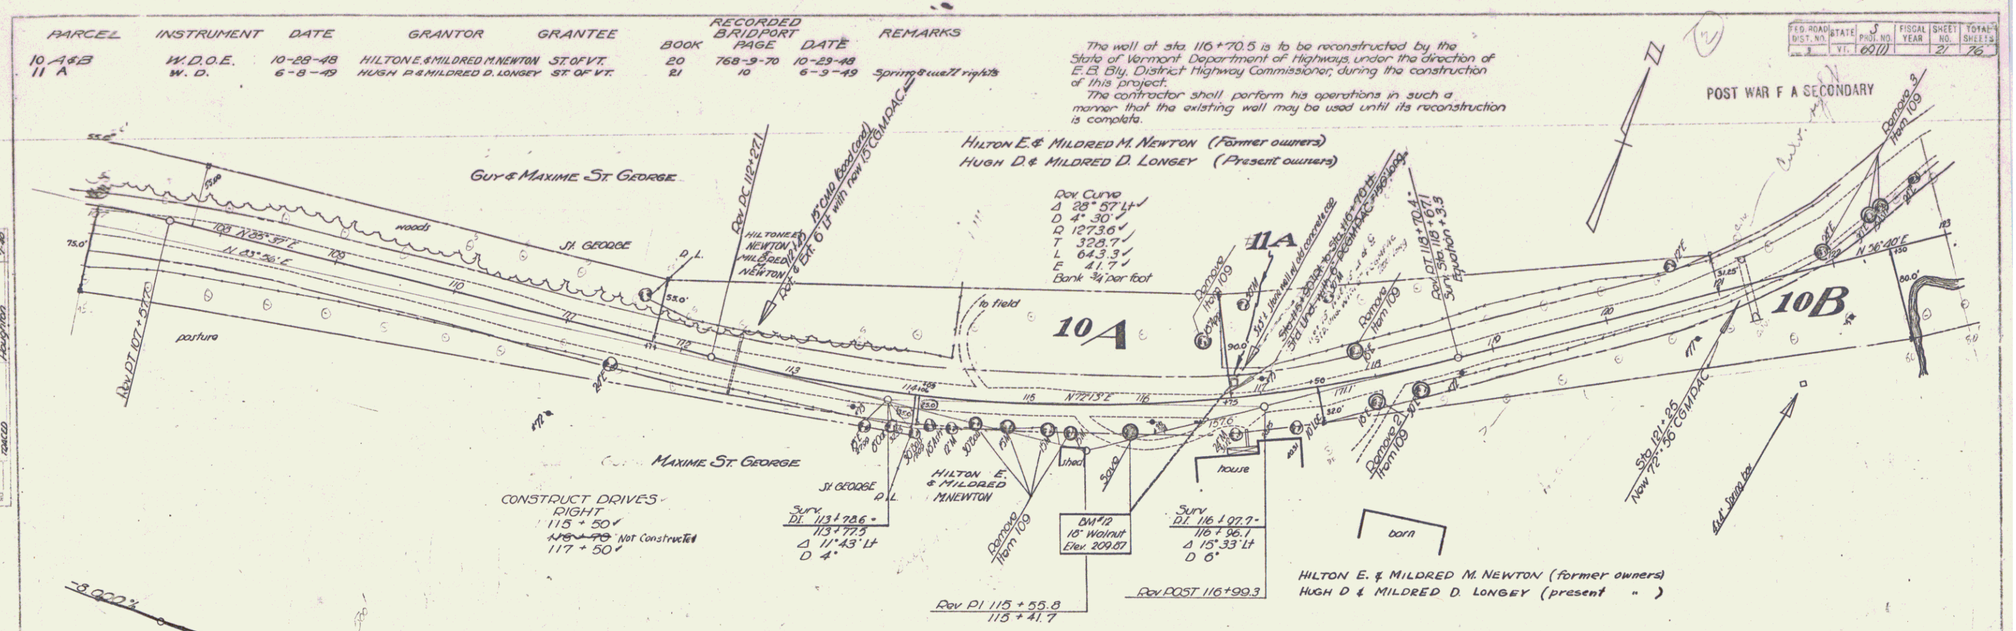

9