INDEX OF SHEETS

Sheet No.	
1	PLAN & TYPICAL SECTION
2	PROFILE
3	QUANTITY SHEET (ITEMS & DRAINAGE)
4	EARTHWORKS
5	STANDARD SHEET A-6.1 (SLOPES IN SOLID ROCK)
6	STANDARD SHEET B-5 (TYPICAL SLOPE GRADING)
7	STANDARD SHEET D-2 (HEADWALLS)
8	STANDARD SHEET E-1 (BARRICADES, SIGNS, & LIGHTS)
9	STANDARD SHEET G-3 (THREE CABLE GUARD RAIL)
10	STANDARD SHEET G-4 (MARKER POSTS)
11	STANDARD SHEET J-1 (BOUNDARY MARKERS)
12-20	CROSS-SECTIONS
4-A	FINAL EARTHWORKS
20A-C	GRAVEL SECTIONS
20D-F	LEDGE SECTIONS

TOWN OF MIDDLEBURY
COUNTY OF ADDISON
VERMONT ROUTE #125
MIDDLEBURY - RIPTON ROAD

BEGINNING AT A POINT APPROXIMATELY ONE-TENTH OF A MILE EASTERLY OF TOWN HIGHWAY #35 AND EXTENDING EASTERLY 0.152 MILES.

LENGTH OF PROJECT = 800 FEET = 0.152 MILES.

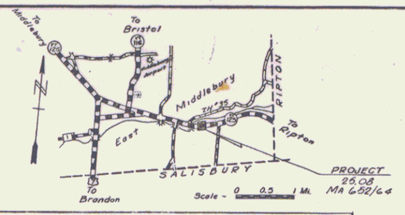

TYPICAL SECTION

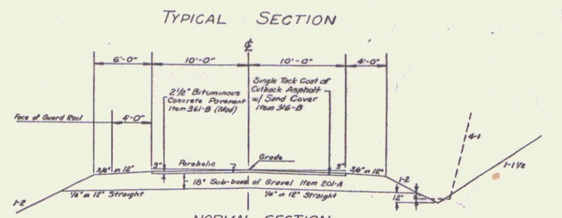

NORMAL SECTION w/ GUARD RAIL

PROJECT NAME & NUMBER E. MIDDLEBURY M.A. 625/25.08/64. RECORD PLANS MATERIALS ASPH. CTD. CORR. GALV. METAL PIPE — NEW ENGLAND CULVERT CO. — WHITE RIVER JCT., VT. SUBBASE OF GRAVEL — FOSTER PIT — MIDDLEBURY, VT.	CONTRACTOR — EARLE B. MERRY, INC. RUTLAND, VT. RES. ENG. — WAYNE LAWRENCE. RECORD PLANS — A. G. SPIDLE. CONTRACT — DATED — AUGUST 26, 1964. STARTED — AUG. 28, 1964. COMPLETED — NOVEMBER 2, 1964. ACCEPTED — NOVEMBER 2, 1964.

NOTE: Sta. 0+50 - Sta 5+95: 4" C.I.P. Water main is located on left edge of road. Sta 5+95-10' Lt - Sta 15+00 - 4" C.I.P. water main is located between the ℄ of the old road and the guard rail on the left. In the area of the slide (7+00 - 7+95) the water main is under the guard rail.

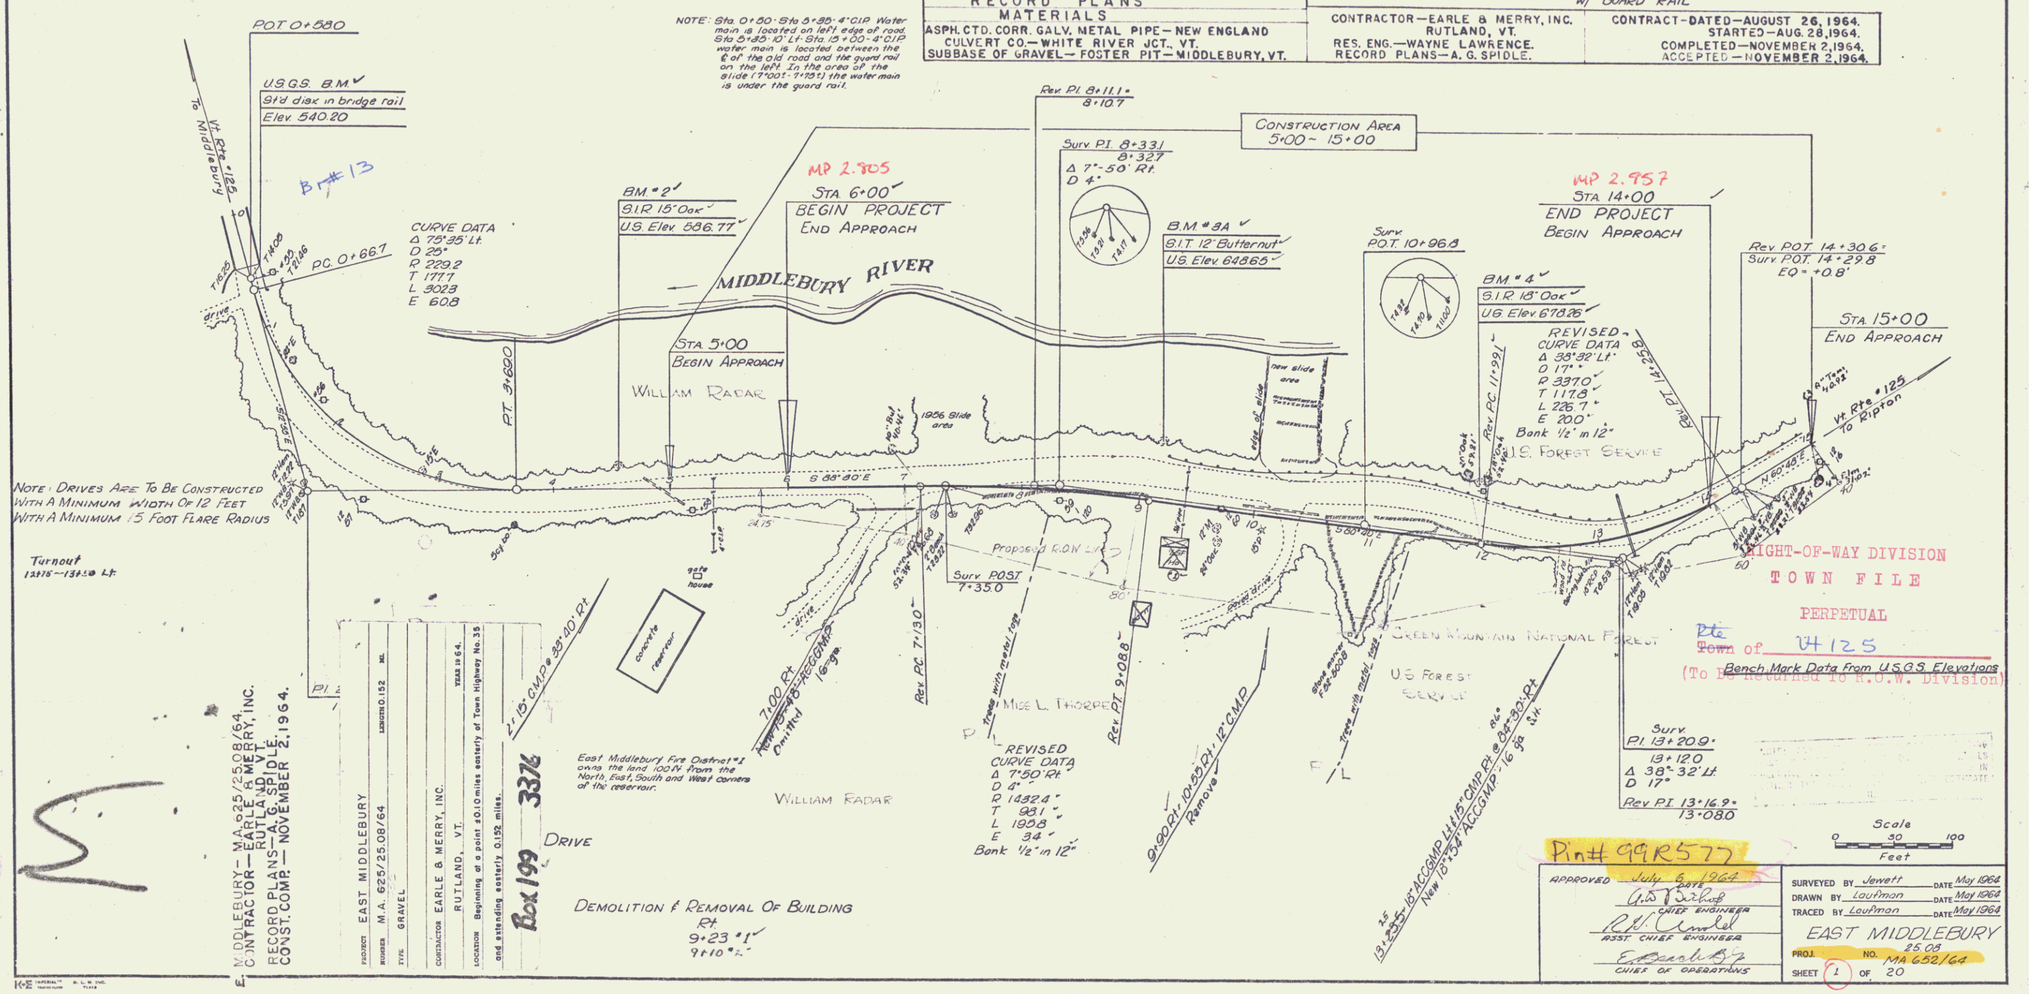

N. MIDDLEBURY - M.A. 625/25.08/64.
CONTRACTOR — EARLE B. MERRY, INC.
RUTLAND, VT.
RECORD PLANS — A. G. SPIDLE.
CONST. COMP. — NOVEMBER 2, 1964.

PROJECT EAST MIDDLEBURY
ISSUED M.A. 625/25.08/64 LENGTH 0.152 MI.
TYPE GRAVEL
CONTRACTOR EARLE B. MERRY, INC.
RUTLAND, VT. YEAR 19 64.
LOCATION Beginning at a point ±0.10 miles easterly of Town Highway No. 35 and extending easterly 0.152 miles.

Box 199 3376

DRIVE

DEMOLITION & REMOVAL OF BUILDING
Rt
9+23 "L"
9+10 "L"

Pin# 99R577

APPROVED July 6, 1964
G. D. Aiken DATE
CHIEF ENGINEER
P. W. Cumbel
ASST. CHIEF ENGINEER
E. Bank Bp
CHIEF OF OPERATIONS

SURVEYED BY Jewett DATE May 1964
DRAWN BY Loutman DATE May 1964
TRACED BY Loutman DATE May 1964

EAST MIDDLEBURY
PROJ. NO. 25.08 MA 632/64
SHEET 1 OF 20

RIGHT-OF-WAY DIVISION
TOWN FILE
PERPETUAL
Rte
~~Town~~ of VT 125
(To be returned to R.O.W. Division)
Bench Mark Data from U.S.G.S. Elevations