Construct Turnout
Lt. Rt.
44+50 ~ 45+60

PARCELS 1A, 1B, 1C HIGHWAY EASEMENT DEED
PARCELS 2A, 2B, 2C WARRANTY DEED of easement
PARCELS 3A & 3B WARRANTY DEED OF EASEMENT
PARCEL 4 WARRANTY DEED ~~OF~~ Easement

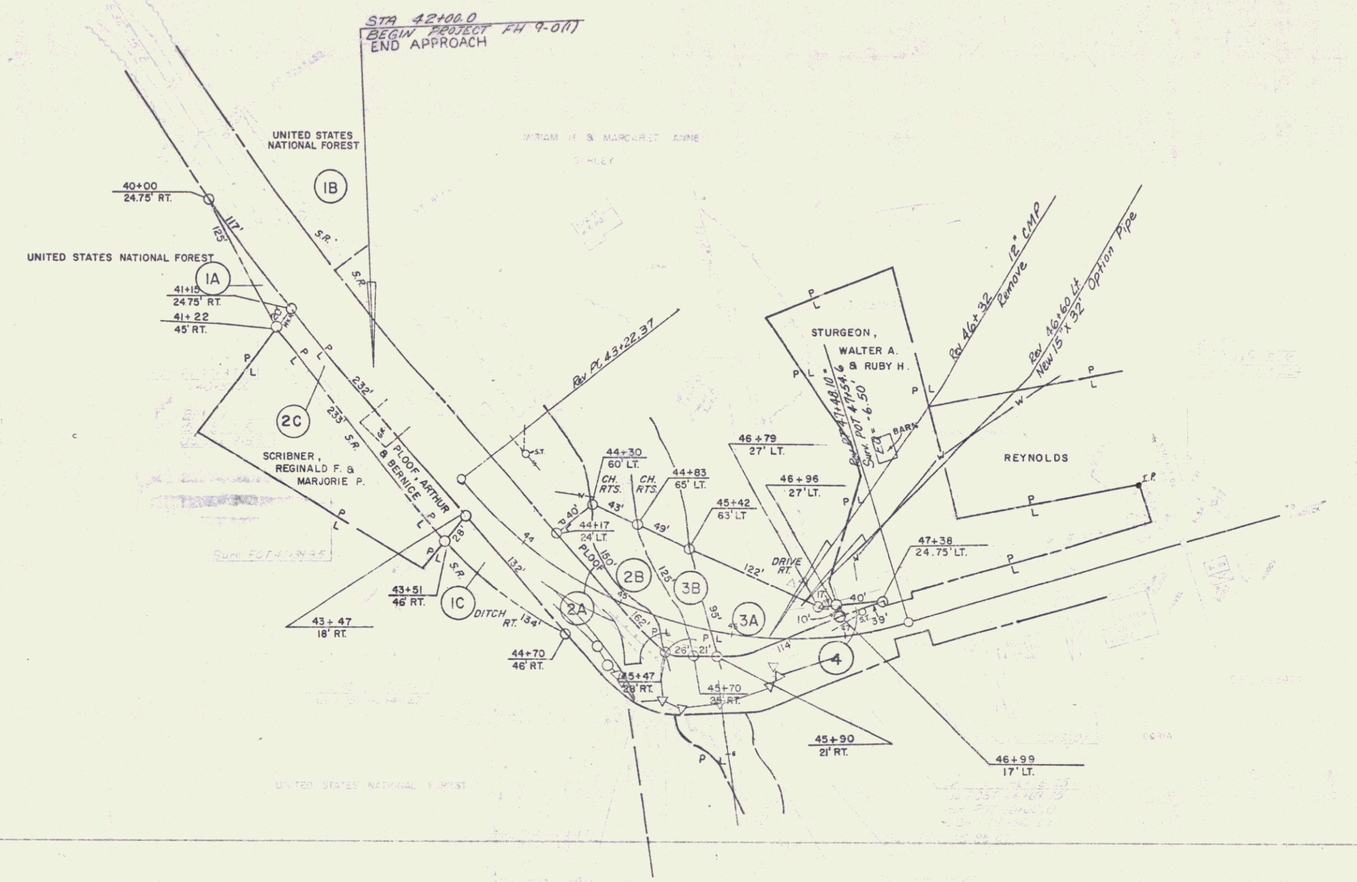

EXCAVATION AND REMOVAL OF ROAD SURFACES AND PAVEMENTS
Rt.
46+40 ~ 47+00

5 5

3