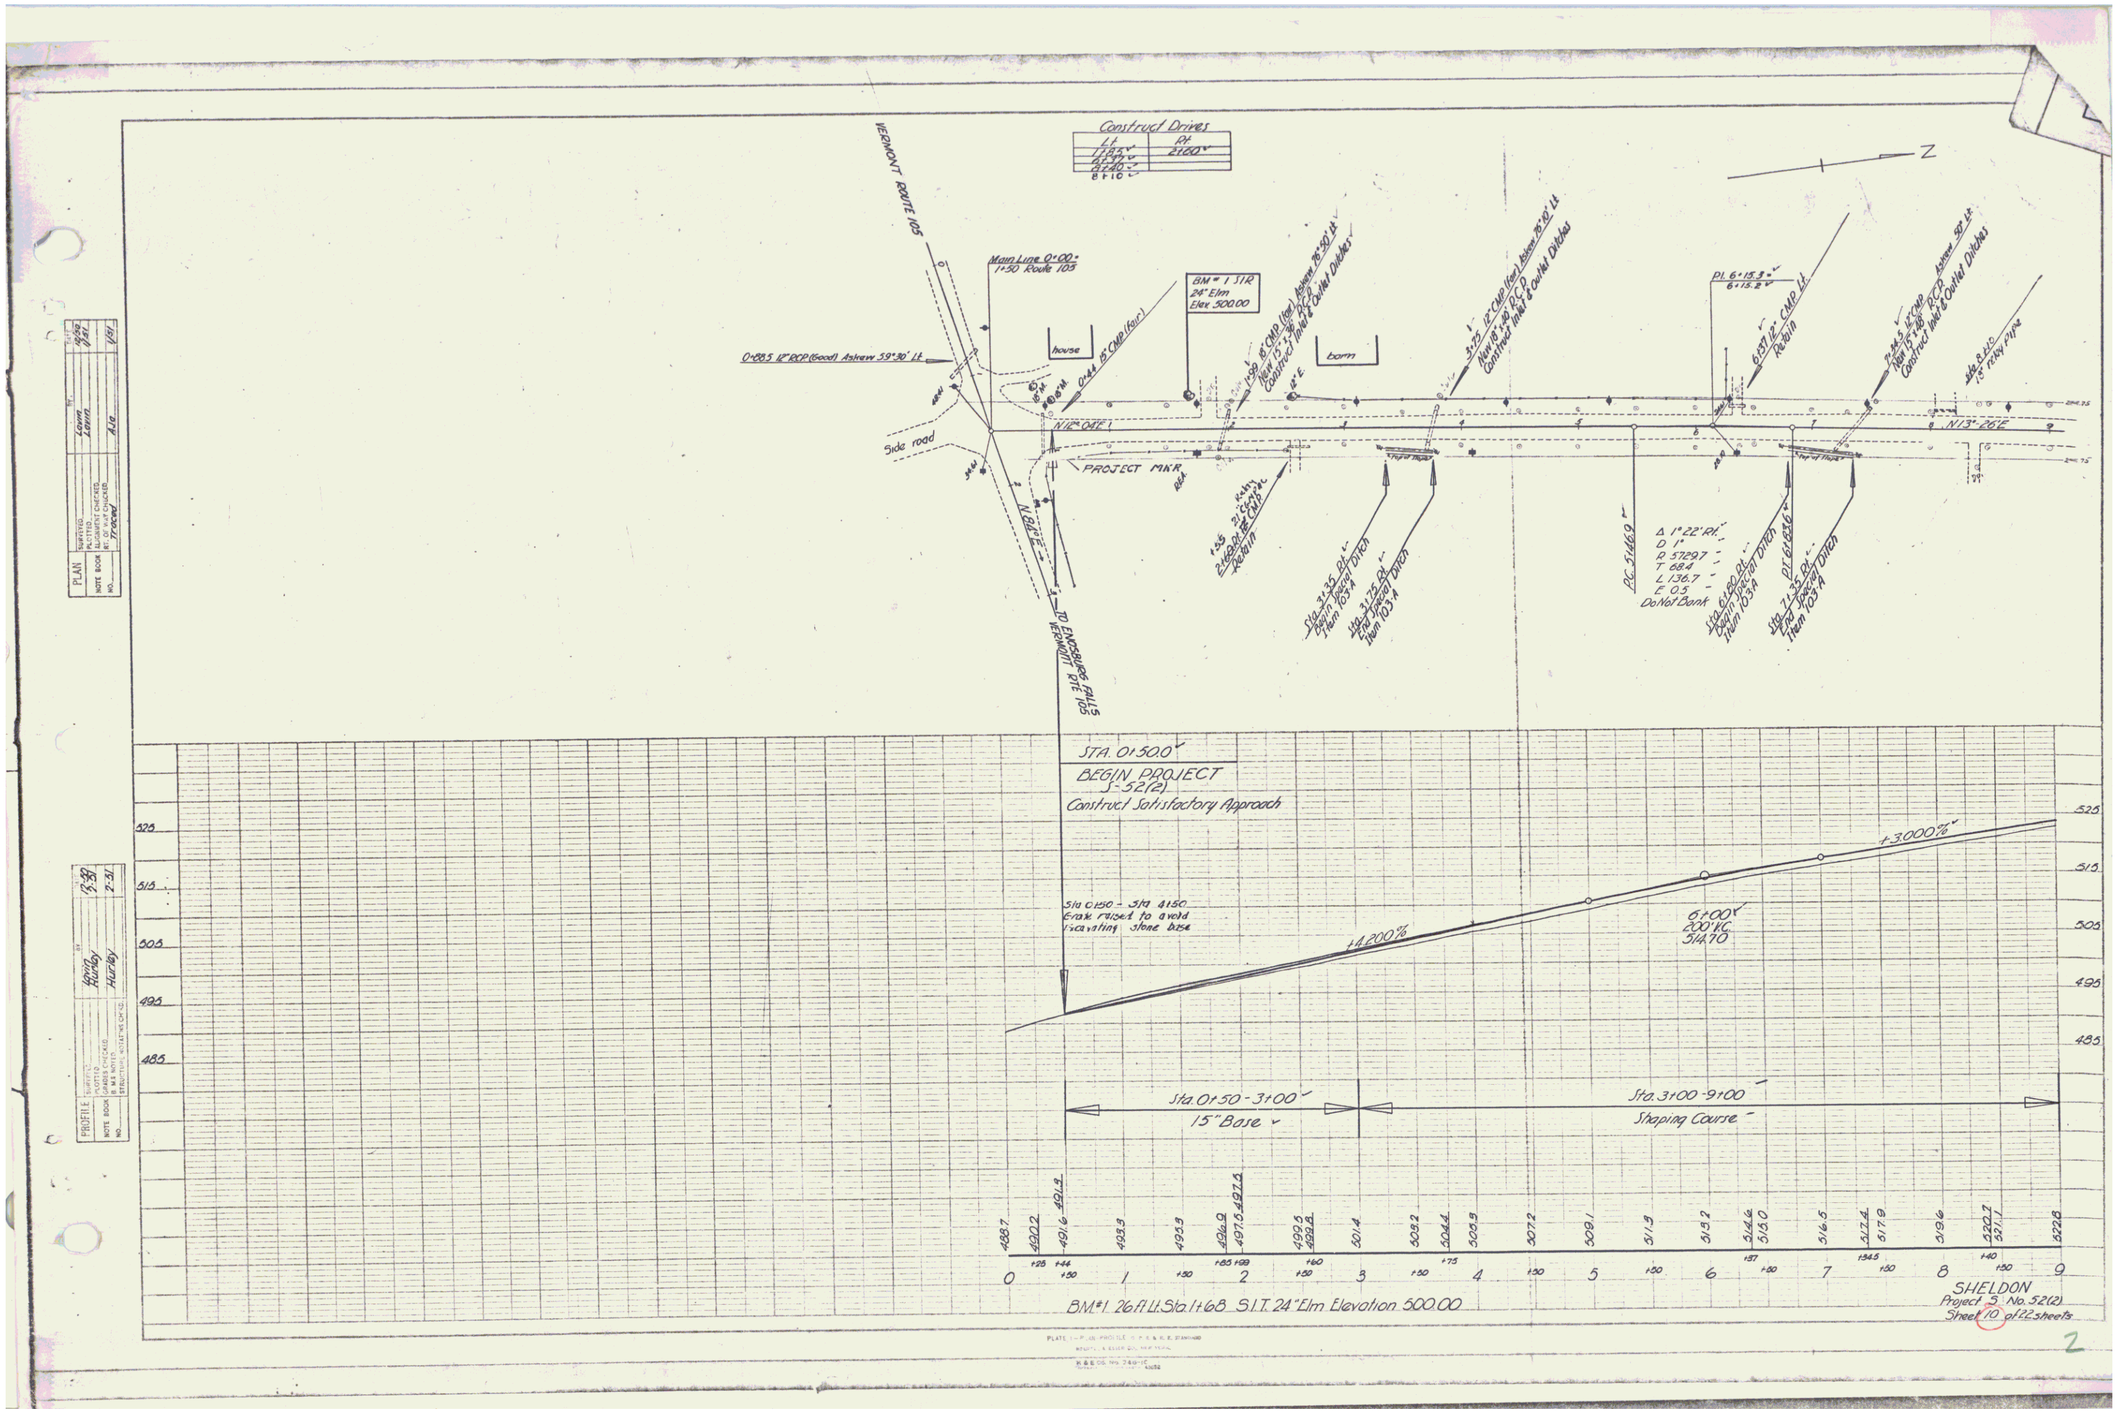

PLAN
SURVEYED
PLOTTED
NOTE BOOK
ALIGNMENT CHECKED
BY & NOTES
BY CHECKED
NO.
TRACED
Lamm 5/62
Kavin 8/62
Alg. 1/63

PROFILE
SURVEYED
PLOTTED
NOTE BOOK
PROFILE CHECKED
BY & NOTES
STRUCTURE NOTES CHECKED
NO.
Kavin 12/59
Hurley 12/59
Hurley 2-61

PLATE 1—PLAN PROFILE C.P.R. & R.R. STANDARD
ROYAL & ASLER CO., NEW YORK
K & E DG. No. 240-11 K&E