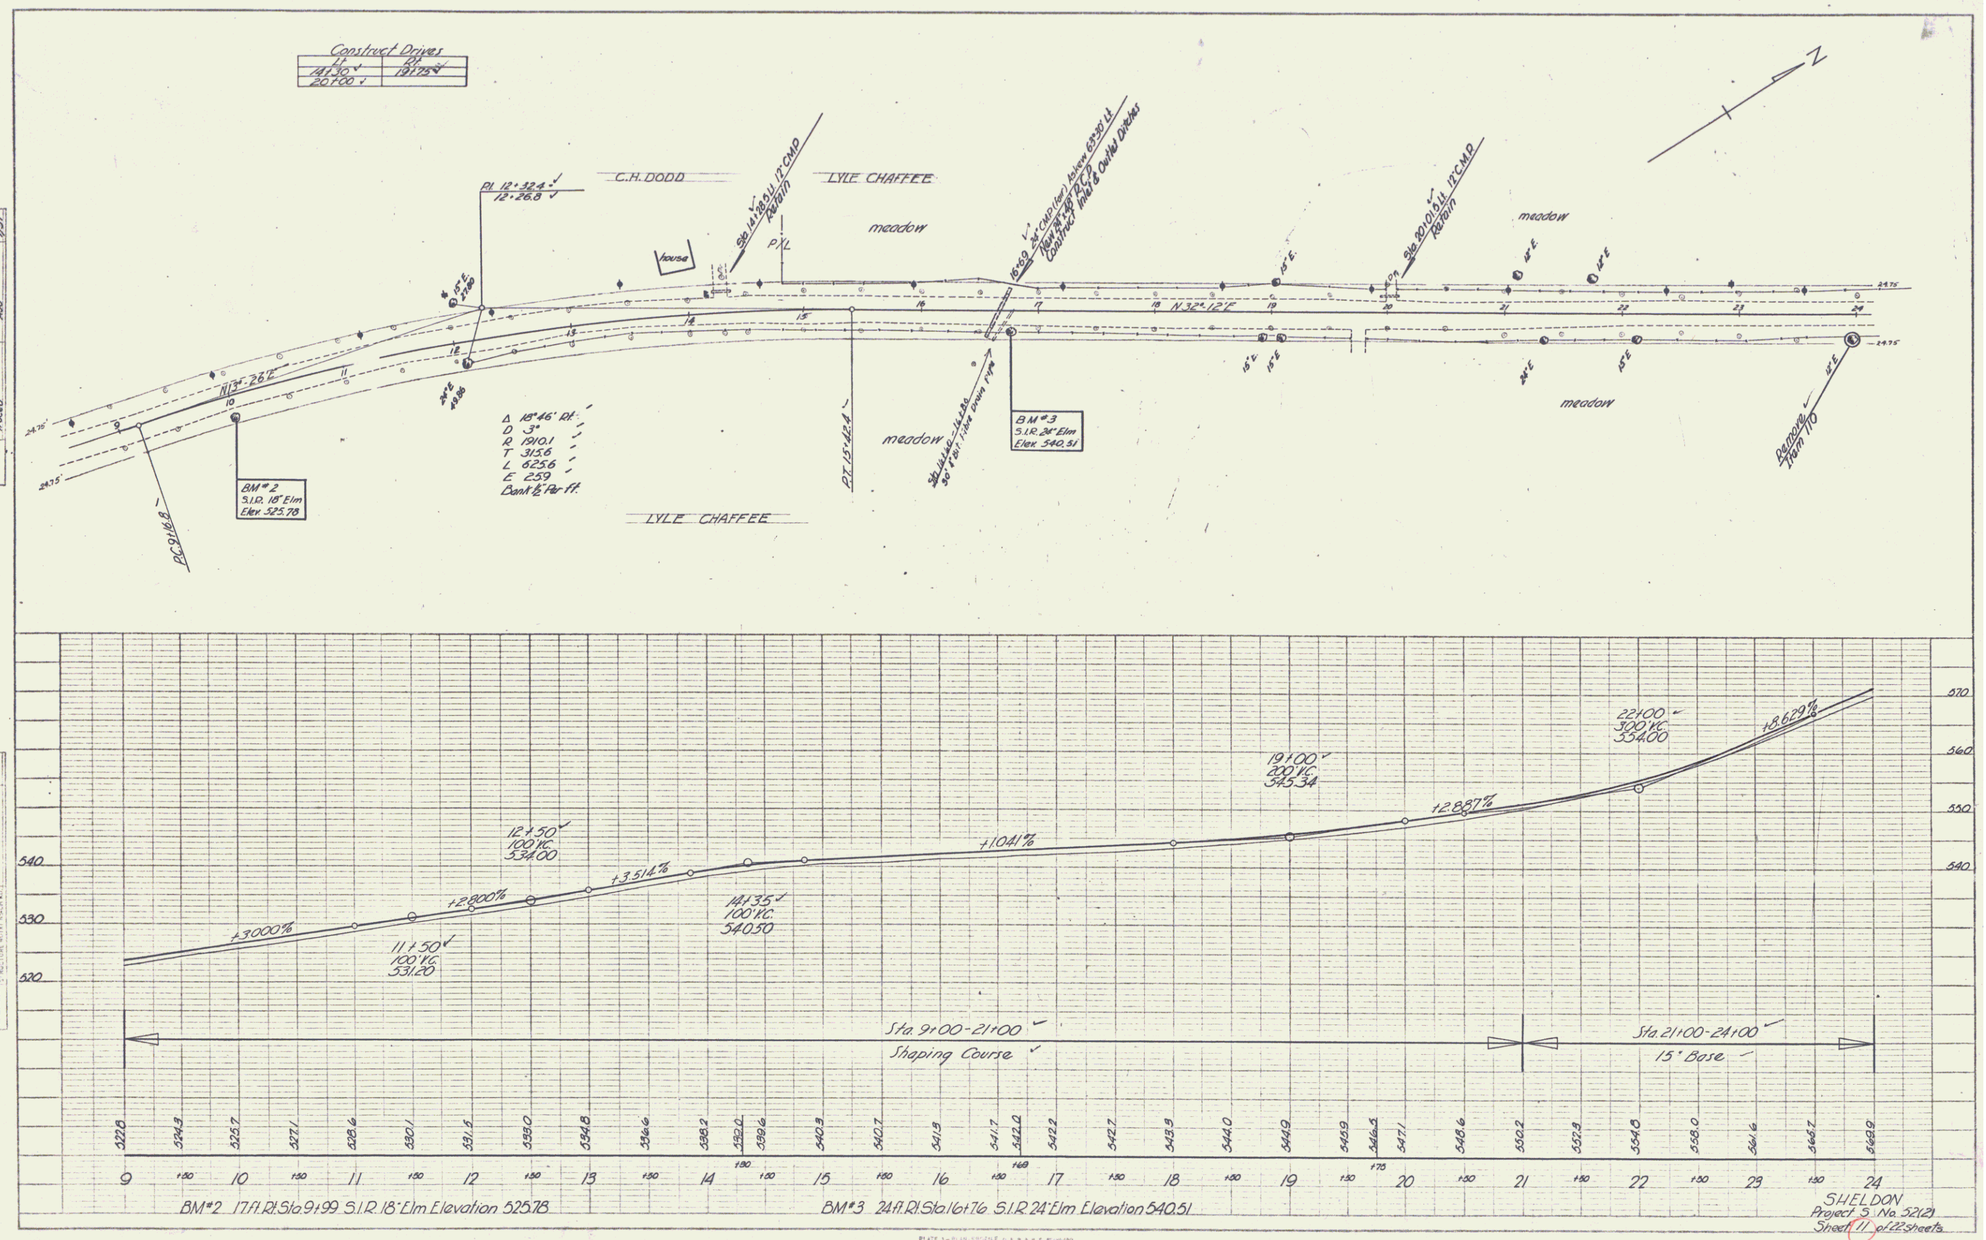
Construct Drives
14+50
20+00
Rt
19+75
C.H. DODD
LYLE CHAFFEE
meadow
house
P.L.
Sta. 14+18.5 Lt. 12" CMP
Sta. 20+10.5 Lt. 12" CMP
15+59 24" CMP (Bad) Above 63+35 Lt.
16+14 Rt. 24" RCP
Construct Inlet & Outlet Ditches
Rt 12+32.4
12+26.8
N 13° 26' E
N 32° 12' E
Δ 18°46' Rt.
D 3°
R 1910.1
T 315.6
L 625.6
E 25.9
Dsnt. ½ Par Ff.
BM #2
S.I.R. 18" Elm
Elev. 525.78
BM #3
S.I.R. 24" Elm
Elev. 540.51
PT 15+42.4
Remove Item 110
LYLE CHAFFEE
Sta. 9+00-21+00
Shaping Course
Sta. 21+00-24+00
15" Base
+3.000%
+2.800%
+3.514%
11+50
100' V.C.
531.20
12+50
100' V.C.
534.00
14+35
100' V.C.
540.50
19+00
200' V.C.
545.34
22+00
300' V.C.
554.00
BM #2 17 ft. Rt. Sta. 9+99 S.I.R. 18" Elm Elevation 525.78
BM #3 24 ft. Rt. Sta. 16+76 S.I.R. 24" Elm Elevation 540.51
SHELDON
Project S. No. 5212
Sheet 11 of 22 Sheets