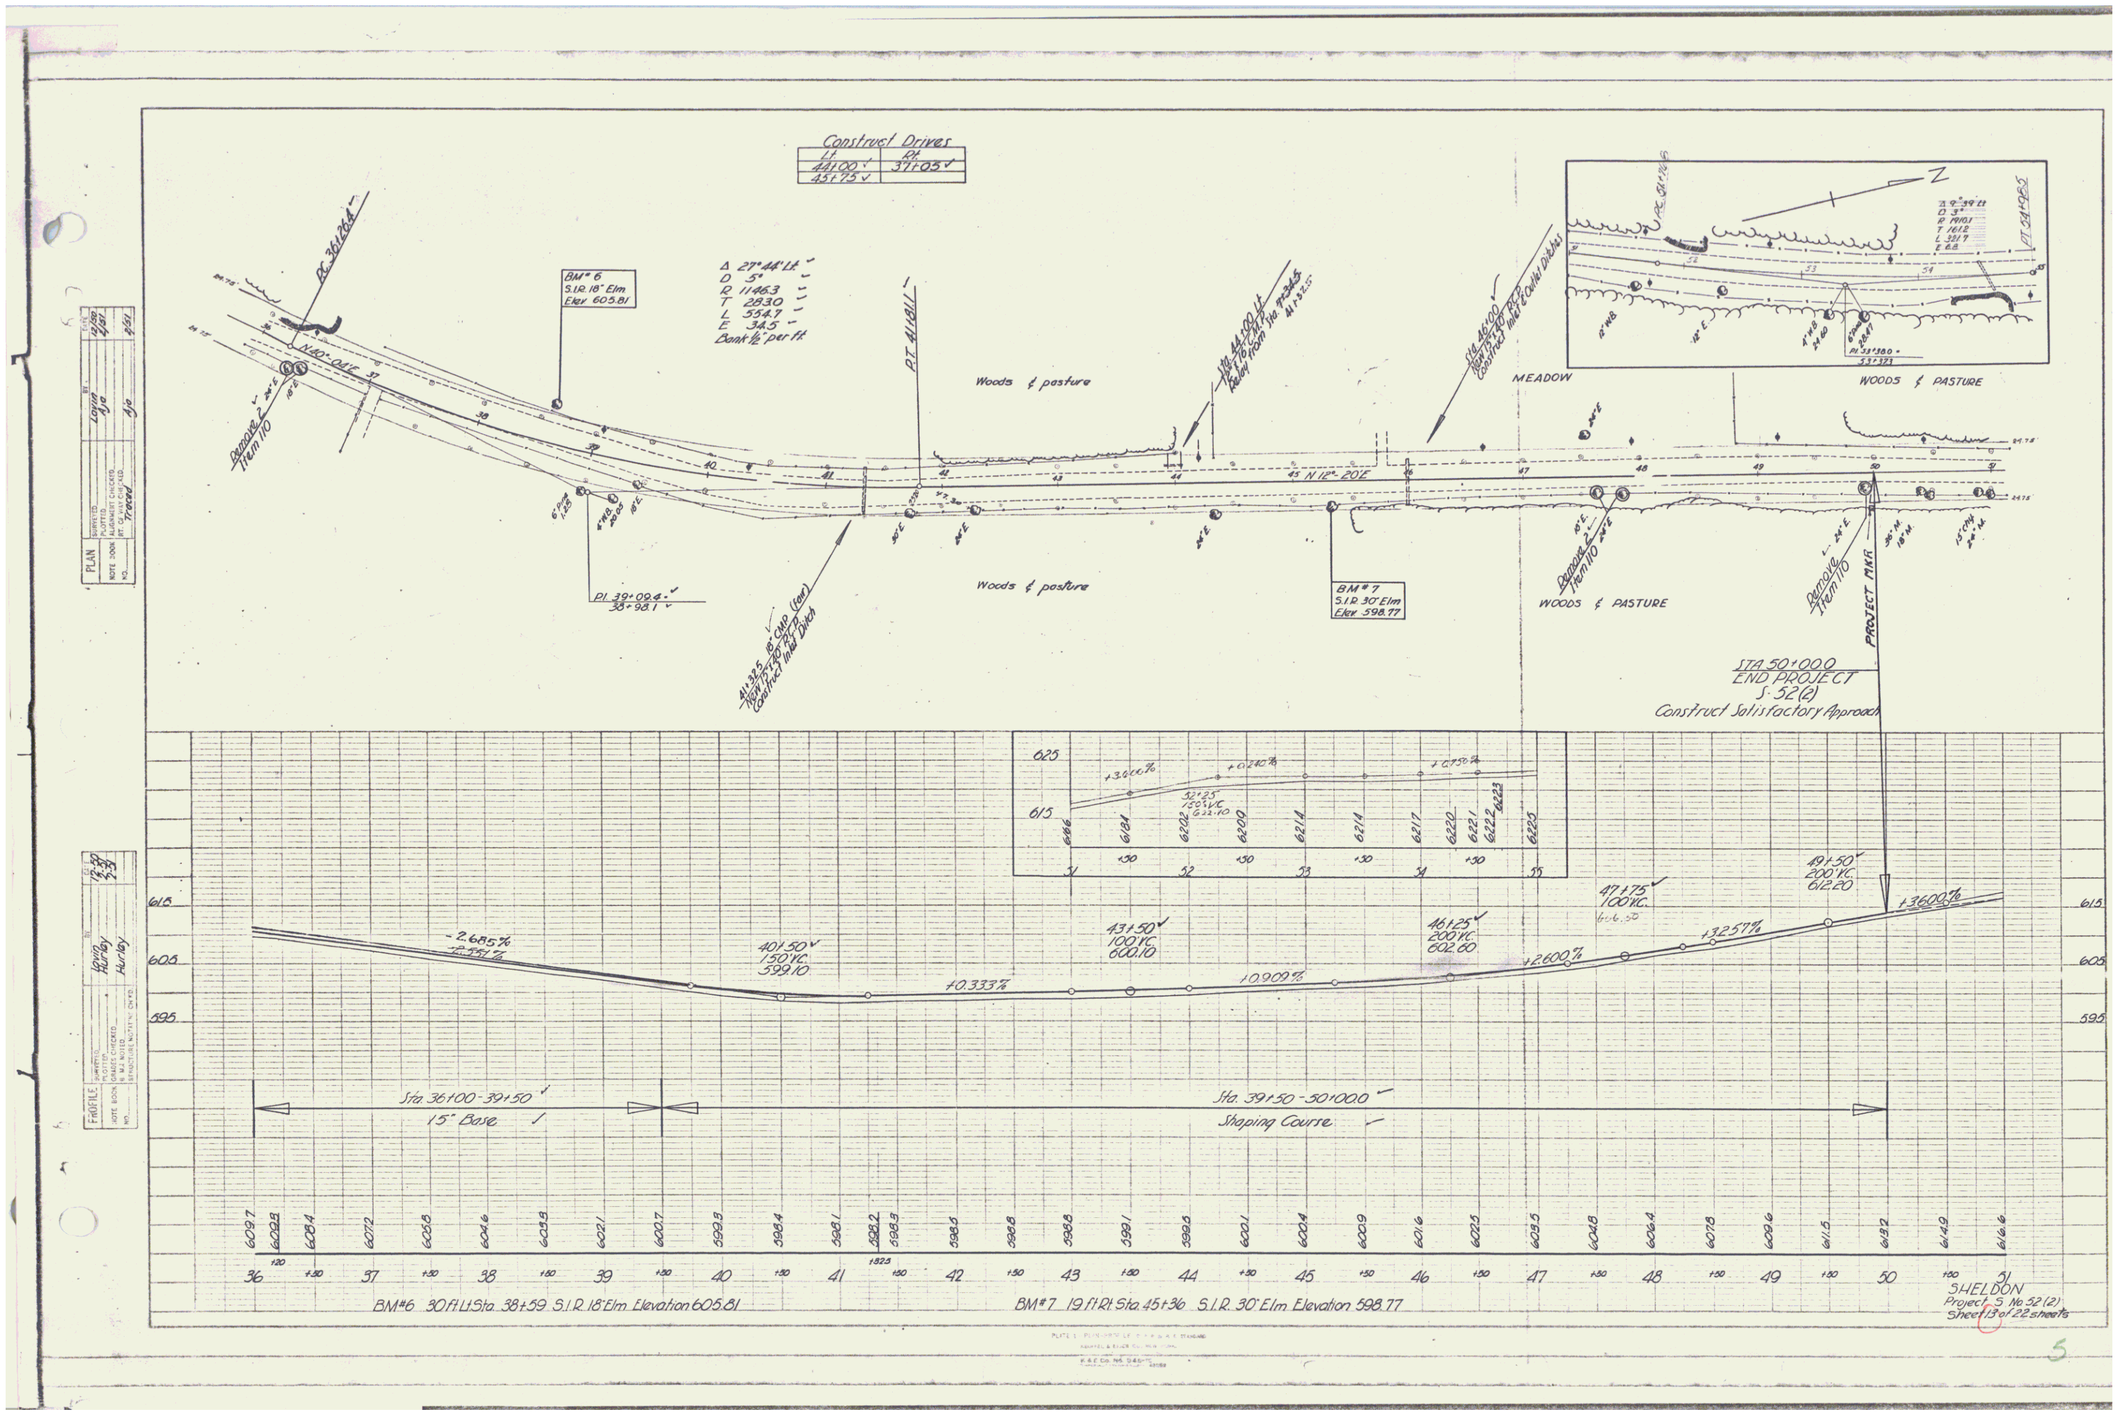

PLAN
Logged By
Traced By
NOTE BOOK
NO.

PROFILE
Graded By
Checked By
NOTE BOOK
NO.

5