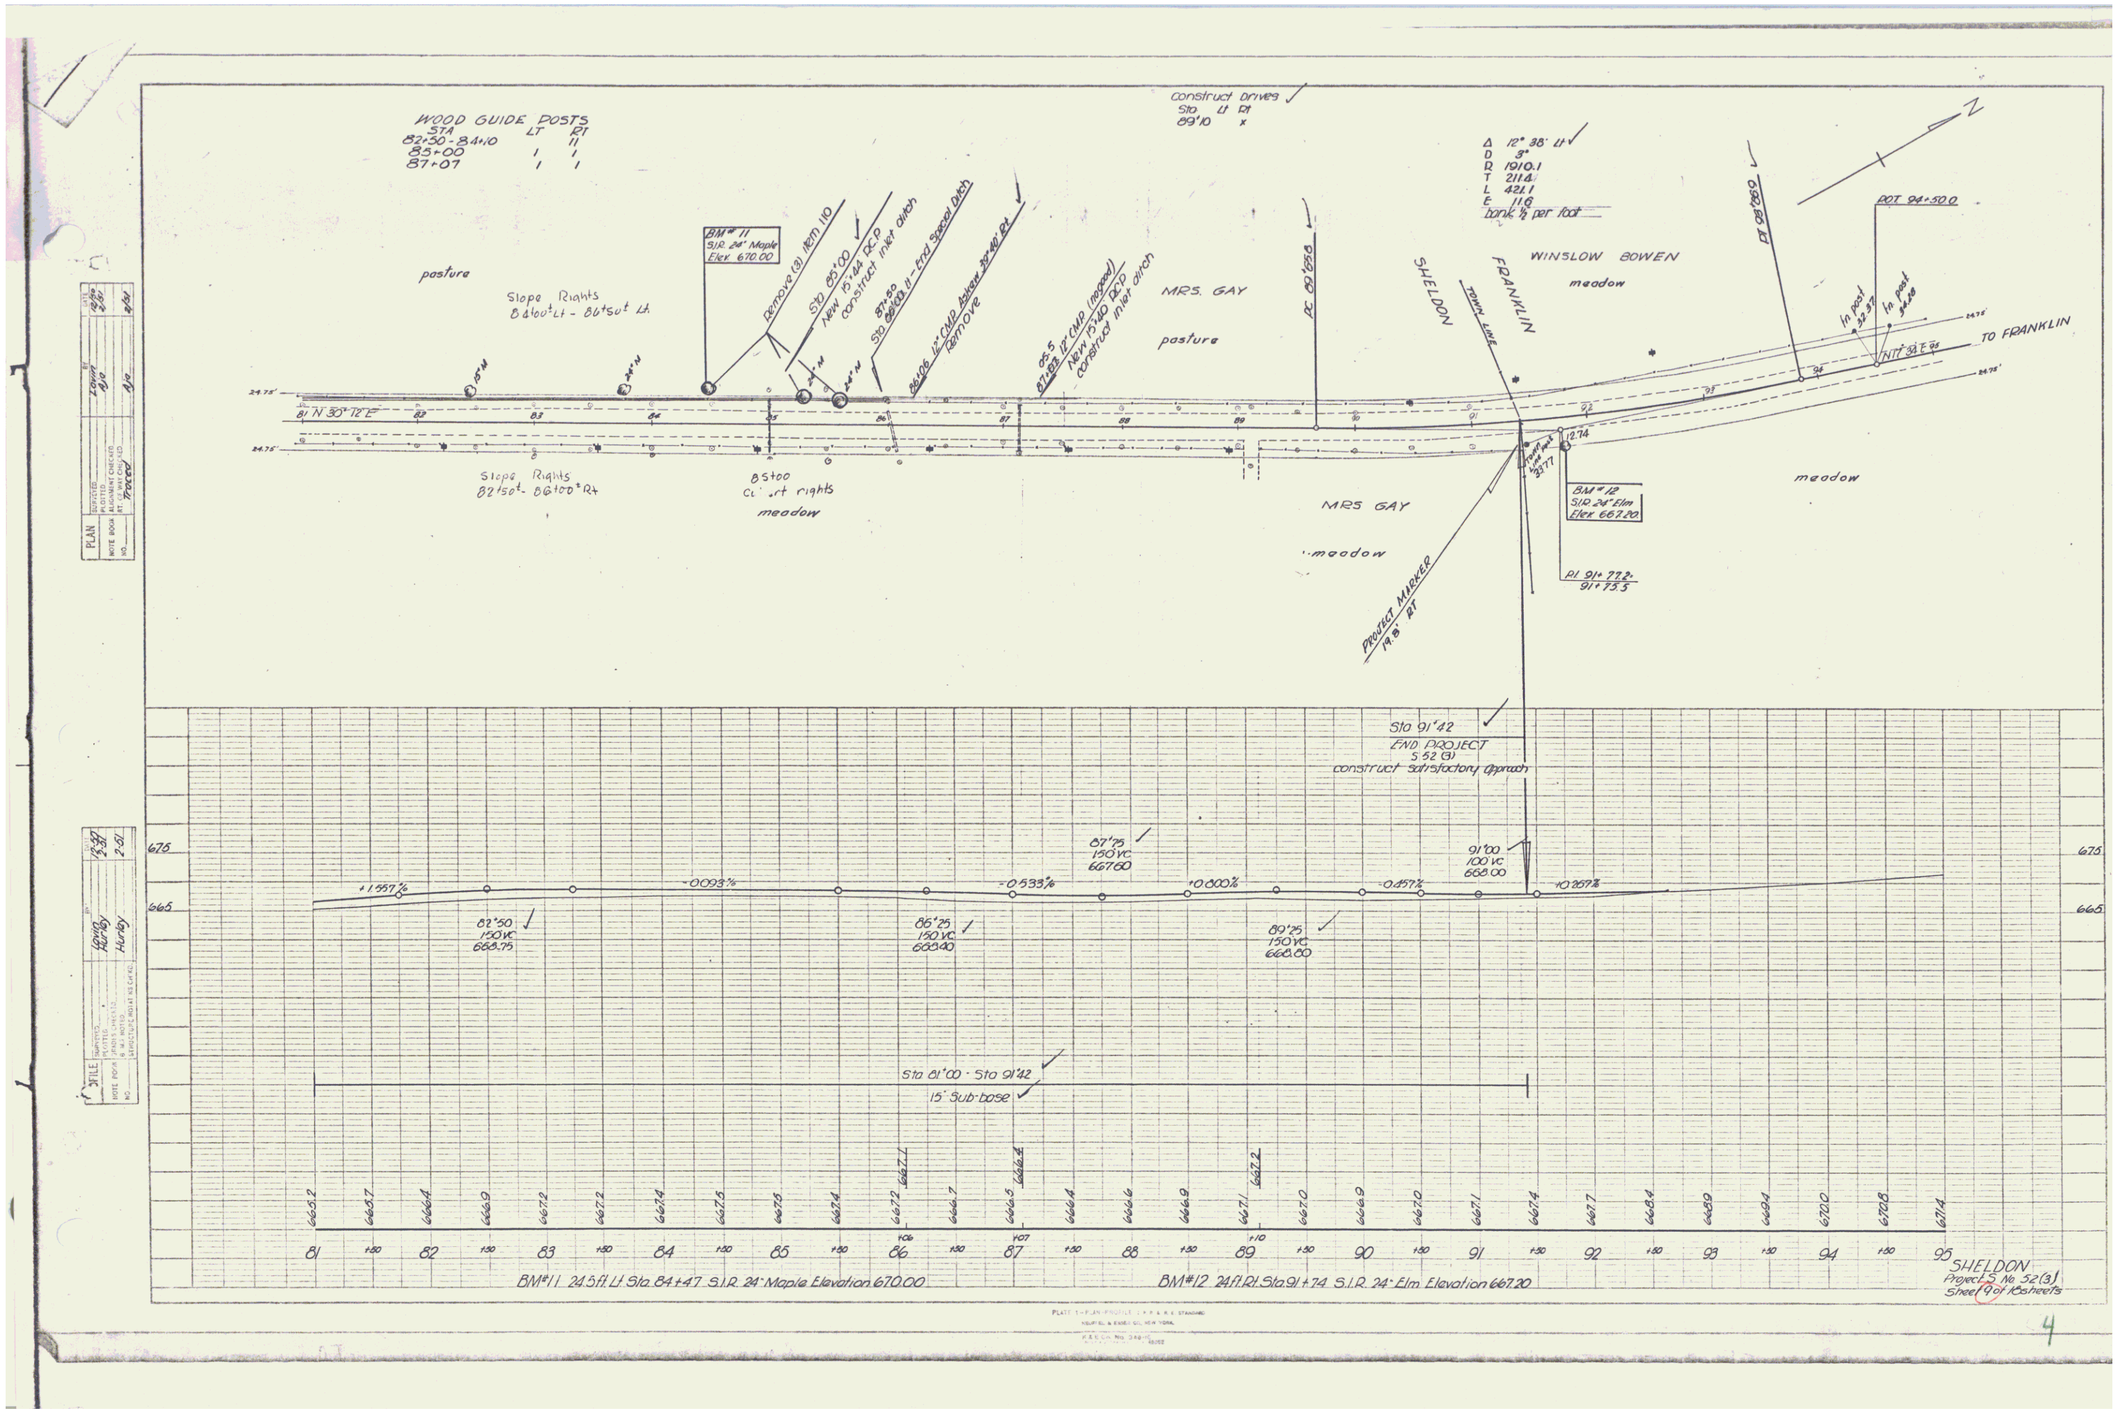
WOOD GUIDE POSTS
STA LT RT
82+50 - 84+10 1 1
85+00 1 1
87+07 1 1
pasture
Slope Rights
84+00 Lt - 86+50 Lt
BM # 11
S/R 24" Maple
Elev. 670.00
Remove (8) item 110
STA 85+00
New 15" RCP
construct inlet ditch
STA 87+50
STA 88+00 11' End Special Ditch
88+06 12" CMP Skewed 30° 40' Rt
Remove
85.5
87+00 12" CMP (repaired)
New 15" RCP
construct inlet ditch
MRS. GAY
pasture
PC 89+55
Construct drives
Sta. Lt Rt
89+10 x
Δ 12° 38' Lt
D 3°
R 1910.1
T 211.4
L 421.1
E 11.6
bank ½ per foot
SHELDON
FRANKLIN
TOWN LINE
WINSLOW BOWEN
meadow
PC 89+55
POT 94+50.0
In post 32.57
In post 34.48
NIT 93 E 94
TO FRANKLIN
24.75'
81 N 30° 12' E
Slope Rights
82+50 - 86+00 Rt
85+00
Construct rights
meadow
MRS GAY
meadow
12.74
BM # 12
S/R 24" Elm
Elev 667.20
PI 91+77.2
91+73.5
meadow
PROJECT MARKER
19.8' Rt
Sta 91+42
END PROJECT
S 52 (3)
construct satisfactory approach
675
665
+1.557%
-0.093%
-0.533%
+0.600%
-0.457%
+0.267%
82+50
150 VC
668.75
85+25
150 VC
669.40
87+75
150 VC
667.60
89+25
150 VC
668.00
91+00
100 VC
668.00
Sta 81+00 - Sta 91+42
15" Sub-base
665.2 665.7 666.4 666.9 667.2 667.2 667.4 667.5 667.5 667.4 667.2 667.1 666.7 666.5 666.4 666.6 666.9 667.1 667.2 667.0 666.9 667.0 667.1 667.4 667.7 668.4 669.9 669.4 670.0 670.8 671.4
81 +50 82 +50 83 +50 84 +50 85 +50 86 +06 +50 87 +07 +50 88 +50 89 +10 +50 90 +50 91 +50 92 +50 93 +50 94 +50 95
BM#11 24.5 ft. Lt Sta 84+47 S.I.R. 24" Maple Elevation 670.00
BM#12 24 ft. Rt. Sta 91+74 S.I.R. 24" Elm Elevation 667.20
SHELDON
Project S No. 52(3)
PLAN
PROFILE
NOTE BOOK
NO.
Hurley
Hurley
STILE
4