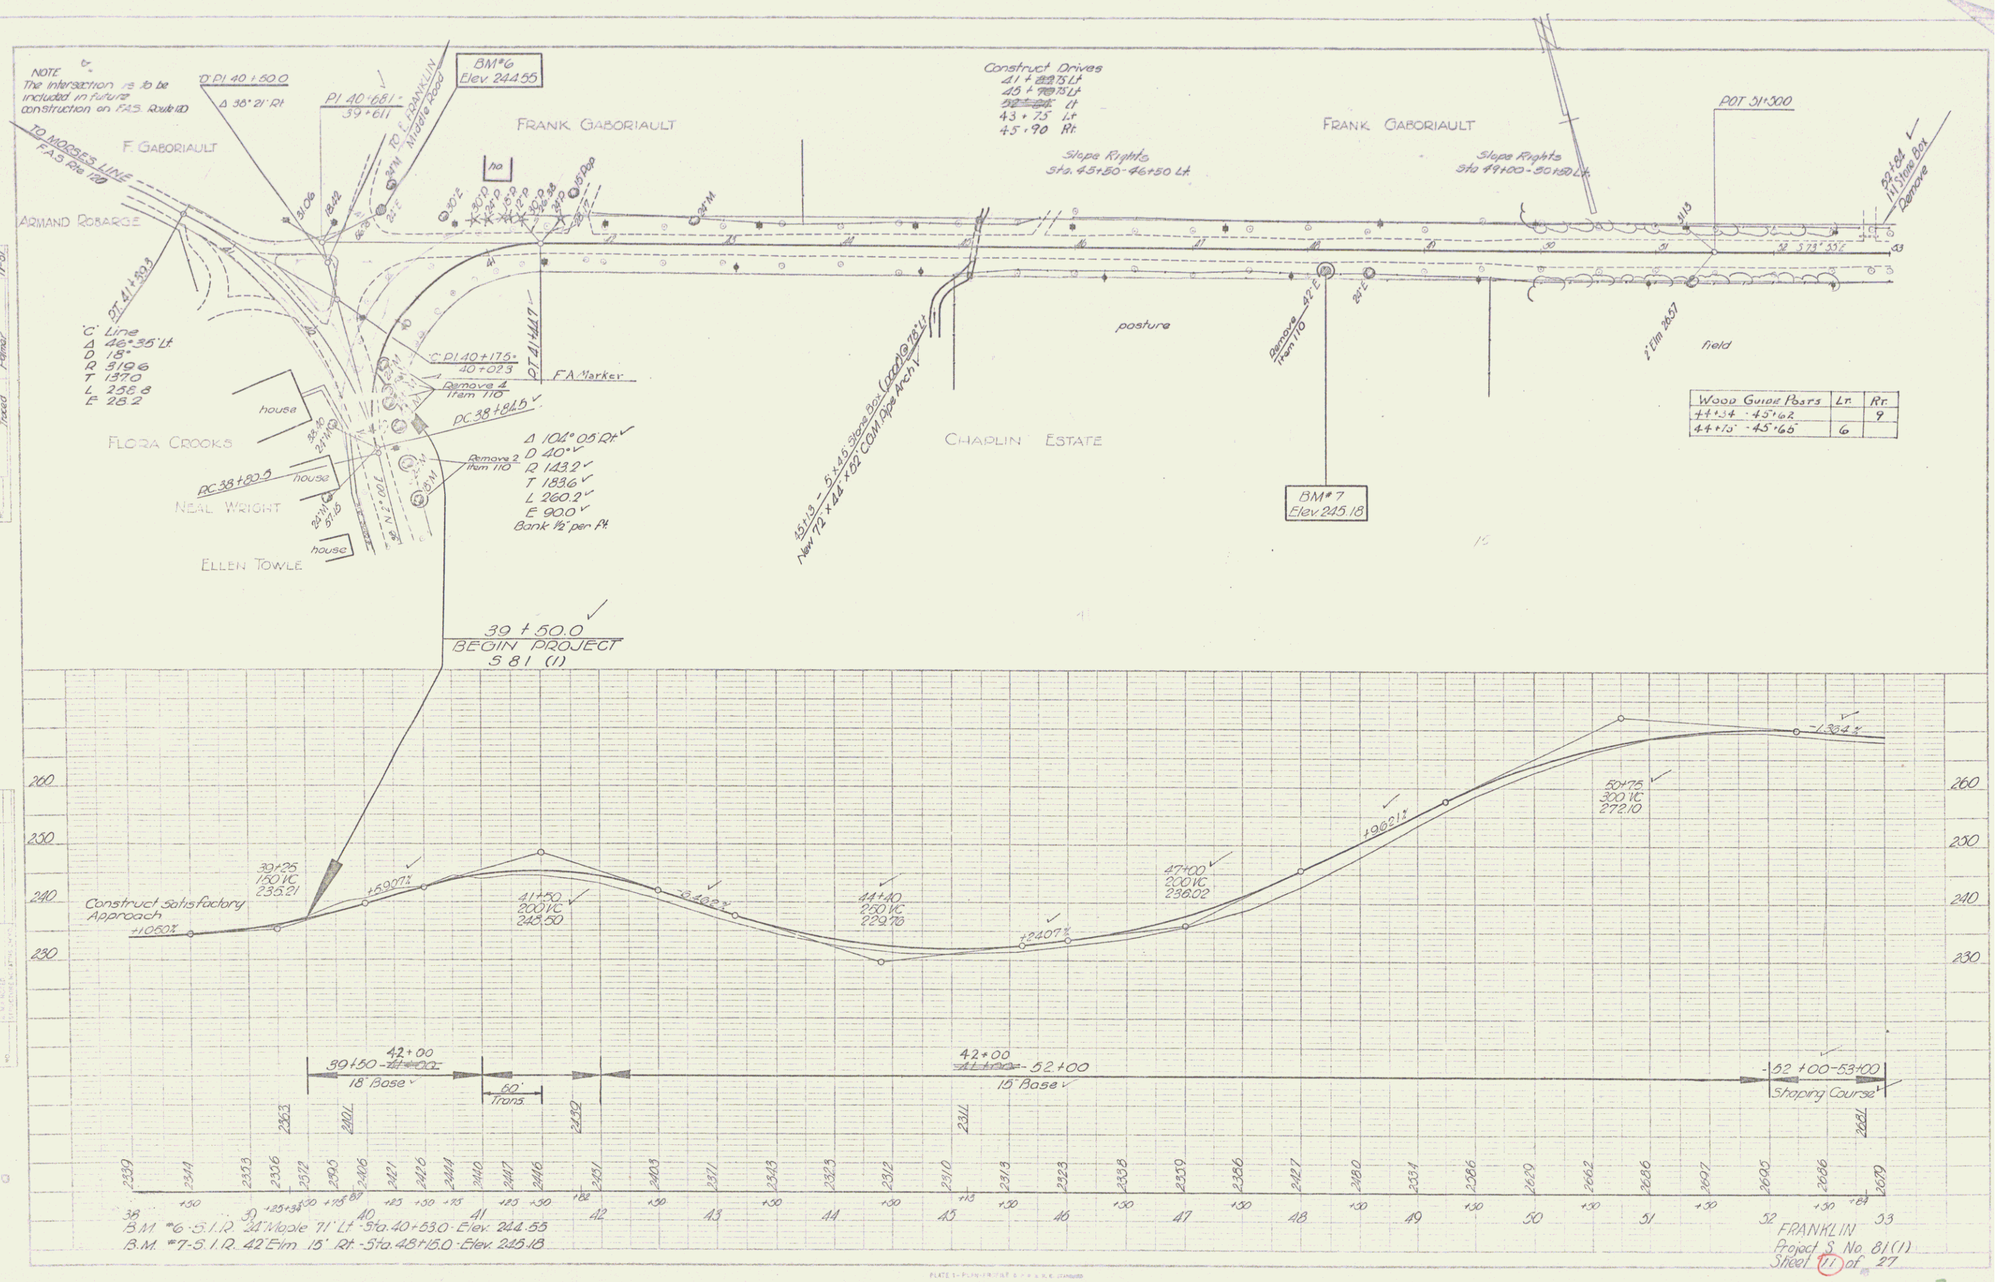

Wood Guide Posts	Lt.	Rt.
44+34 - 45'62		9
44+13 - 45'66	6	

3