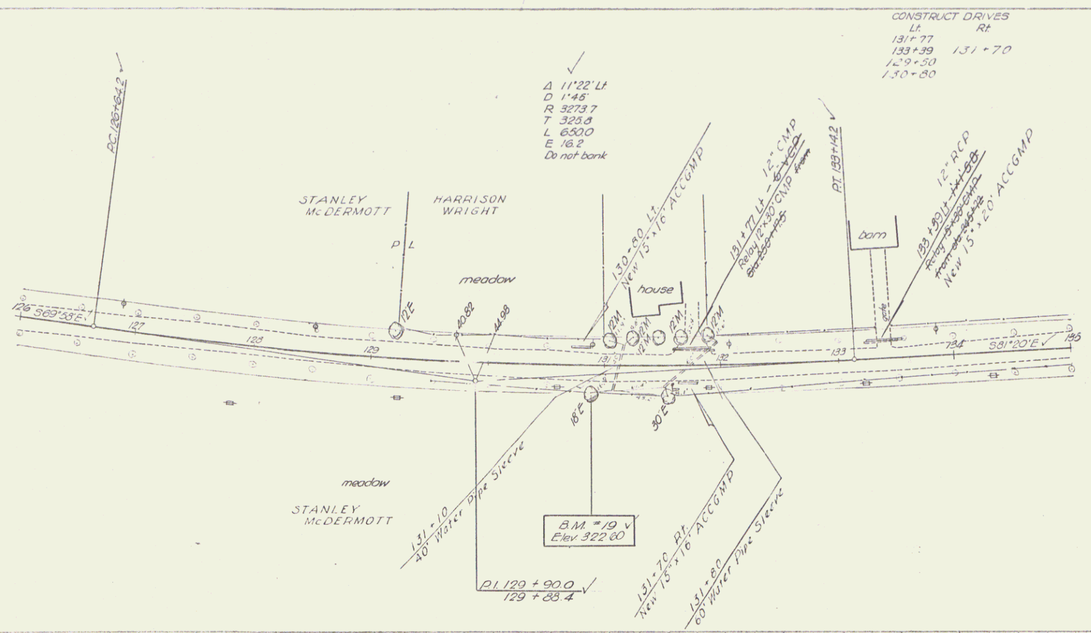

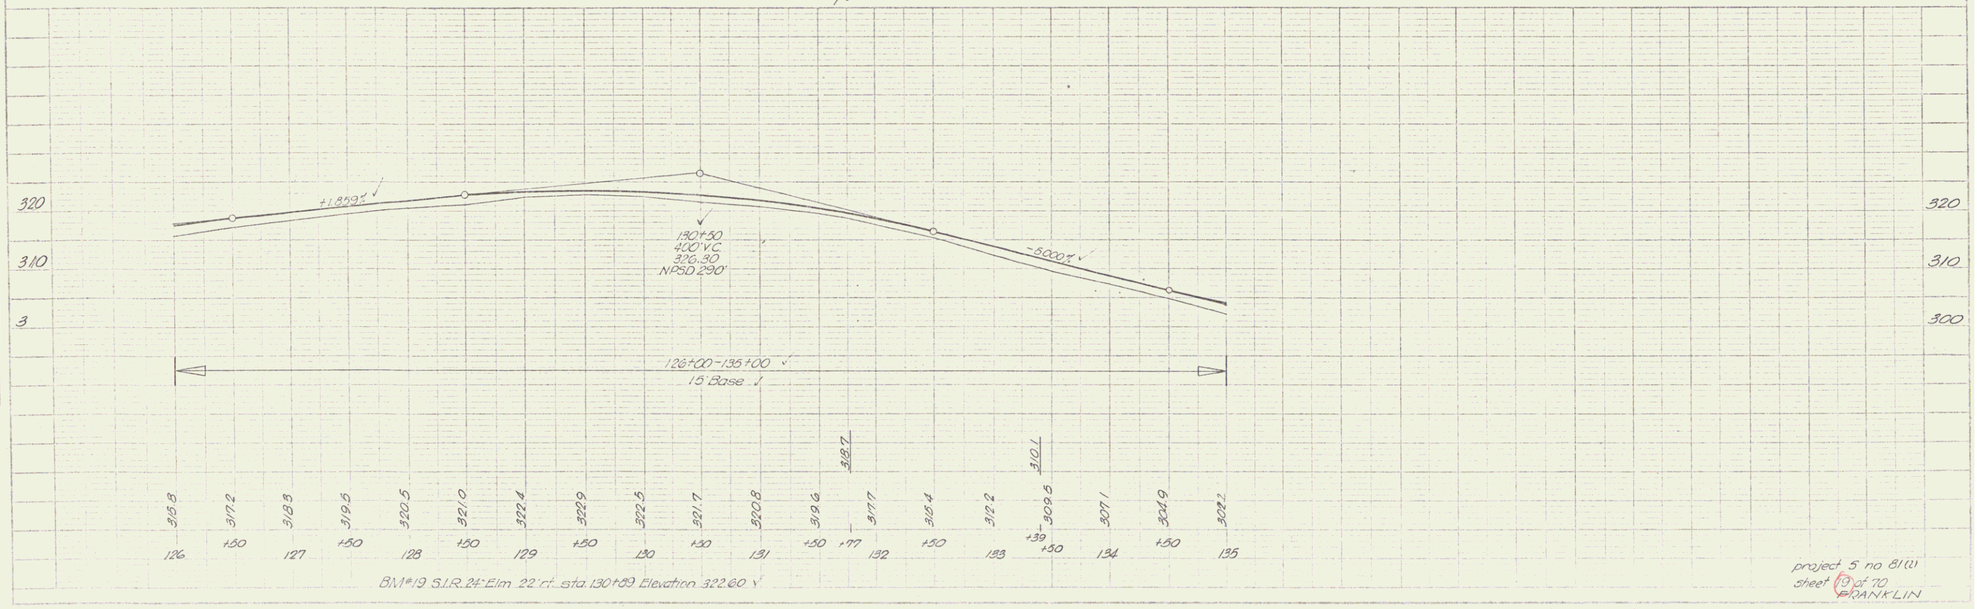

project 5 no 81(2)
sheet 19 of 70
FRANKLIN

5